


GR. ELEV. 980±
MAX. STATIC PRES. 78 PSI ±

SPADES ROAD

NOTE: USE 4 - 6" C.I.M.J. 45°
BENDS AT CREEK CROSSING
SEE DETAIL SHT. 24


GR. ELEV. 980±
MAX. STATIC PRES. 78 PSI ±

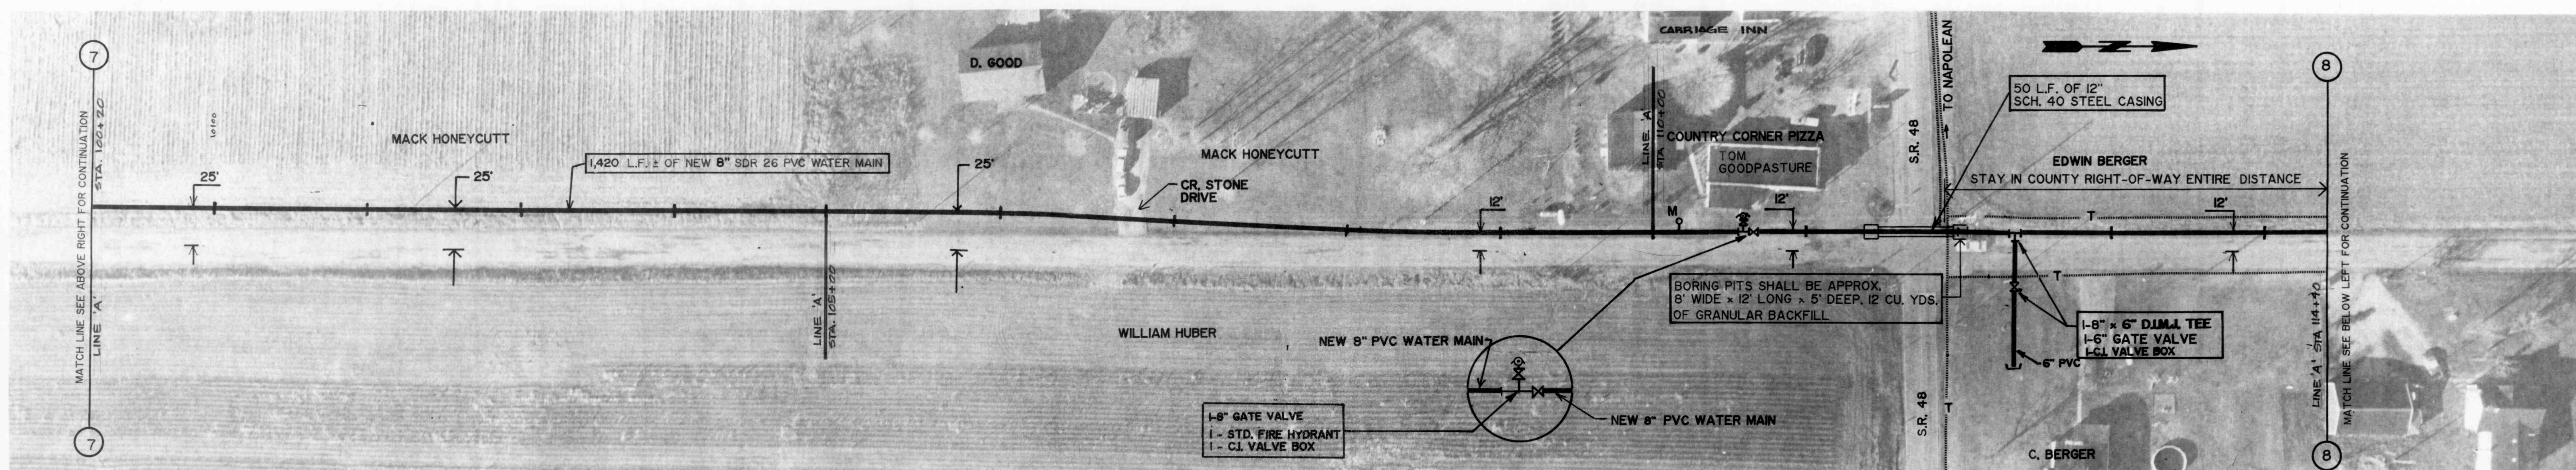

GR. ELEV. 980±
MAX. STATIC PRES. 78 PSI ±

SPADES ROAD

GR. ELEV. 984±
MAX. STATIC PRES. 78 PSI ±

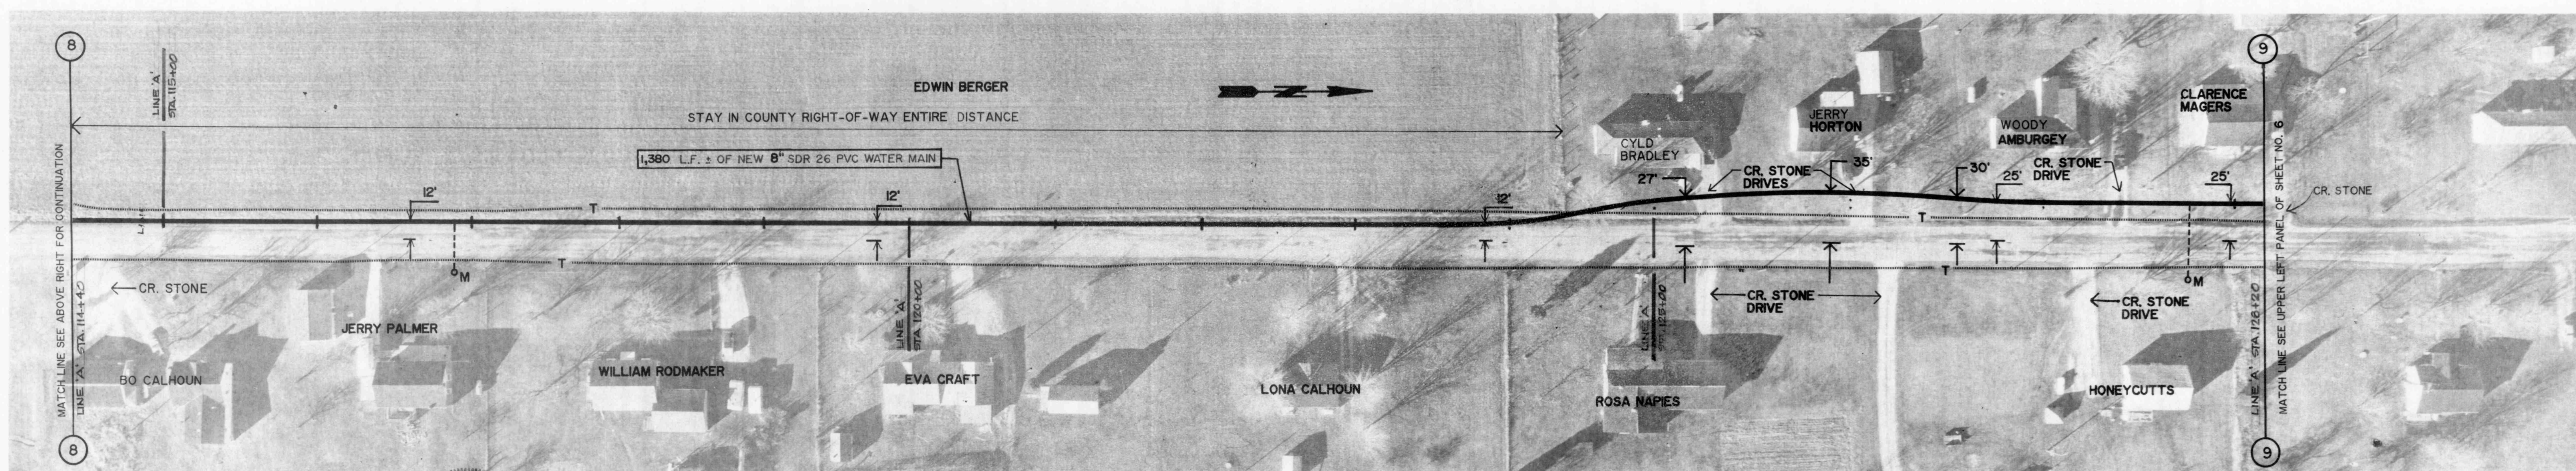

GR. ELEV. 980±
MAX. STATIC PRES. 78 PSI ±

SPADES ROAD

GR. ELEV. 990±
MAX. STATIC PRES. 74 PSI ±



DRAWN BY
DATE
CERTIFIED BY
DATE

ROBERT E. CURRY & ASSOCIATES, INC.
CONSULTING ENGINEERS
3346 AVON ROAD
PLAINFIELD, INDIANA 46168

ELROD WATER COMPANY, INC.
RIPLEY COUNTY, INDIANA

WATER MAIN EXTENSIONS
TO
COMMUNITIES OF
CLINTON, SPADES & MORRIS

AS BUILT 10-17-88

JOB NO. SHT. 5
SCALE 1" = 50' OF 24