


C. R. 700 NORTH (DOES NOT APPLY)



GROUND ELEV. = 930±
MAX STATIC PRESSURE = 100 PSI±

C. R. 700 NORTH

GROUND ELEV. = 940±
MAX STATIC PRESSURE = 95 PSI±

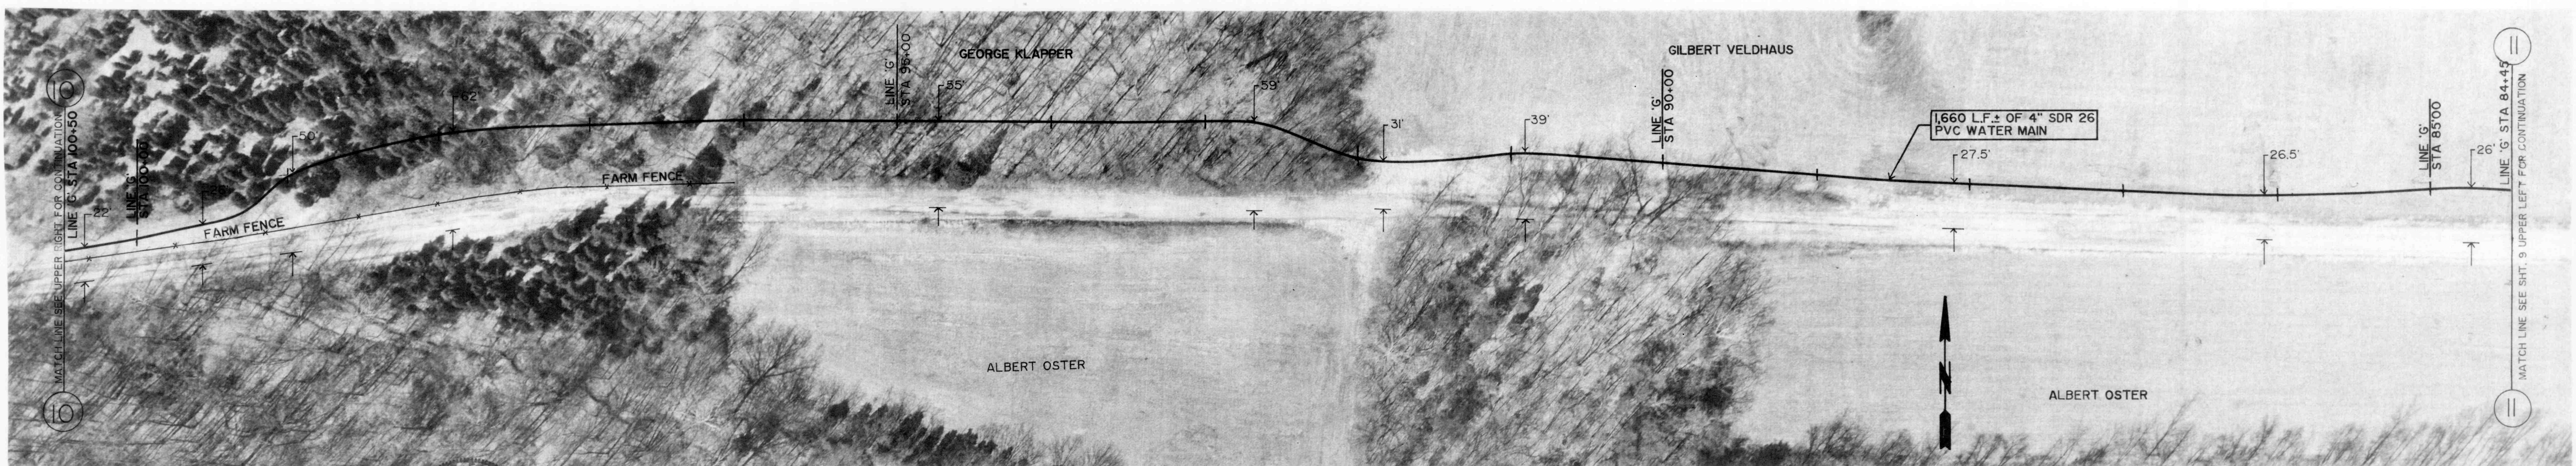

GROUND ELEV. = 940±
MAX STATIC PRESSURE = 95 PSI±

C. R. 700 NORTH

GROUND ELEV. = 990±
MAX STATIC PRESSURE = 74 PSI±



Robert E. Curry

REVISIONS

DRAWN BY	D.D.E.
DATE	7-17-89
CERTIFIED BY	ROBERT E. CURRY
DATE	7-17-89

ROBERT E. CURRY & ASSOCIATES, INC.
CONSULTING ENGINEERS

ELROD WATER COMPANY INC.
DIVISION "C" DISTRIBUTION SYSTEM EXTENSIONS

C. R. 700 NORTH
4" WATER MAIN

AS BUILT 10-17-90

JOB NO.	SHT.
8	8
SCALE	OF
1" = 50'	31