

460 LFT FILTER FABRIC FENCE REQ'D.
FOR SOIL EROSION CONTROL. SEE
DETAILS SHEET 18.

REMOVE TREES AND BRUSH
AS NECESSARY FOR GRADING

16 LFT OF 12" CMP


INV. ELEV. = 970.00
END SECTION REQUIRED

396' OF FARM FENCE
INSTALL ON TOP OF BANK
AT ELEVATION 972.00


EXIST. TREE LINE

LAGOON SITE PLAN
SCALE: 1" = 30'

N

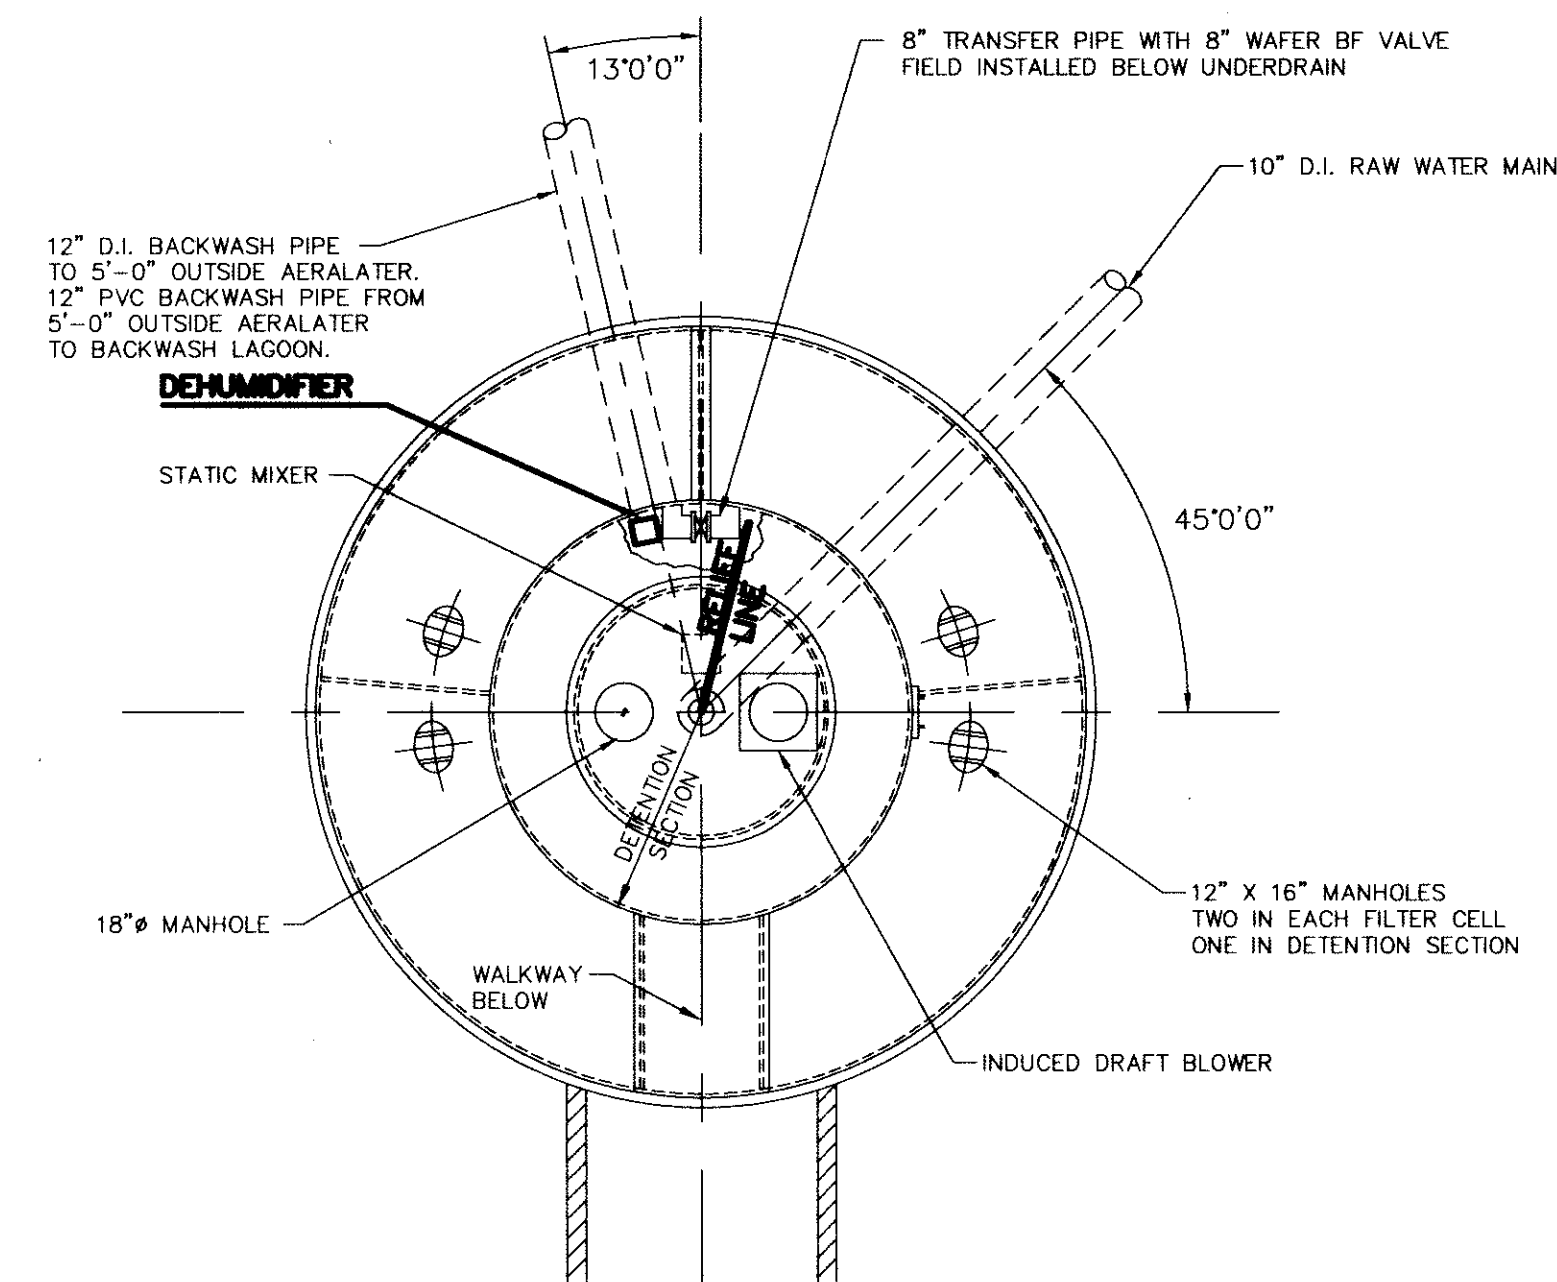

TYPICAL AERATER PLAN
NO SCALE

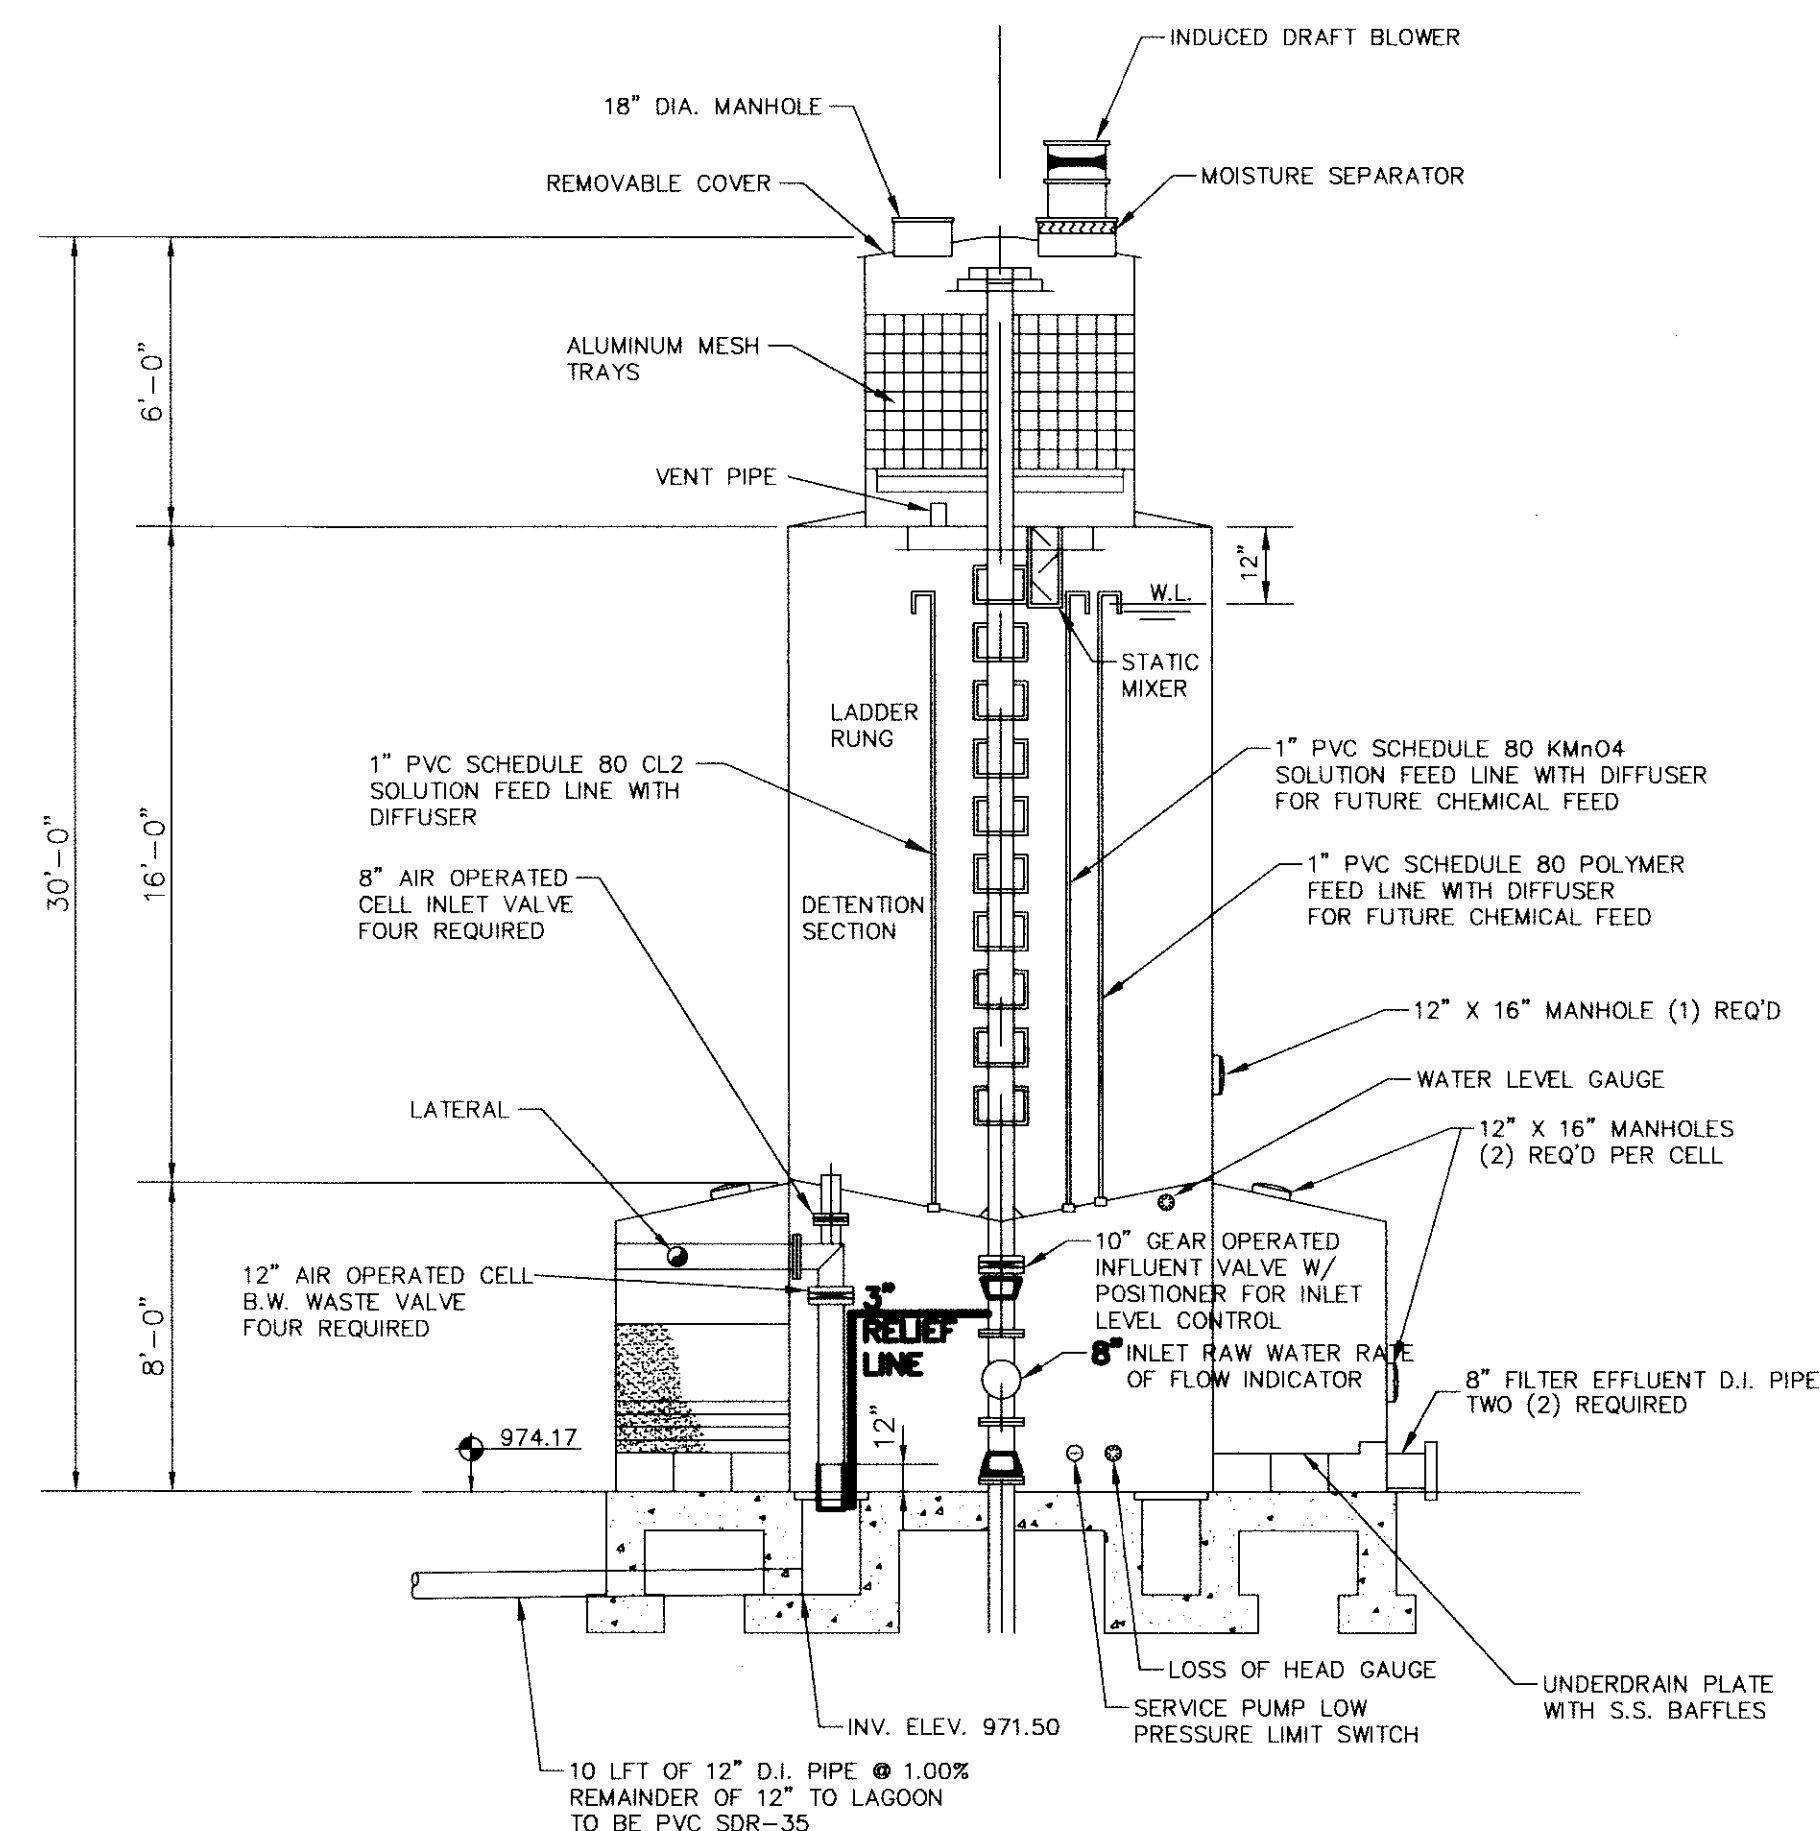

TYPICAL AERATER SECTION
NO SCALE

NOTE:
SEE SHEET 7 FOR FOUNDATION
PLAN, SECTIONS AND DETAILS.

RECORD DRAWINGS

THESE DRAWINGS HAVE BEEN PREPARED FROM
INFORMATION BY OTHERS. ENGINEER WILL NOT
BE RESPONSIBLE FOR ERRORS AND OMISSIONS
IN THE INFORMATION OR RECORDS FROM WHICH
THESE DRAWINGS ARE PRODUCED.


NO.	DATE	BY	REVISIONS
2.	11/18/96	CLG	RECORD DRAWINGS
1.	3/4/94	MAW	AERATER SIZE, LAGOON SIZE AND LOCATION

CONTRACT "B"
WELLS AND TREATMENT FACILITIES
LAGOON/AERATER DETAILS
ELROD WATER COMPANY, INC.
DIVISION "E"
WATERWORKS SYSTEM IMPROVEMENTS

WESSLER and ASSOCIATES
CONSULTING ENGINEERS
6219 South East Street, Suite A
Indianapolis, Indiana 46227-2148

SCALE:	AS SHOWN
DATE:	OCT. 14, 1993
PROJECT NO.:	37391.04
DRAWN BY:	M.A.W.
APPROVED BY:	D.G.C.
PLOTTED:	4/12/94
CAD FILE:	373-B9.DWG

NOT PUBLISHED
ALL RIGHTS RESERVED
EXCEPT FOR USES EXPRESSLY
PERMITTED IN WRITING, INFOR-
MATION SHOWN OR INCLUDED
IN THIS DOCUMENT IS SOLELY
THE PROPERTY OF M.D.
WESSLER & ASSOCIATES, INC.

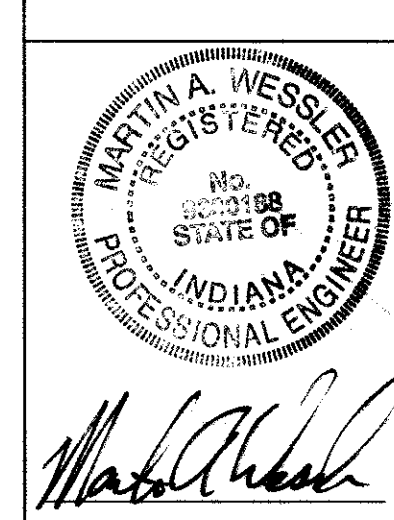

SHEET B9
OF 19