
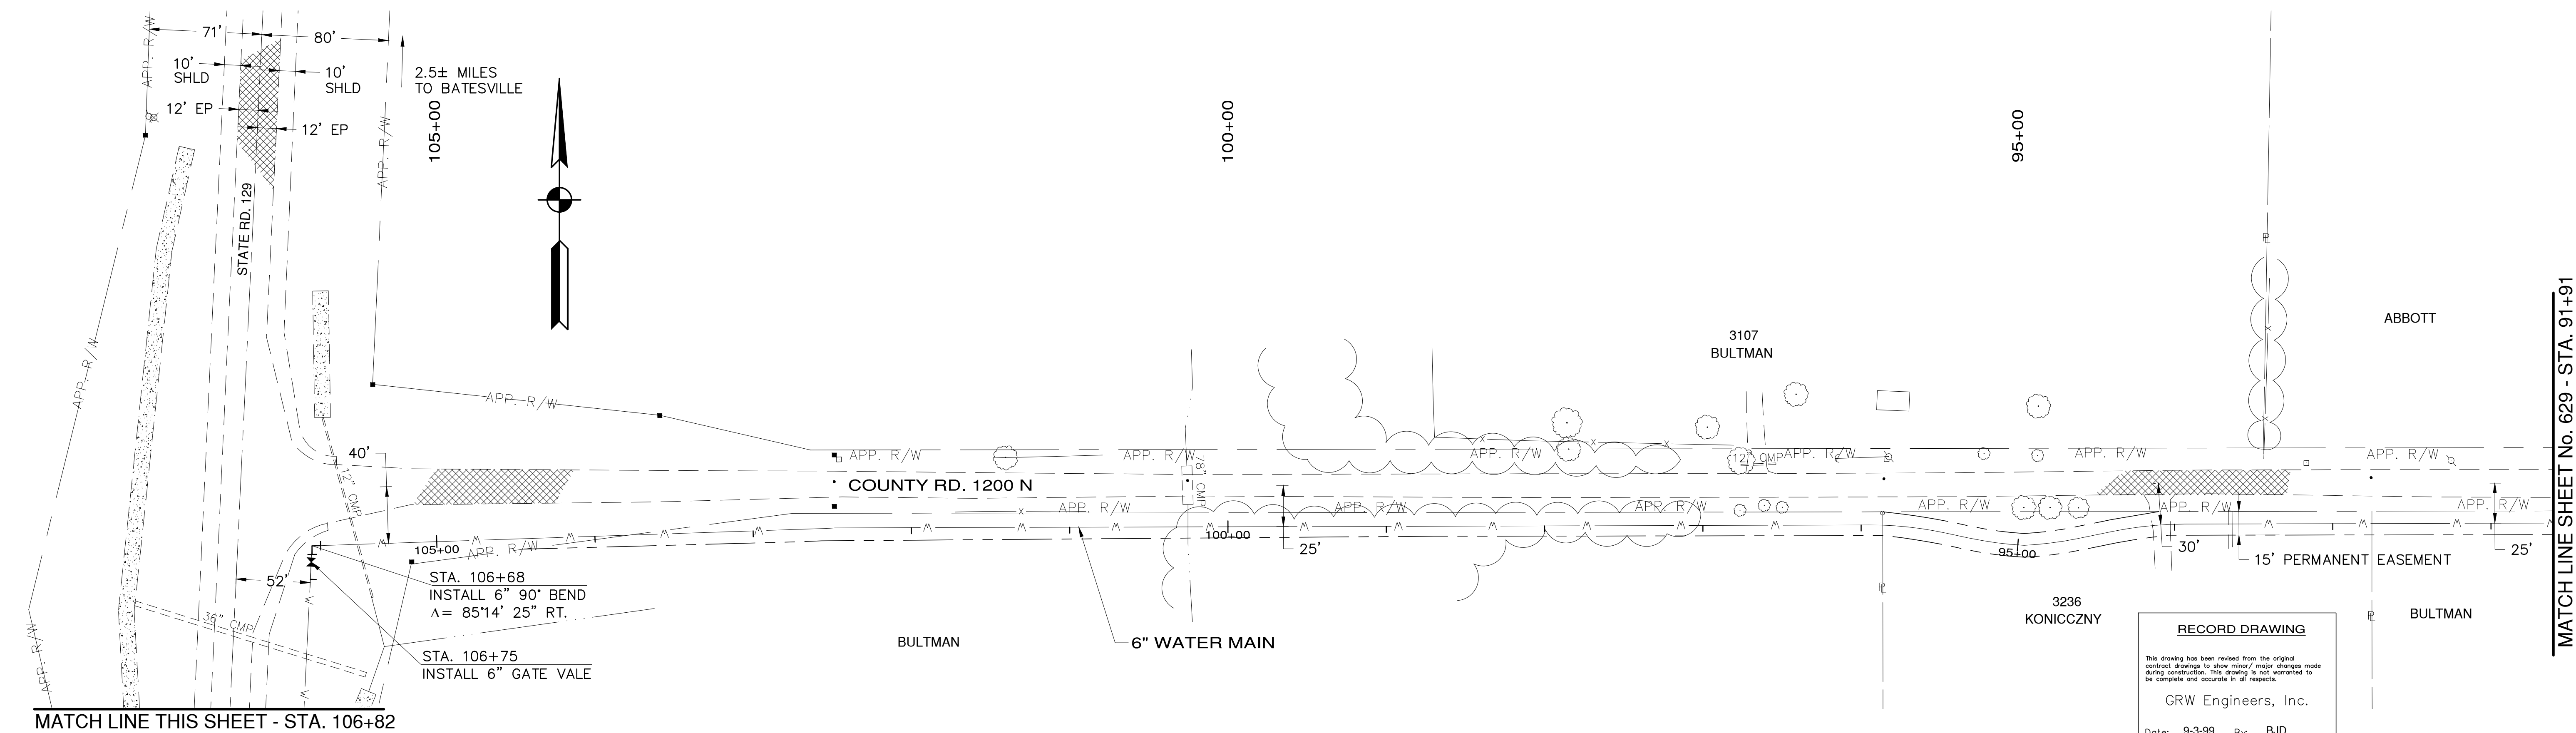


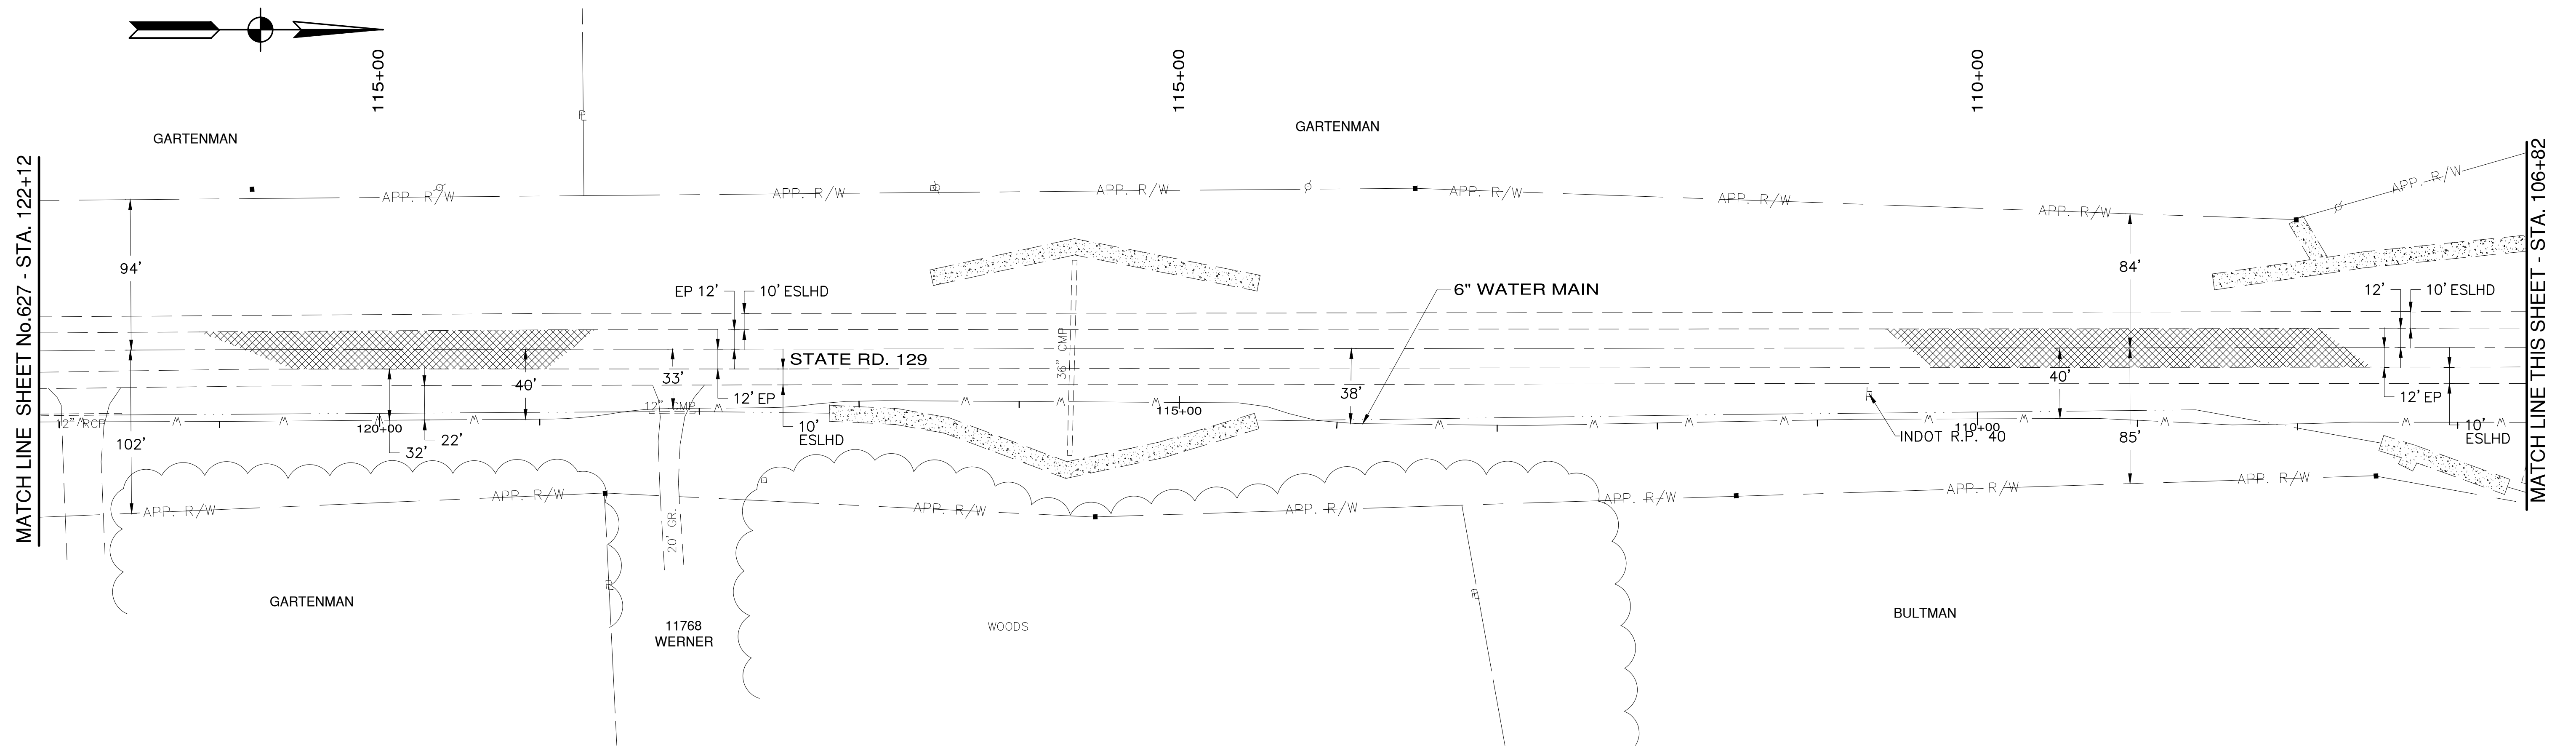


NO.	DESCRIPTION	DATE	BY
2	RENUMBERED	6-03	GCR
1	AS-BUILT	9-99	BD
REVISIONS			

HOOSIER HILLS REGIONAL
WATER DISTRICT

NEAL SUBDIVISION WATER MAIN EXTENTION

GRW PROJECT NO. 2543-13

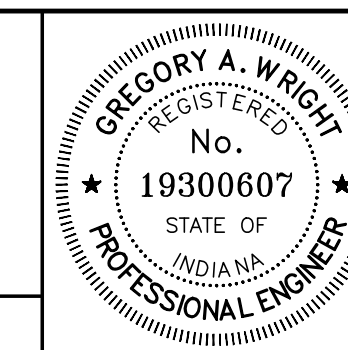

DRAWN: BJD	DATE: APRIL 1999
FILE NAME: SHT628.DWG	SCALE: 1"=50'
CHECKED: -	SHEET NO. 628
APPROVED: -	