



MATCH LINE SHEET No. 629 - STA. 60+90

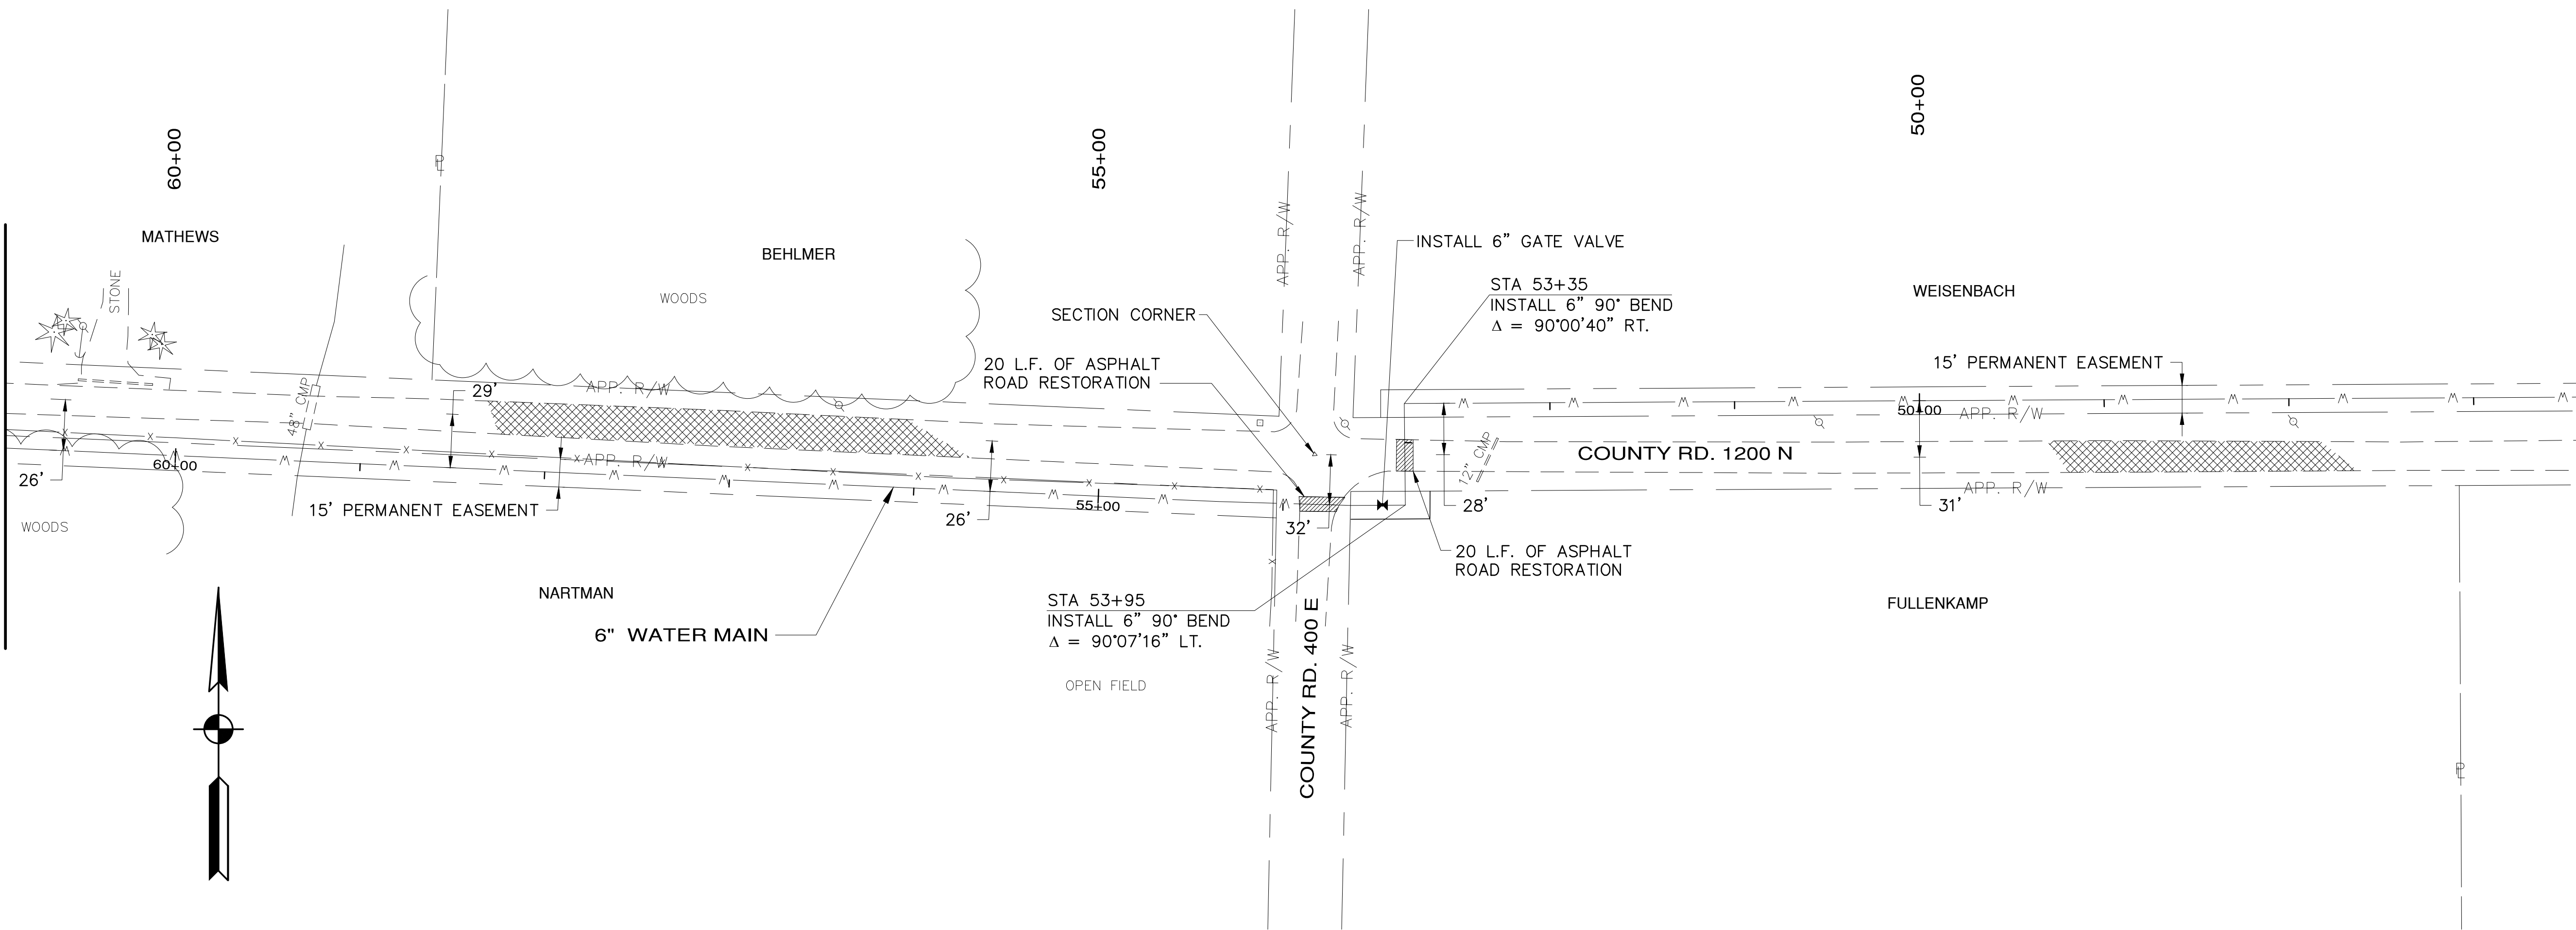

MATCH LINE THIS SHEET - STA. 46+37

MATCH LINE THIS SHEET - STA. 46+37

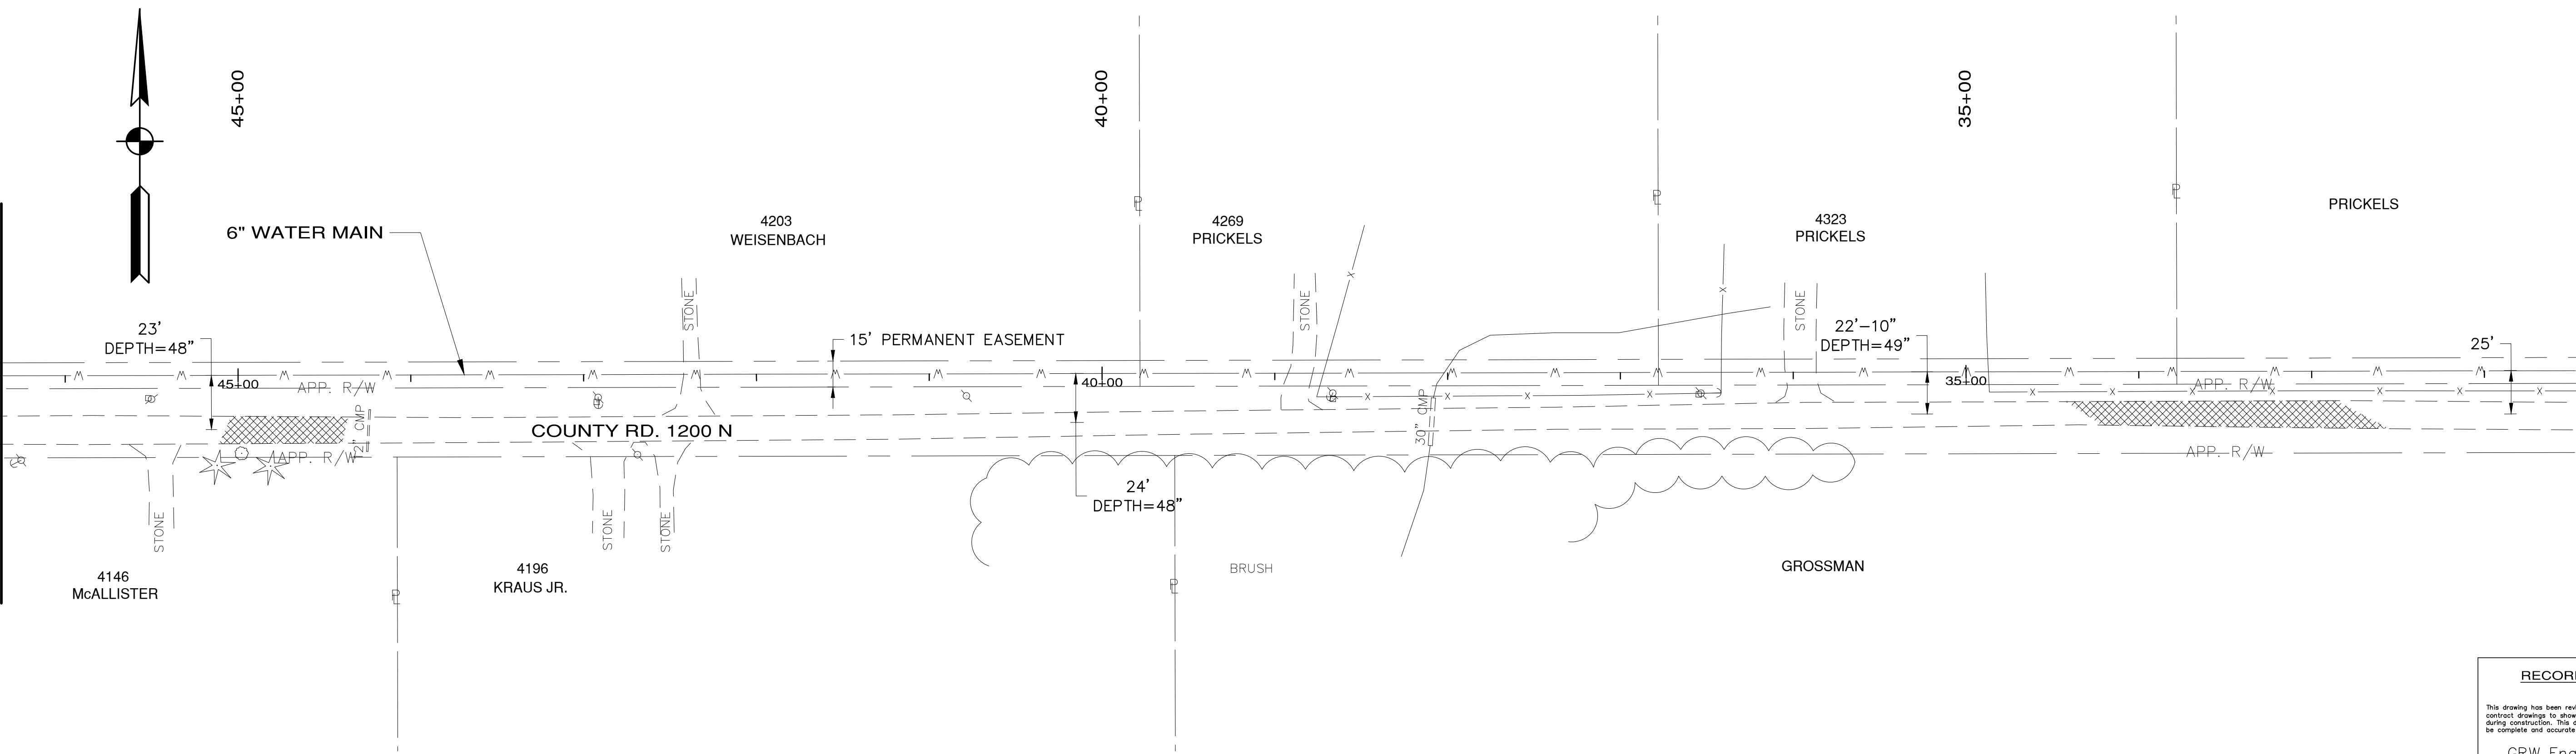

MATCH LINE SHEET No. 631 - STA. 31+37

RECORD DRAWING

This drawing has been revised from the original contract drawings to show minor / major changes made during construction. This drawing is not warranted to be complete and accurate in all respects.

GRW Engineers, Inc.


Date: 9-3-99 By: BJD

NO.	DESCRIPTION	DATE	BY
2	RENUMBERED	6-03	GCR
1	AS-BUILT	9-99	BD

HOOSIER HILLS REGIONAL
WATER DISTRICT

NEAL SUBDIVISION WATER MAIN EXTENTION

GRW PROJECT NO. 2543-13

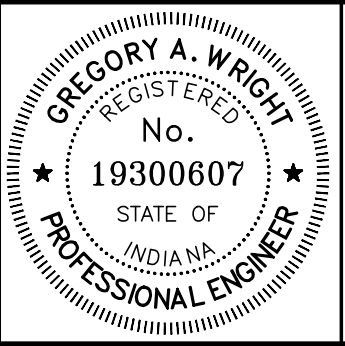


GRW Engineers, Inc.
Engineers, Architects, Planners
INDIANAPOLIS, INDIANA
LOUISVILLE & LEXINGTON, KENTUCKY
CINCINNATI, OHIO
NASHVILLE, TENNESSEE
ARLINGTON, TEXAS

DRAWN: BJD	DATE: APRIL 1998
FILE NAME: SHT630.DWG	SCALE: 1"=50'
CHECKED: -	SHEET NO. 630
APPROVED: -	