

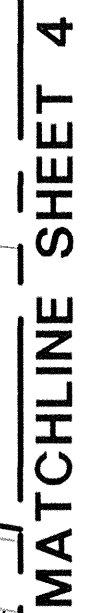
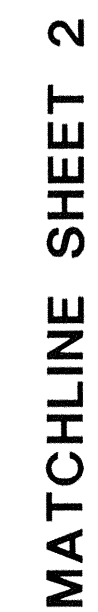
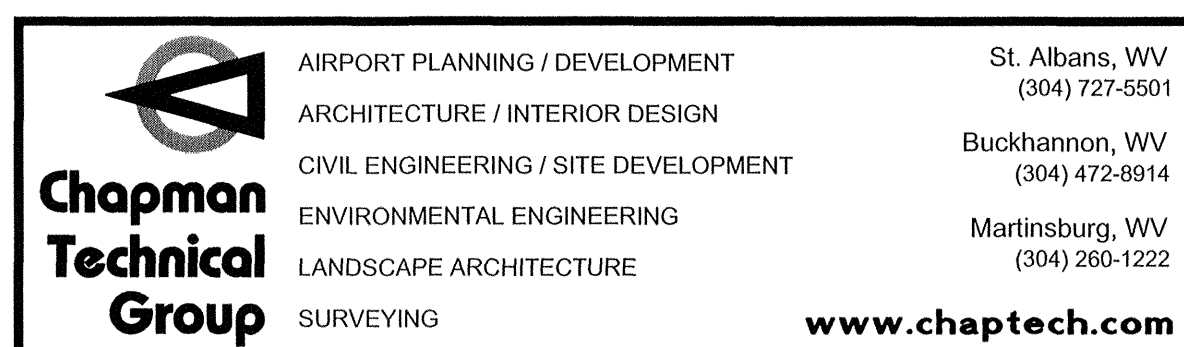
LEGEND	
	EXISTING WATERLINE TO BE ABANDONED-IN-PLACE
	PROPERTY LINE
	NEW WATERLINE
	EXIST. WATERLINE TO REMAIN

RECORD DRAWINGS

These Record Drawings have been prepared based on information provided by others. While this information is believed reliable, Chapman Technical Group, Ltd. cannot assure the accuracy, and/or completeness of this information, and thus shall not be responsible for any errors or omissions which may be incorporated herein as a result. Those relying on this record drawing document are advised to obtain independent verification of its accuracy before applying it for any purpose.

March, 2014

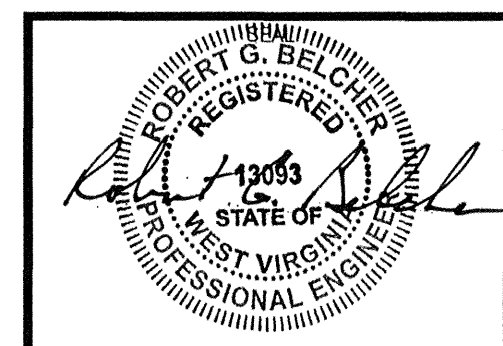
March, 2014

[illegible]

PROJECT INFORMATION

**ST. ALBANS MUNICIPAL UTILITY COMMISSION
ST. ALBANS, WEST VIRGINIA
WATER SYSTEM IMPROVEMENTS
CONTRACT NO. 4 - DISTRIBUTION SYSTEM**

PLAN SHEET



JOB NUMBER:	08053	
SCALE:	1" = 50'	
DATE:	JUNE 2010	
DRAWN BY:	FLB	
DESIGNED BY:	KTC	
CHECKED BY:	RGB	
SHEET NO.		REVISION
3		