


RECORD DRAWINGS
These Record Drawings have been prepared based on information provided by others. While this information is believed reliable, Chapman Technical Group, Ltd. cannot assure the accuracy, and/or completeness of this information, and thus shall not be responsible for any errors or omissions which may be incorporated herein as a result. Those relying on this record drawing document are advised to obtain independent verification of its accuracy before applying it for any purpose.
March, 2014

LEGEND	
---	EXISTING WATERLINE TO BE ABANDONED-IN-PLACE
---	PROPERTY LINE
---	NEW WATERLINE
---	EXIST. WATERLINE TO REMAIN

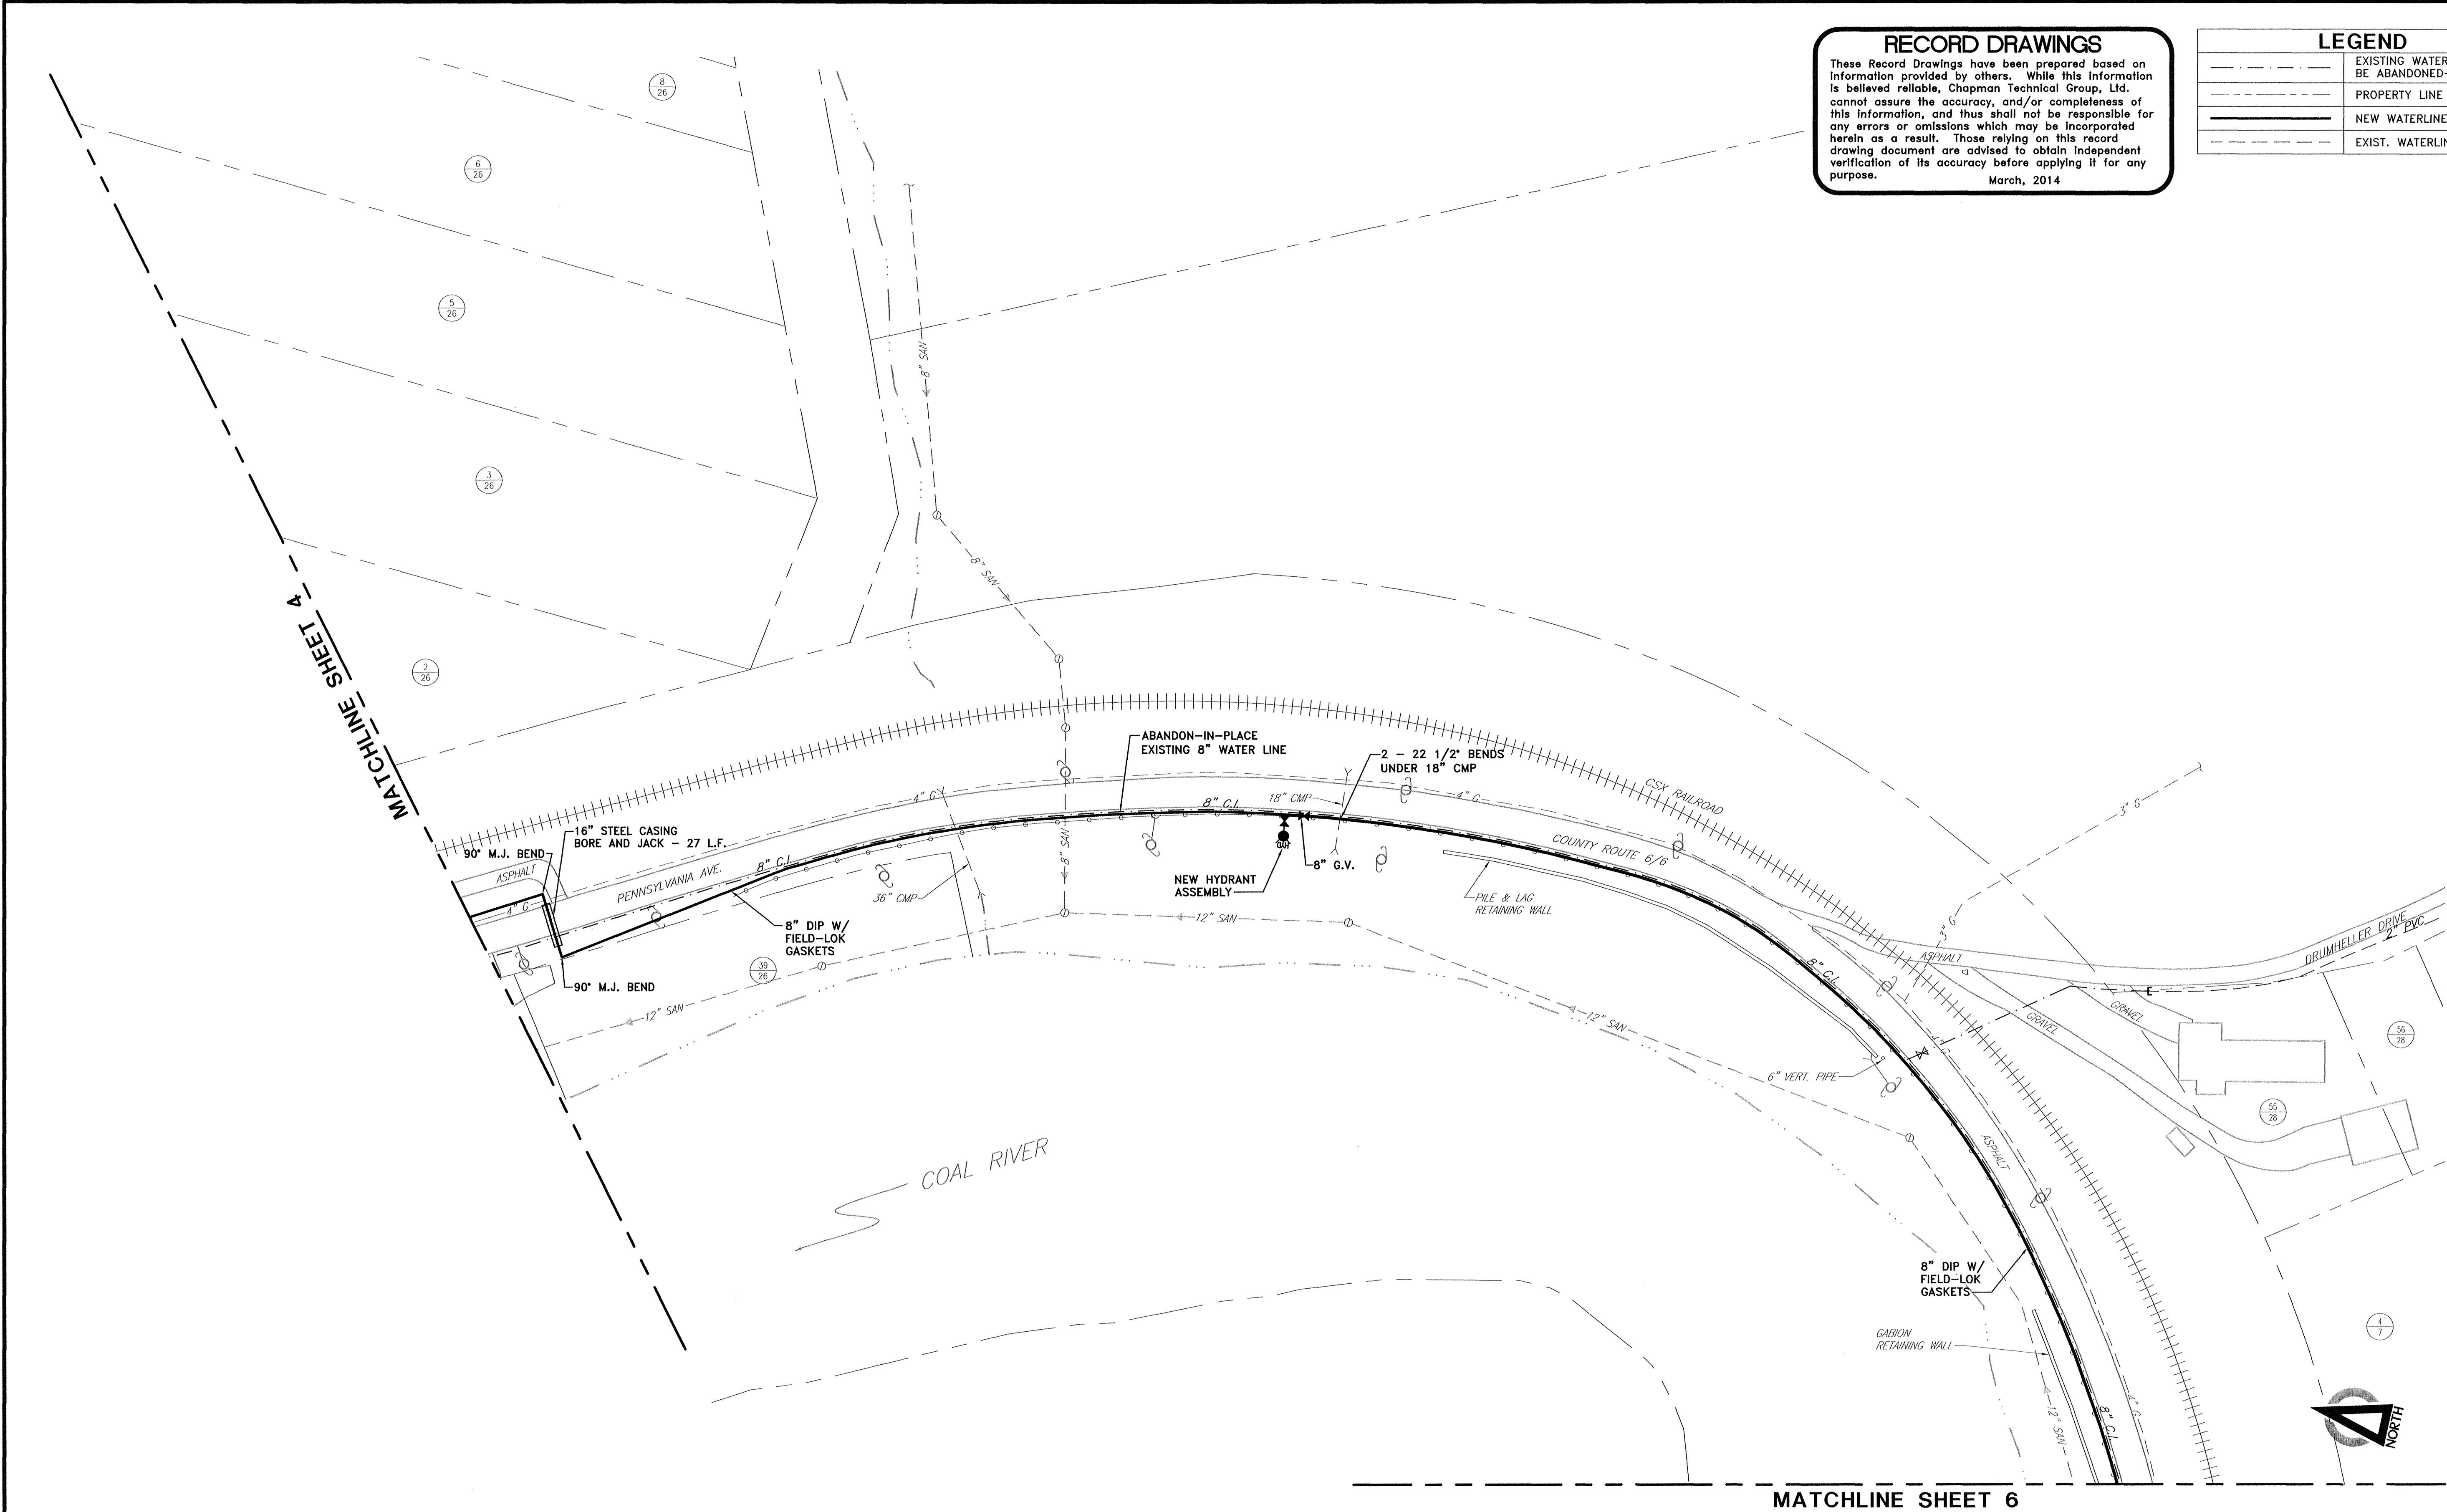

REVISION NUMBER	REVISIONS	DATE	BY



AIRPORT PLANNING / DEVELOPMENT
ARCHITECTURE / INTERIOR DESIGN
CIVIL ENGINEERING / SITE DEVELOPMENT
ENVIRONMENTAL ENGINEERING
LANDSCAPE ARCHITECTURE
SURVEYING

St. Albans, WV
(304) 727-5501
Buckhannon, WV
(304) 472-8914
Martinsburg, WV
(304) 260-1222

www.chaptech.com

PROJECT INFORMATION

ST. ALBANS MUNICIPAL UTILITY COMMISSION
ST. ALBANS, WEST VIRGINIA
WATER SYSTEM IMPROVEMENTS
CONTRACT NO. 4 - DISTRIBUTION SYSTEM

PLAN SHEET



JOB NUMBER:	08053
SCALE:	1" = 50'
DATE:	JUNE 2010
DRAWN BY:	FLB
DESIGNED BY:	KTC
CHECKED BY:	RGB
SHEET NO.	5
REVISION	