



SCALE: 

[illegible]



**Chapman
Technical
Group**

AIRPORT PLANNING / DEVELOPMENT
ARCHITECTURE / INTERIOR DESIGN
CIVIL ENGINEERING / SITE DEVELOPMENT
ENVIRONMENTAL ENGINEERING
LANDSCAPE ARCHITECTURE
SURVEYING

St. Albans, WV
(304) 727-5501

Buckhannon, WV
(304) 472-8914


Martinsburg, WV
(304) 260-1222

www.chaptech.com

PROJECT INFORMATION

**ST. ALBANS MUNICIPAL UTILITY COMMISSION
ST. ALBANS, WEST VIRGINIA
WATER SYSTEM IMPROVEMENTS
CONTRACT NO. 1 - DISTRIBUTION SYSTEM**

PLAN SHEET

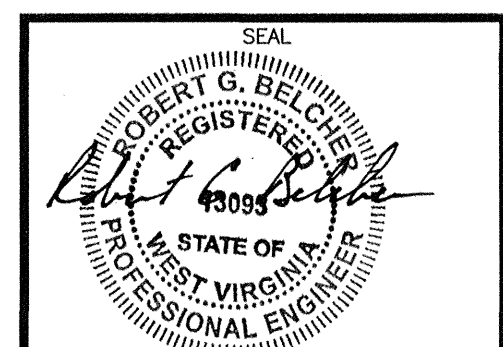

JOB NUMBER:	08053
SCALE:	1" = 20'
DATE:	MAY 2010
DRAWN BY:	FLB
DESIGNED BY:	KTC
CHECKED BY:	RGB
SHEET NO. 6	
REVISION 	