



RECORD DRAWINGS

These Record Drawings have been prepared based on information provided by others. While this information is believed reliable, Chapman Technical Group, Ltd. cannot assure the accuracy, and/or completeness of this information, and thus shall not be responsible for any errors or omissions which may be incorporated herein as a result. Those relying on this record drawing document are advised to obtain independent verification of its accuracy before applying it for any purpose.

FEBRUARY 2012



SCALE: 0 10 20

REVISION NUMBER	REVISIONS	DATE	BY



**Chapman
Technical
Group**

AIRPORT PLANNING / DEVELOPMENT
ARCHITECTURE / INTERIOR DESIGN
CIVIL ENGINEERING / SITE DEVELOPMENT
ENVIRONMENTAL ENGINEERING
LANDSCAPE ARCHITECTURE
SURVEYING


St. Albans, WV (304) 727-5901
Buckhannon, WV (304) 472-8914
Martinsburg, WV (304) 260-1222

www.chaptech.com

PROJECT INFORMATION

ST. ALBANS MUNICIPAL UTILITY COMMISSION
ST. ALBANS, WEST VIRGINIA
WATER SYSTEM IMPROVEMENTS
CONTRACT NO. 1 - DISTRIBUTION SYSTEM

PLAN SHEET

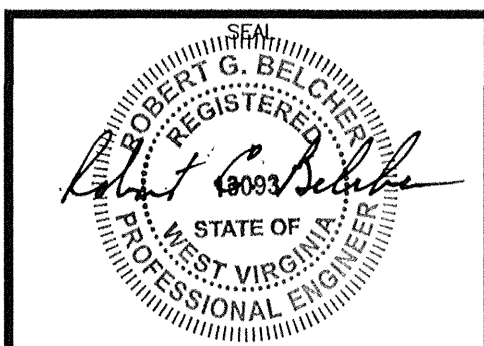

JOB NUMBER:	08053
SCALE:	1" = 20'
DATE:	MAY 2010
DRAWN BY:	FLB
DESIGNED BY:	KTC
CHECKED BY:	RGB
SHEET NO.	7
REVISION	