



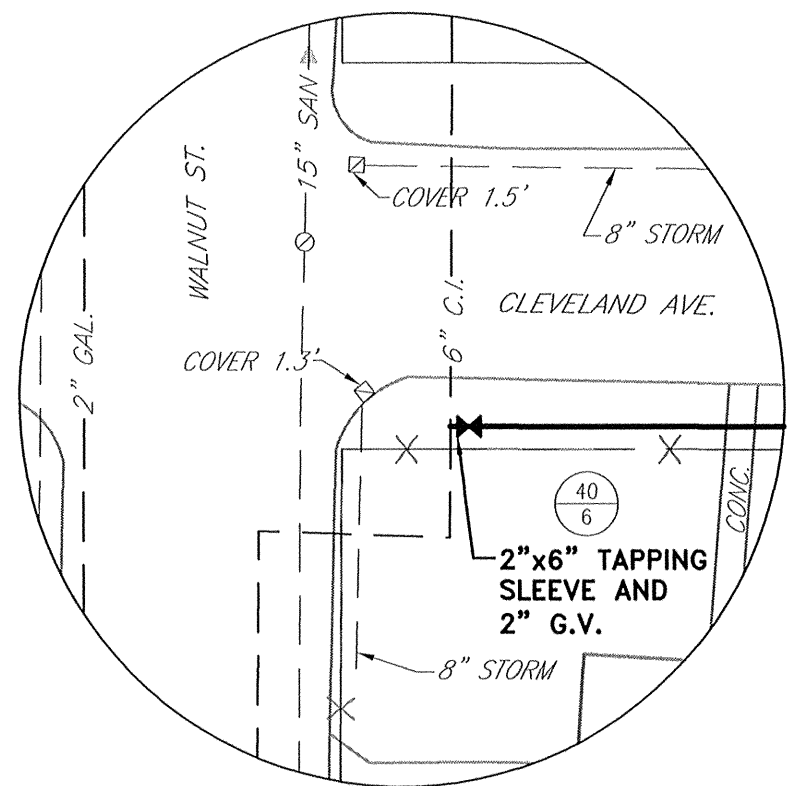

CONNECTION NO. 1-A
SCALE: 1" = 20'

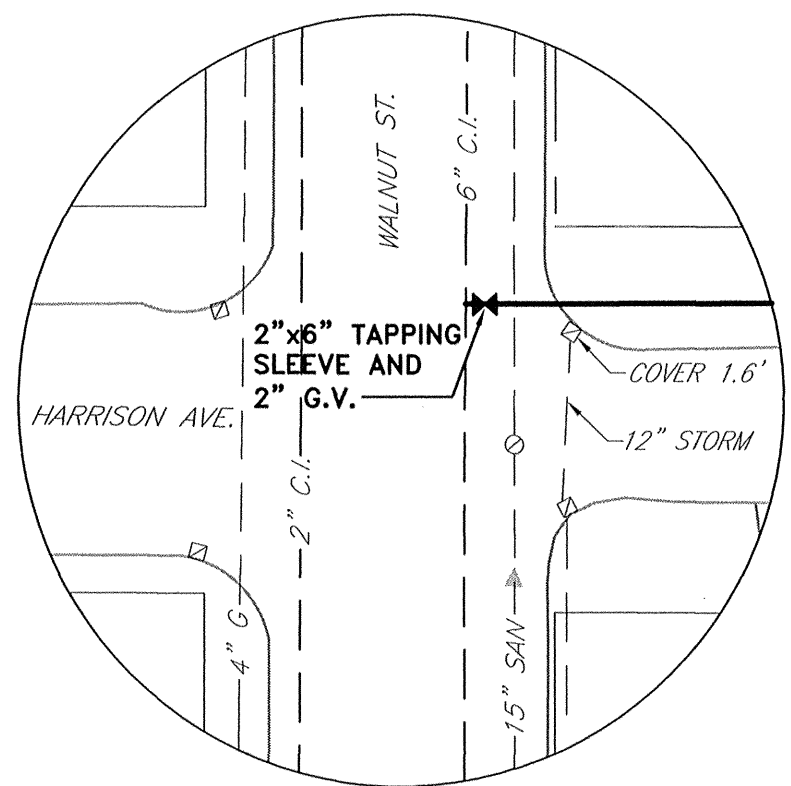

CONNECTION NO. 1-B
SCALE: 1" = 20'

RECORD DRAWINGS

These Record Drawings have been prepared based on information provided by others. While this information is believed reliable, Chapman Technical Group, Ltd. cannot assure the accuracy, and/or completeness of this information, and thus shall not be responsible for any errors or omissions which may be incorporated herein as a result. Those relying on this record drawing document are advised to obtain independent verification of its accuracy before applying it for any purpose.

FEBRUARY 2012



REVISION NUMBER	REVISIONS	DATE	BY
1	MOVED METERS CLOSER TO CLEVELAND AVE. ADD 2 WM AT WALNUT	1/11/11	MJC
2	ADD NOTE ABOUT TREE REMOVAL MOVED WM LOCATIONS		
3	ON TAX MAP 6 PARCEL 28, 32, 33, 36, 87 & 90		



Chapman Technical Group

AIRPORT PLANNING / DEVELOPMENT
ARCHITECTURE / INTERIOR DESIGN
CIVIL ENGINEERING / SITE DEVELOPMENT
ENVIRONMENTAL ENGINEERING
LANDSCAPE ARCHITECTURE
SURVEYING


St. Albans, WV (304) 727-5501
Buckhannon, WV (304) 472-8914
Martinsburg, WV (304) 260-1222

www.chaptech.com

PROJECT INFORMATION

ST. ALBANS MUNICIPAL UTILITY COMMISSION
ST. ALBANS, WEST VIRGINIA
WATER SYSTEM IMPROVEMENTS
CONTRACT NO. 1 - DISTRIBUTION SYSTEM

PLAN SHEET

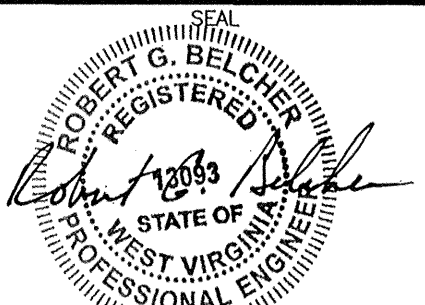

JOB NUMBER:	08053
SCALE:	1" = 50'
DATE:	MAY 2010
DRAWN BY:	FLB
DESIGNED BY:	KTC
CHECKED BY:	RGB
SHEET NO.	10
REVISION	