

RECORD DRAWINGS

These Record Drawings have been prepared based on information provided by others. While this information is believed reliable, Chapman Technical Group, Ltd., cannot assure the accuracy, and/or completeness of this information, and thus shall not be responsible for any errors or omissions which may be incorporated herein as a result. Those relying on this record drawing document are advised to obtain independent verification of its accuracy before applying it for any purpose.

LEGEND	
	EXISTING WATERLINE TO BE ABANDONED--IN-PLACE
	PROPERTY LINE
	NEW WATERLINE
	EXIST. WATERLINE TO REMAIN



SCALE: 0 25 50

[illegible]

- AIRPORT PLANNING / DEVELOPMENT
- ARCHITECTURE / INTERIOR DESIGN
- CIVIL ENGINEERING / SITE DEVELOPMENT
- ENVIRONMENTAL ENGINEERING
- LANDSCAPE ARCHITECTURE
- SURVEYING

St. Albans, WV
(304) 727-5501

Buckhannon, WV
(304) 472-8914


Martinsburg, WV
(304) 260-1222

www.chaptech.com

PROJECT INFORMATION

**ST. ALBANS MUNICIPAL UTILITY COMMISSION
ST. ALBANS, WEST VIRGINIA
WATER SYSTEM IMPROVEMENTS
CONTRACT NO. 1A - DISTRIBUTION SYSTEM**

PLAN SHEET

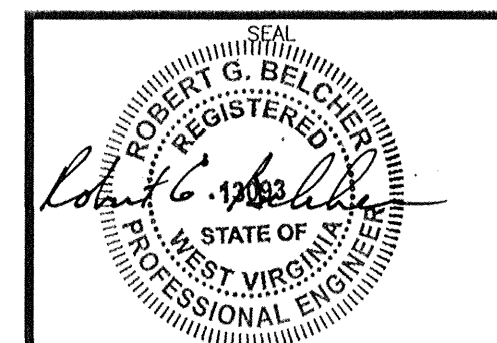

JOB NUMBER:	08053	
SCALE:	1" = 50'	
DATE:	JUNE 2012	
DRAWN BY:	FLB	
DESIGNED BY:	KTC	
CHECKED BY:	RGB	
SHEET NO.		REVISION
12		