

RECORD DRAWINGS


These Record Drawings have been prepared based on information provided by others. While this information is believed reliable, Chapman Technical Group, Ltd. cannot assure the accuracy, and/or completeness of this information, and thus shall not be responsible for any errors or omissions which may be incorporated herein as a result. Those relying on this record drawing document are advised to obtain independent verification of its accuracy before applying it for any purpose.

JANUARY 2013

KANAWHA RIVER

MATCHLINE SHEET NO. 12

LEGEND	
---	EXISTING WATERLINE TO BE ABANDONED-IN-PLACE
---	PROPERTY LINE
---	NEW WATERLINE
---	EXIST. WATERLINE TO REMAIN

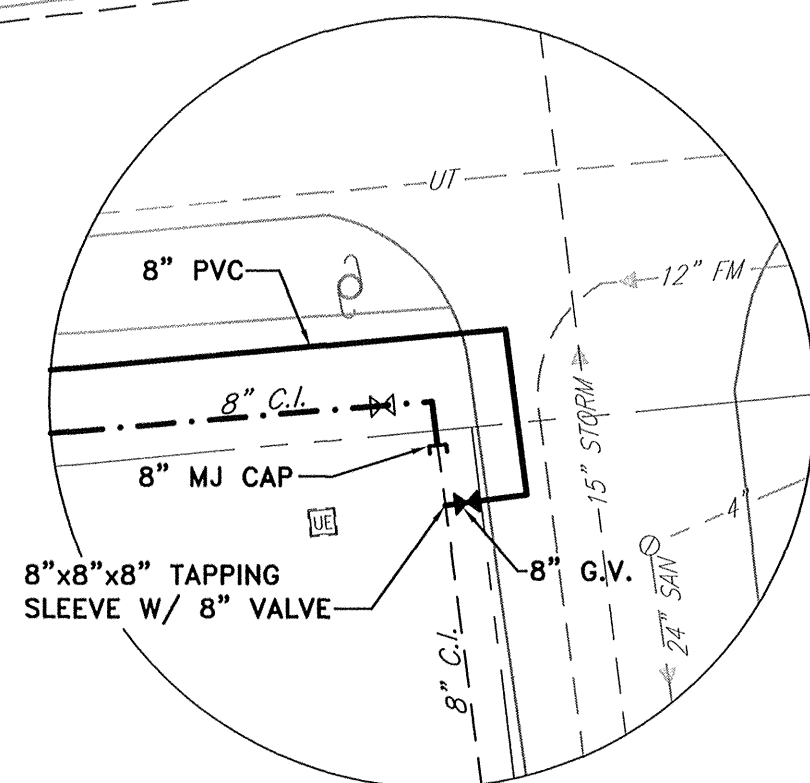

CONNECTION NO. 3-A
SCALE: 1" = 20'

SCALE: 0 25 50

REVISION NUMBER	REVISIONS	DATE	BY

AIRPORT PLANNING / DEVELOPMENT
 ARCHITECTURE / INTERIOR DESIGN
 CIVIL ENGINEERING / SITE DEVELOPMENT
 ENVIRONMENTAL ENGINEERING
 LANDSCAPE ARCHITECTURE
 SURVEYING

St. Albans, WV
 (304) 727-5501
 Buckhannon, WV
 (304) 472-8914
 Martinsburg, WV
 (304) 260-1222

www.chaptech.com

PROJECT INFORMATION

ST. ALBANS MUNICIPAL UTILITY COMMISSION
ST. ALBANS, WEST VIRGINIA
WATER SYSTEM IMPROVEMENTS
CONTRACT NO. 1A - DISTRIBUTION SYSTEM

PLAN SHEET

SEAL

JOB NUMBER:	08053
SCALE:	1" = 50'
DATE:	JUNE 2012
DRAWN BY:	FLB
DESIGNED BY:	KTC
CHECKED BY:	RGB
SHEET NO.	13
REVISION	