
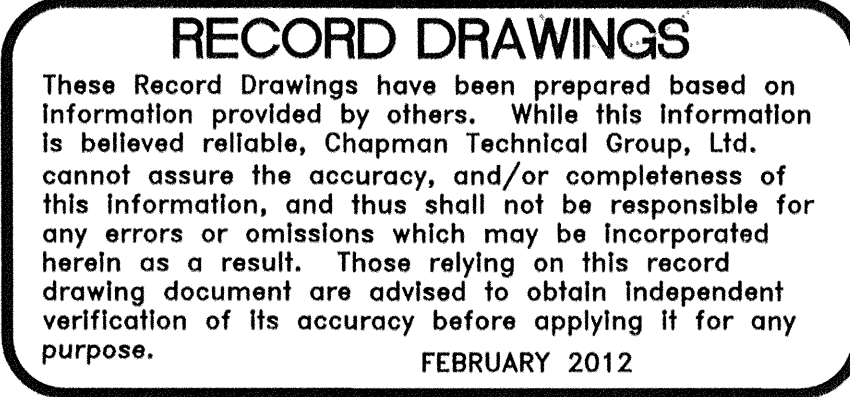 
 




LEGEND			
	SIDEWALKS		EXISTING CLEAN OUT
	PAVED ROADS		EXISTING SANITARY SEWER LINE
	TREELINE		EXISTING MANHOLE
	EXISTING FENCE		AIR RELEASE VALVE
	EXISTING STREAM OR DRAINAGE PATH		PROPERTY LINES
	EXISTING POWER POLE		RIGHT OF WAY LINES
	EXISTING UNDERGROUND ELECTRIC		EXISTING WATERLINE TO BE ABANDONED—IN-PLACE
	EXISTING GAS LINE		NEW WATER LINE
	EXISTING GAS LINE MARKER		NEW GATE VALVE W/ VALVE BOX
	EXISTING UNDERGROUND TELEPHONE		NEW CASING PIPE INSTALLATION
	EXISTING TELEPHONE PEDESTAL		NEW FIRE HYDRANT ASSEMBLY
	EXISTING WATER LINE		NEW BLOW-OFF ASSEMBLY
	EXISTING WATER METER		PLAN SHEET
	EXISTING WATER VALVE		<u>PARCEL NUMBER</u>
	EXISTING FIRE HYDRANT		<u>TAX MAP</u>

PERFORMED IN ACCORDANCE WITH THE FOLLOWING:

- A. WV DOH STANDARD SPECIFICATIONS - ROAD AND BRIDGES, LATEST EDITION.
- B. ACCOMMODATION OF UTILITIES ON HIGHWAY RIGHT-OF-WAY, LATEST EDITION.
- C. TRAFFIC CONTROL FOR STREET & HIGHWAY CONSTRUCTION & MAINTENANCE OPERATION, LATEST EDITION AND AS DIRECTED BY DOT PROJECT REPRESENTATIVE.
- D. PROJECT SPECIFICATIONS PREPARED BY CHAPMAN TECHNICAL GROUP.

	AIRPORT PLANNING / DEVELOPMENT	St. Albans, WV (304) 727-5501
	ARCHITECTURE / INTERIOR DESIGN	Buckhannon, WV (304) 472-8914
Chapman Technical Group	CIVIL ENGINEERING / SITE DEVELOPMENT	Martinsburg, WV (304) 260-1222
	ENVIRONMENTAL ENGINEERING	
	LANDSCAPE ARCHITECTURE	
	SURVEYING	www.chaptechn.com

**INDEX SHEET AND
GENERAL NOTES**

JOB NUMBER:	08053	
SCALE:	1" = 1000'	
DATE:	JUNE 2010	
DRAWN BY:	FLB	
DESIGNED BY:	MJC	
CHECKED BY:	RGB/JDE	
SHEET NO.		REVISION
INDEX		