


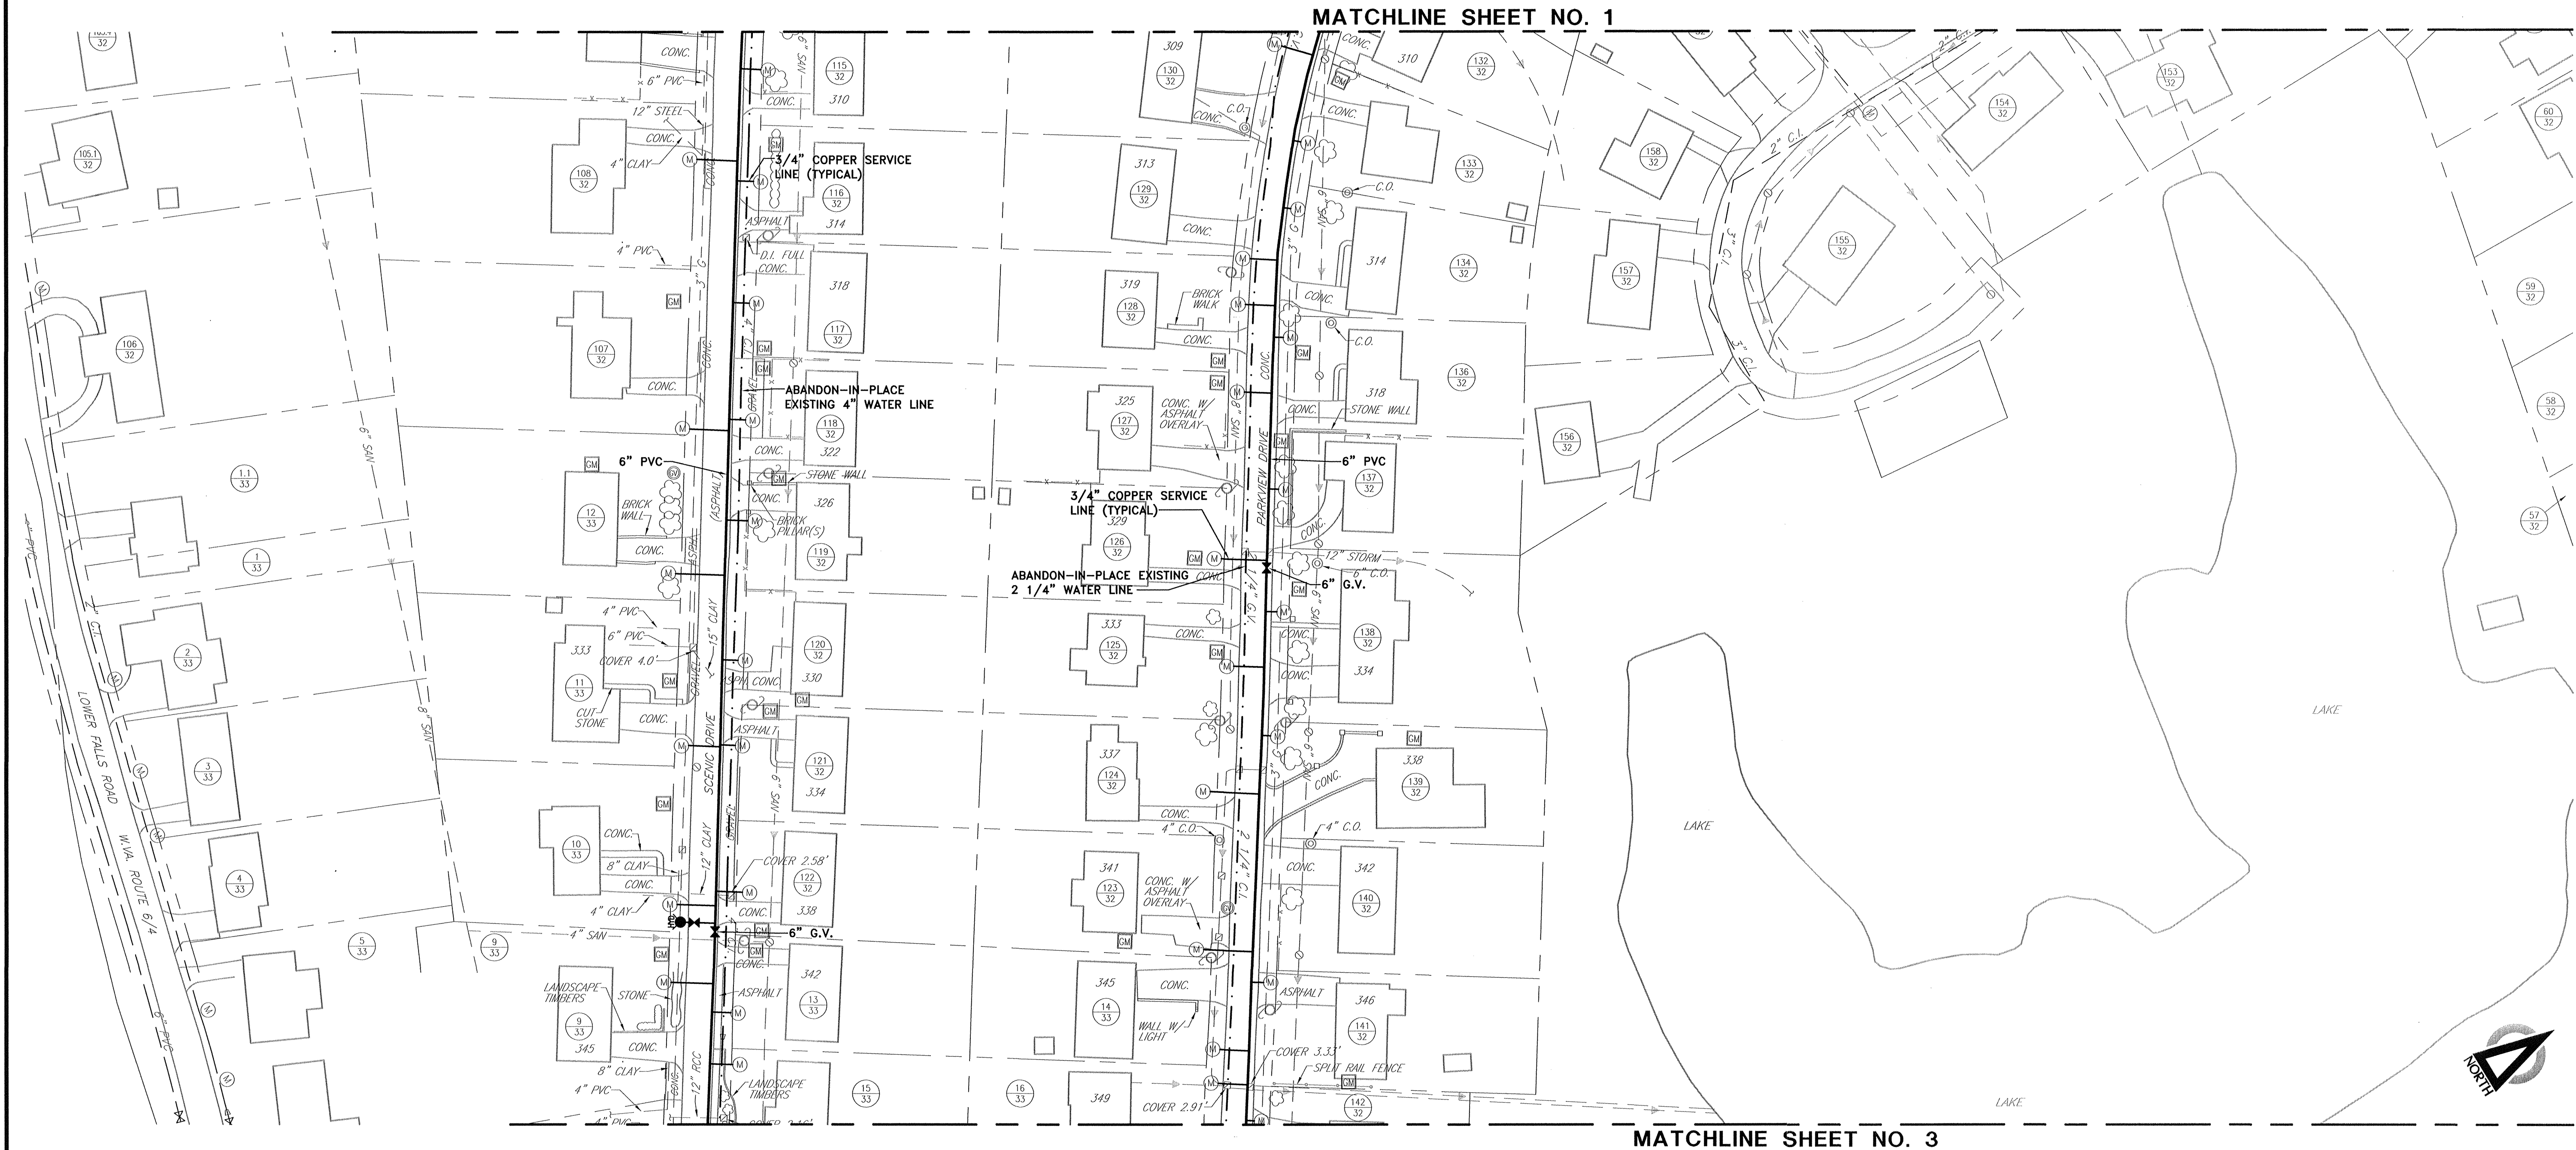

MATCHLINE SHEET NO. 3

RECORD DRAWINGS


These Record Drawings have been prepared based on information provided by others. While this information is believed reliable, Chapman Technical Group, Ltd. cannot assure the accuracy, and/or completeness of this information, and thus shall not be responsible for any errors or omissions which may be incorporated herein as a result. Those relying on this record drawing document are advised to obtain independent verification of its accuracy before applying it for any purpose.

JULY 2012

LEGEND

---	EXISTING WATERLINE TO BE ABANDONED-IN-PLACE
---	PROPERTY LINE
---	NEW WATERLINE
---	EXIST. WATERLINE TO REMAIN

REVISION NUMBER	REVISIONS	DATE	BY

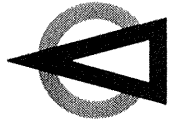

**Chapman
Technical
Group**

AIRPORT PLANNING / DEVELOPMENT
ARCHITECTURE / INTERIOR DESIGN
CIVIL ENGINEERING / SITE DEVELOPMENT
ENVIRONMENTAL ENGINEERING
LANDSCAPE ARCHITECTURE
SURVEYING

St. Albans, WV (304) 727-5501
Buckhannon, WV (304) 472-8914
Martinsburg, WV (304) 260-1222


www.chaptechnical.com

PROJECT INFORMATION

ST. ALBANS MUNICIPAL UTILITY COMMISSION
ST. ALBANS, WEST VIRGINIA
WATER SYSTEM IMPROVEMENTS
CONTRACT NO. 3 - DISTRIBUTION SYSTEM

PLAN SHEET

SEAL

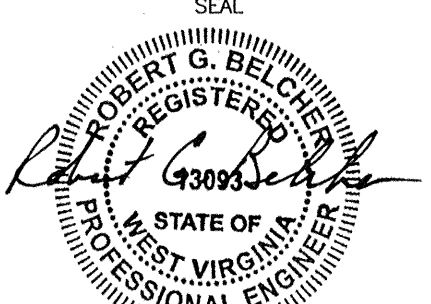

JOB NUMBER:	08053
SCALE:	1" = 50'
DATE:	JUNE 2010
DRAWN BY:	FLB
DESIGNED BY:	KTC
CHECKED BY:	RGB
SHEET NO.	2
REVISION	