
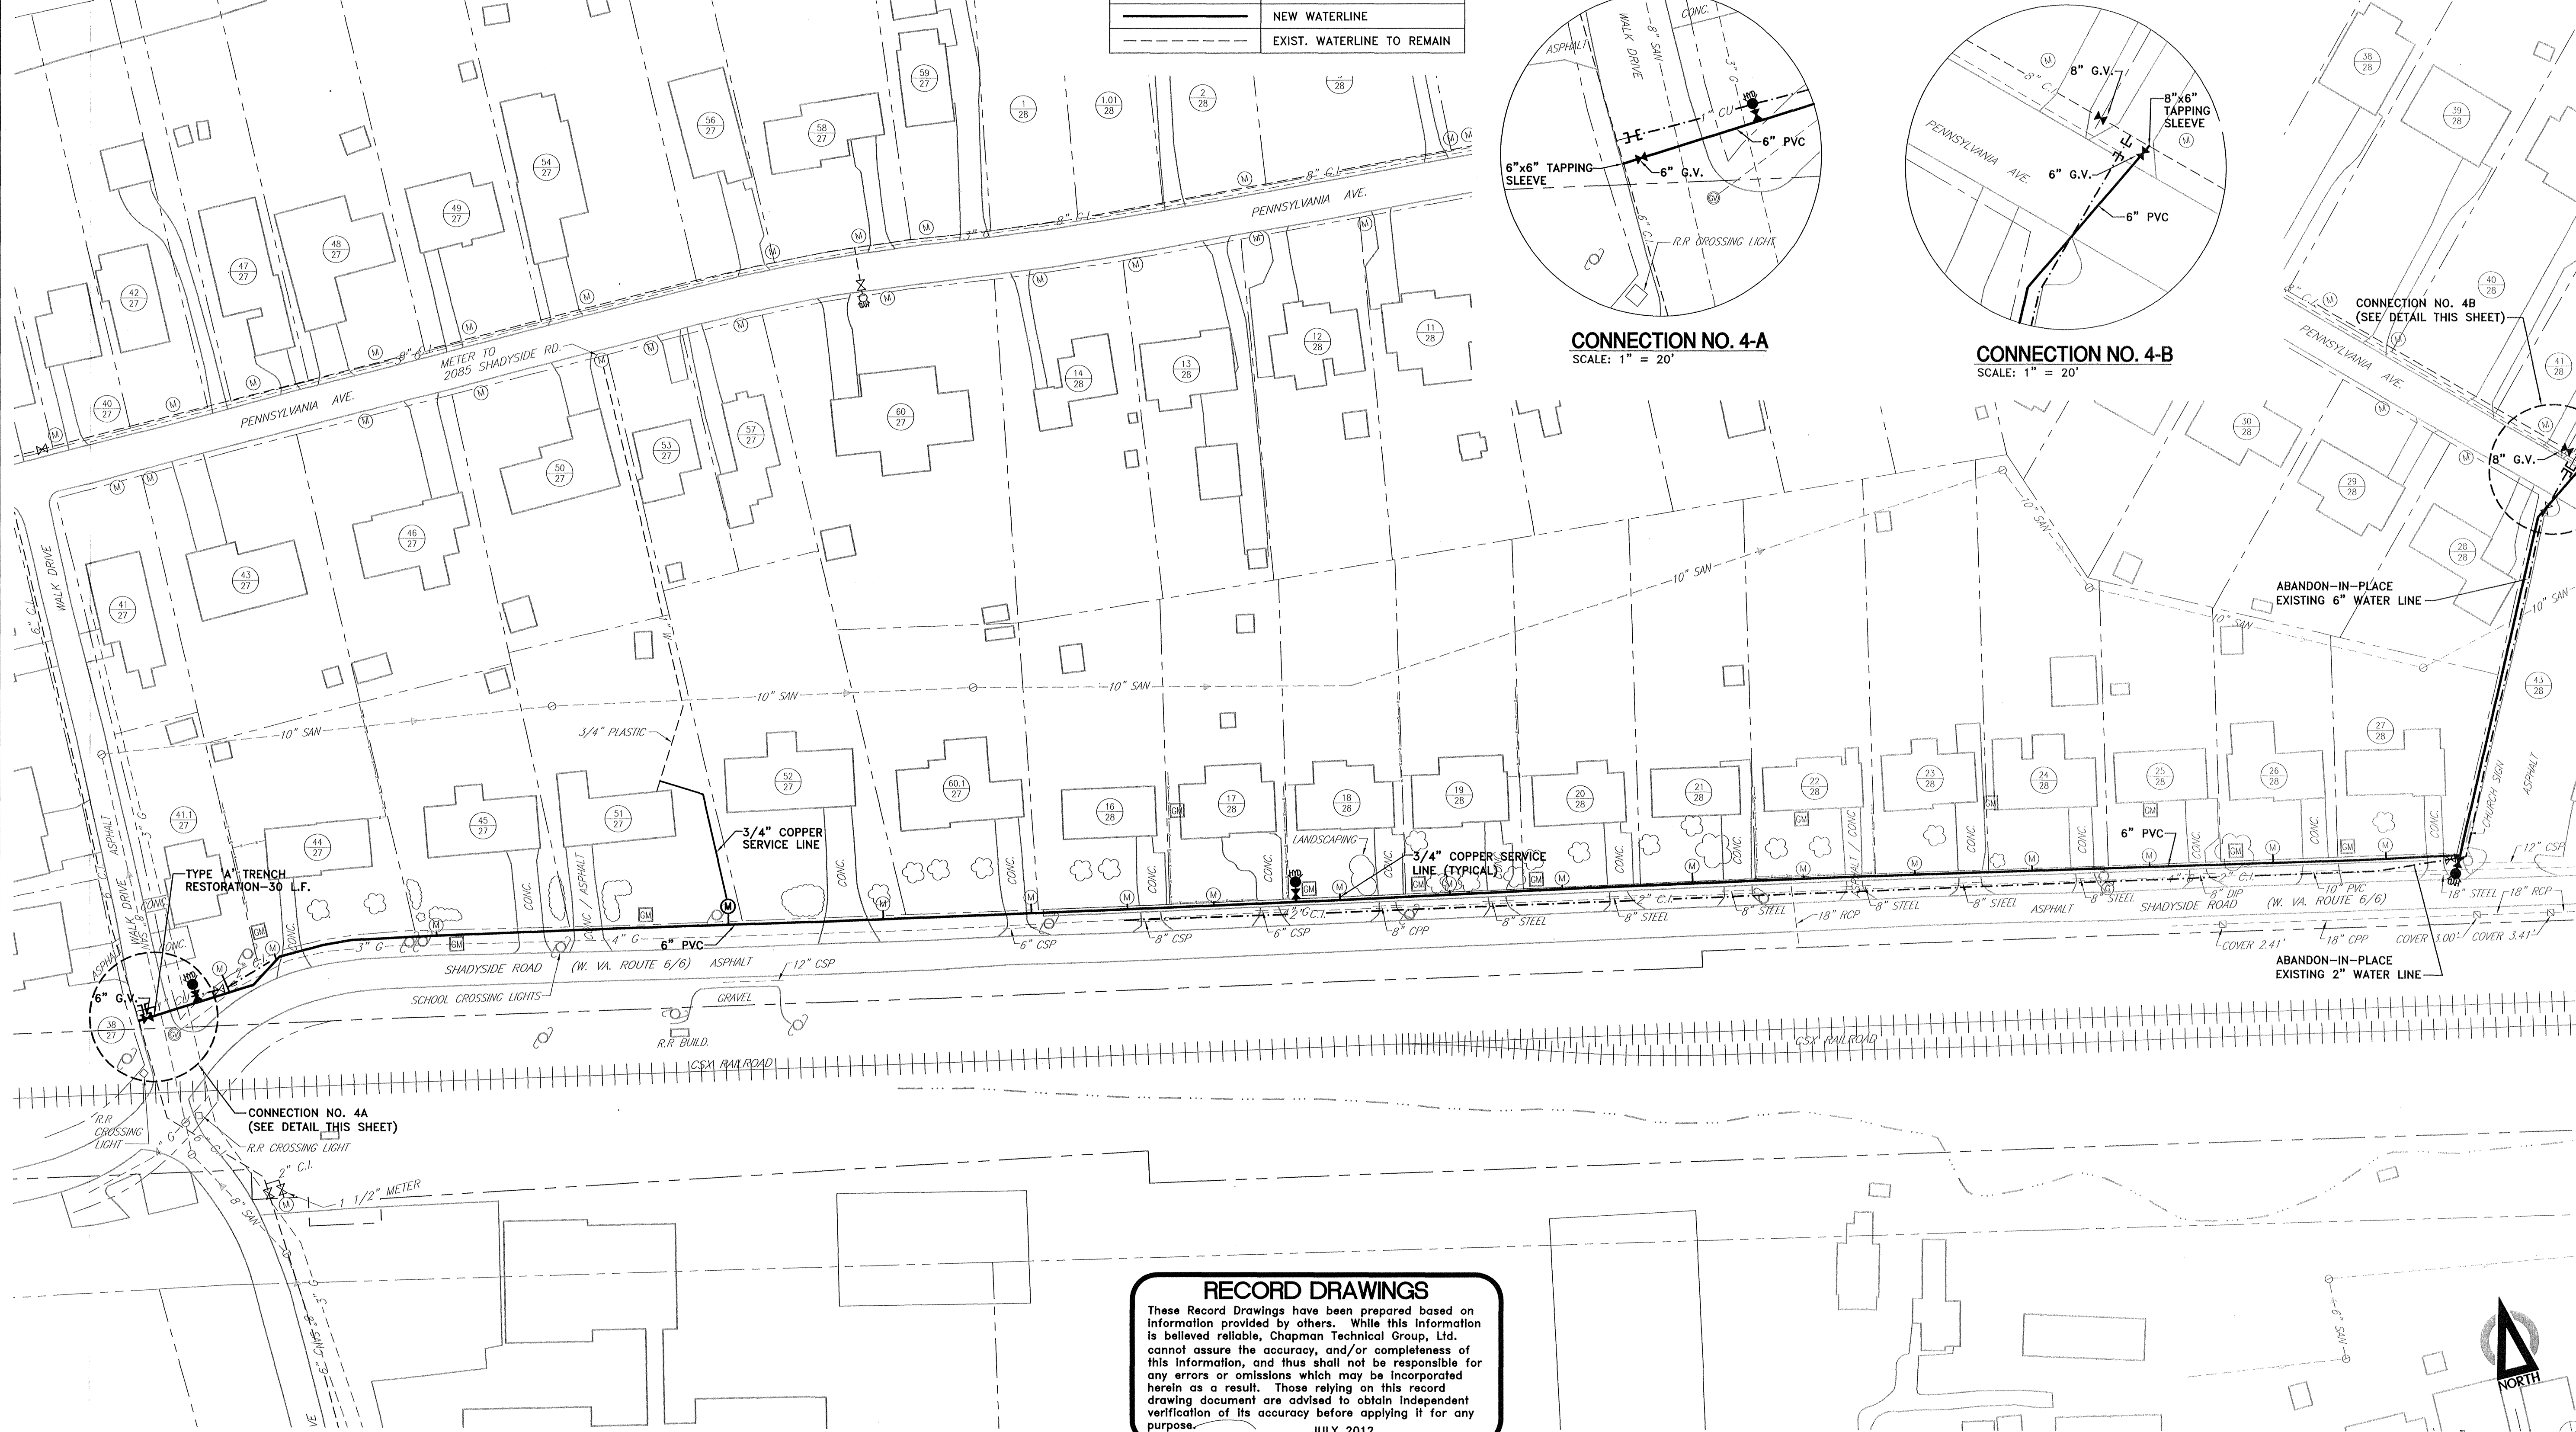
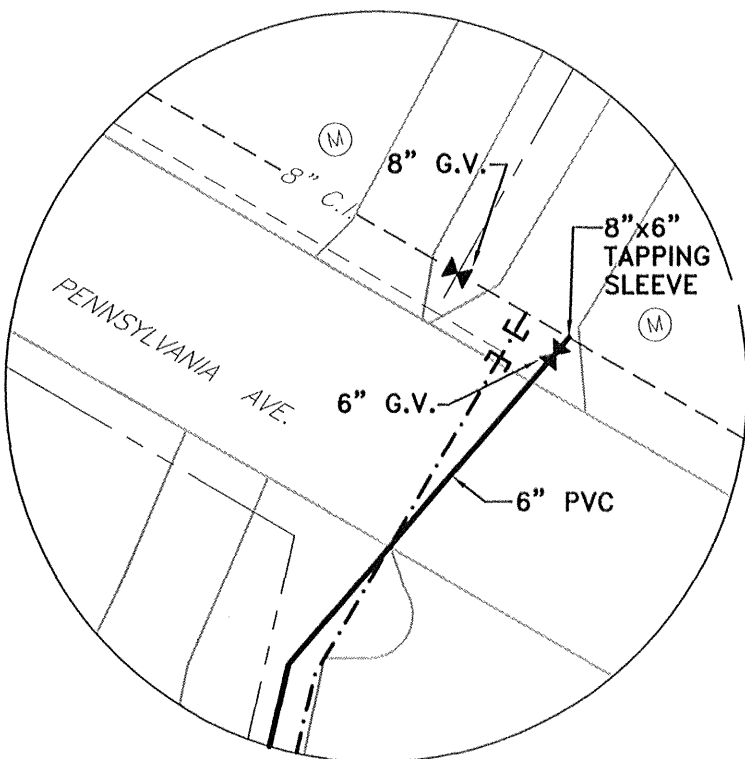


LEGEND	
	EXISTING WATERLINE TO BE ABANDONED-IN-PLACE
	PROPERTY LINE
	NEW WATERLINE
	EXIST. WATERLINE TO REMAIN

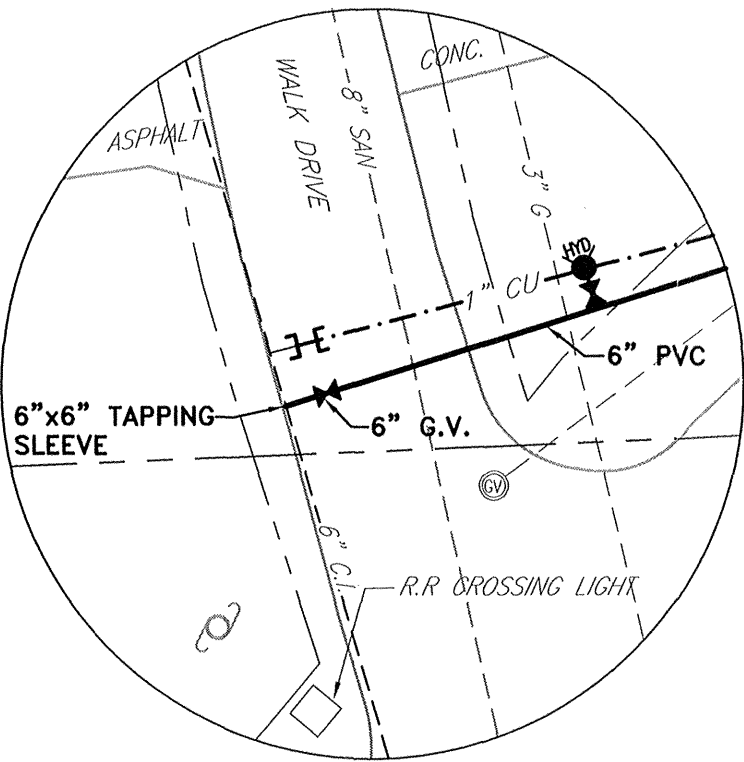

RECORD DRAWINGS

These Record Drawings have been prepared based on information provided by others. While this information is believed reliable, Chapman Technical Group, Ltd. cannot assure the accuracy, and/or completeness of this information, and thus shall not be responsible for any errors or omissions which may be incorporated herein as a result. Those relying on this record drawing document are advised to obtain independent verification of its accuracy before applying it for any purpose.

JULY 2012

REVISION NUMBER	REVISIONS	DATE	BY



AIRPORT PLANNING / DEVELOPMENT

ARCHITECTURE / INTERIOR DESIGN

CIVIL ENGINEERING / SITE DEVELOPMENT

ENVIRONMENTAL ENGINEERING

LANDSCAPE ARCHITECTURE

SURVEYING

St. Albans, WV
(304) 727-5501

Buckhannon, WV
(304) 472-8914

Martinsburg, WV
(304) 260-1222

www.chaptech.com

PROJECT INFORMATION


ST. ALBANS MUNICIPAL UTILITY COMMISSION

ST. ALBANS, WEST VIRGINIA

WATER SYSTEM IMPROVEMENTS

CONTRACT NO. 3 - DISTRIBUTION SYSTEM

PLAN SHEET

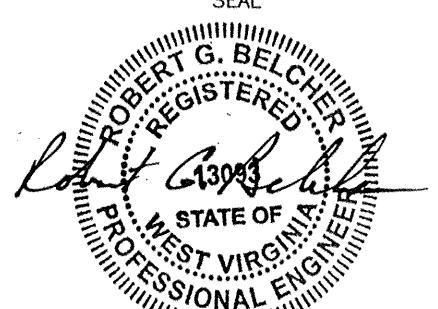

JOB NUMBER:	08053
SCALE:	1" = 50'
DATE:	JUNE 2010
DRAWN BY:	FLB
DESIGNED BY:	KTC
CHECKED BY:	RGB
SHEET NO.	4
REVISION	