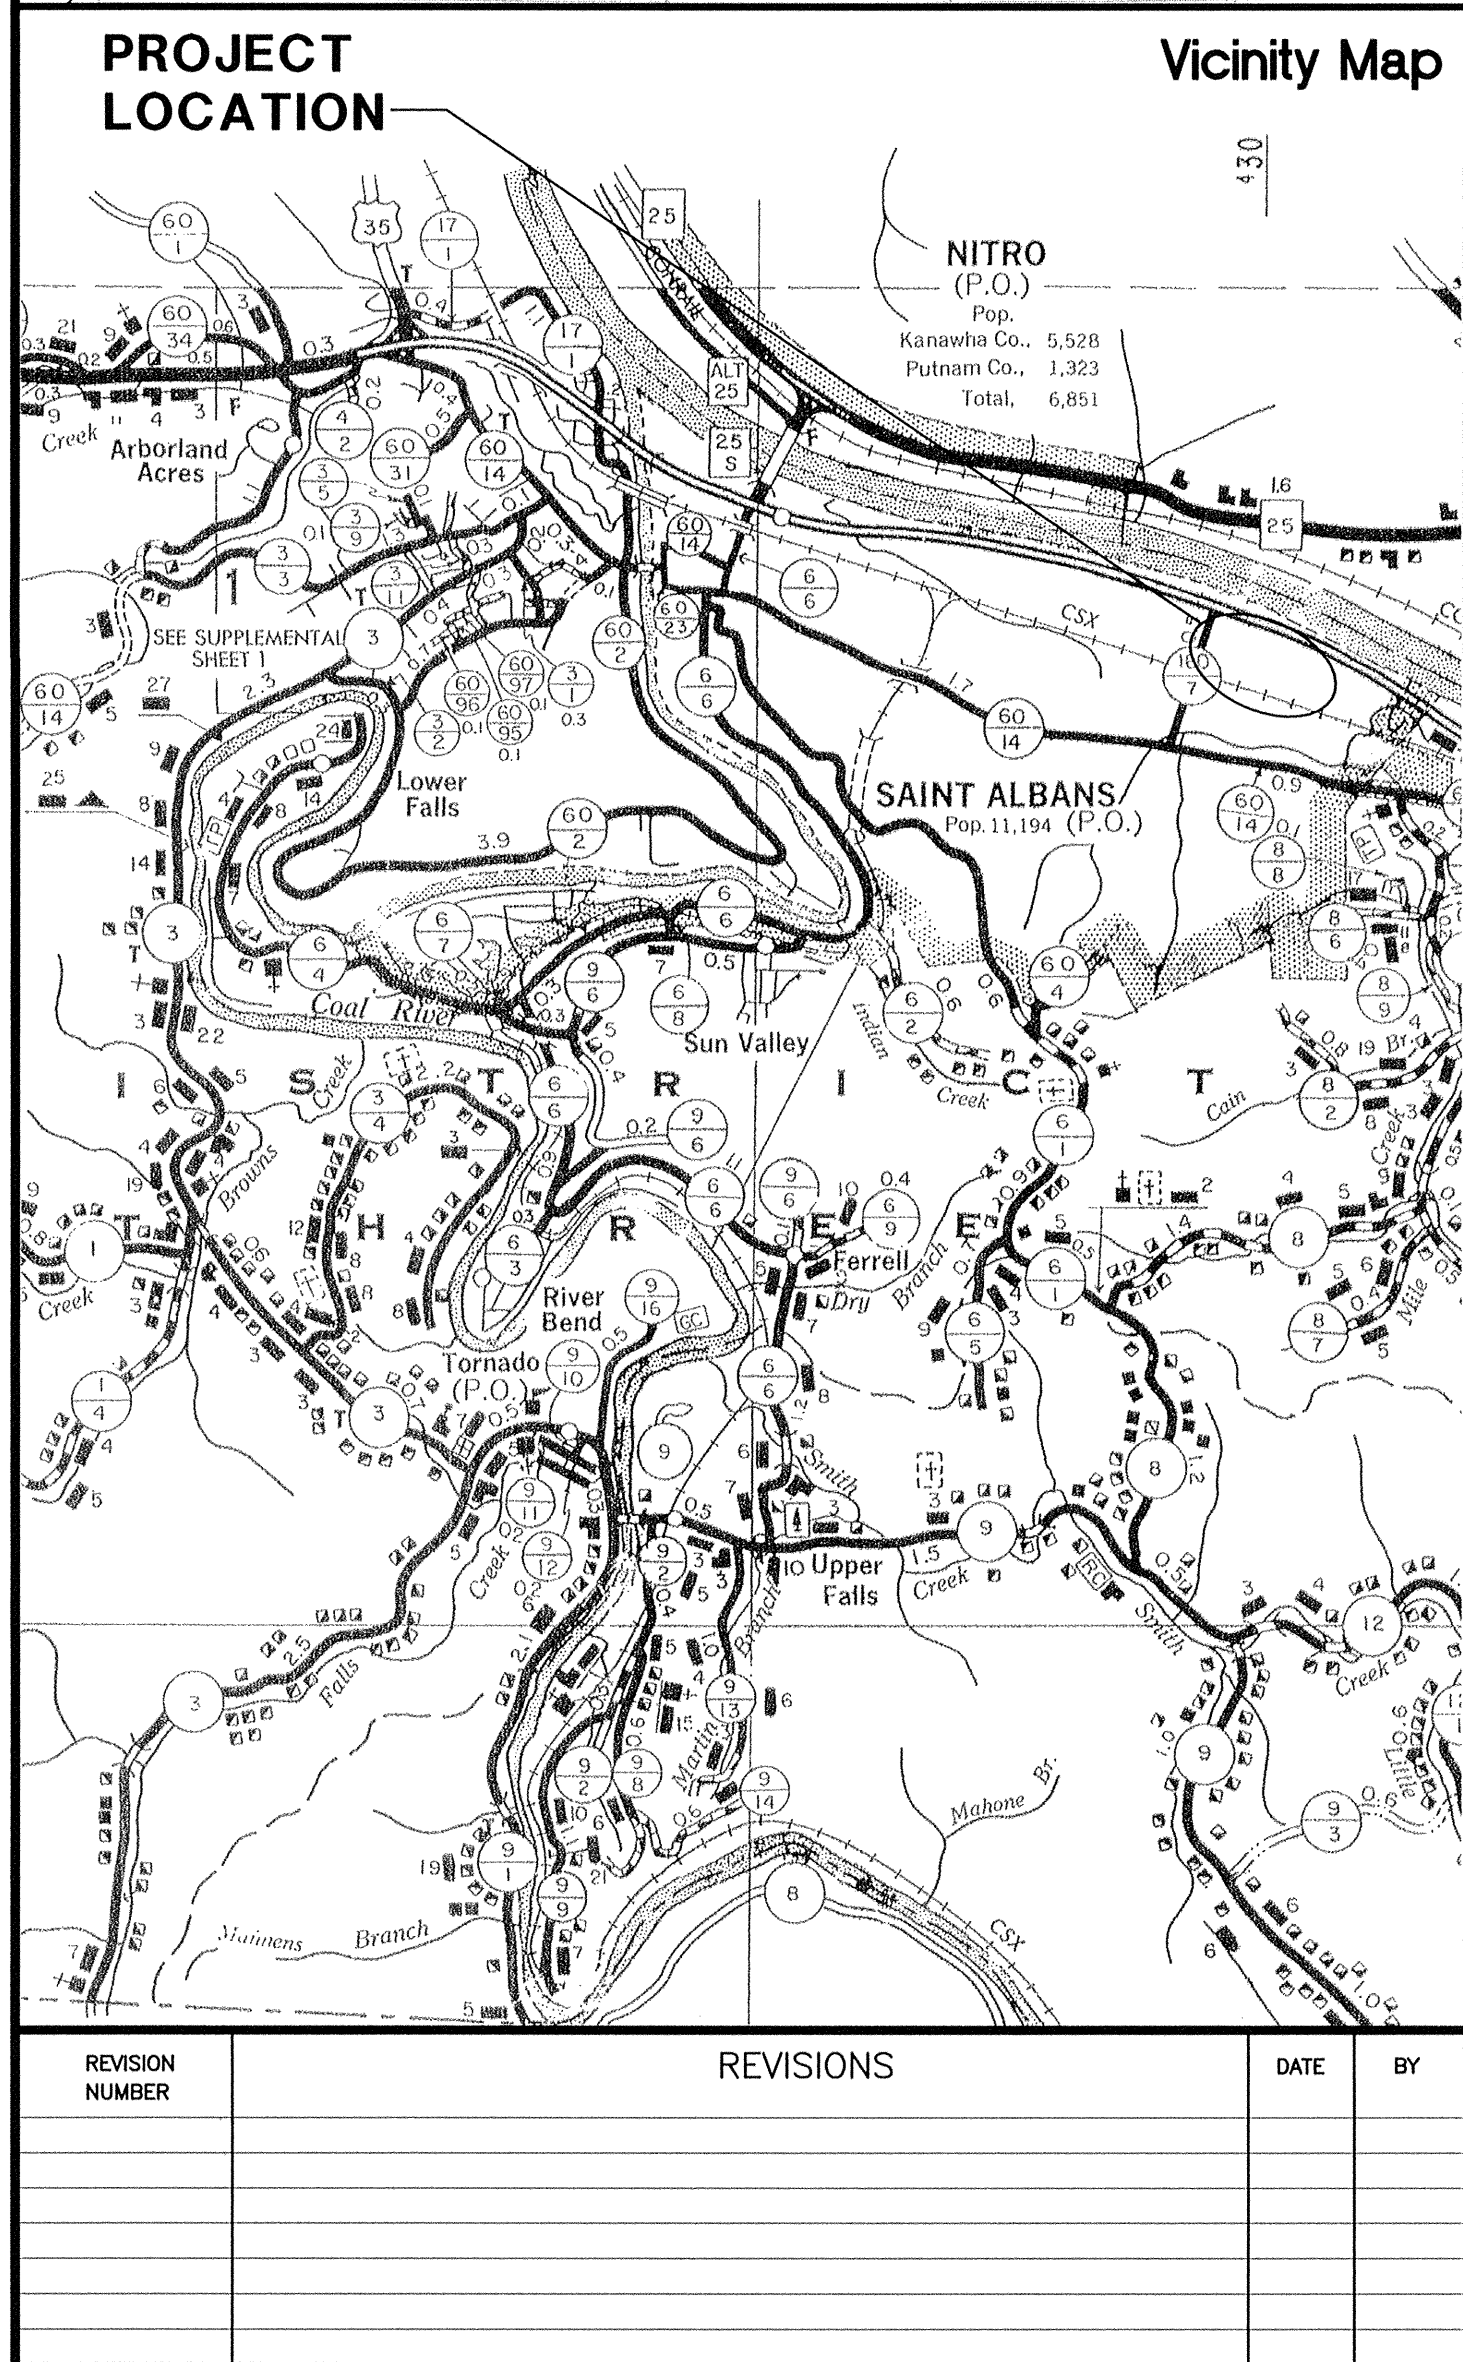


[illegible]

Index	Index and General Notes
1-6	Plan Sheets
Det-1	Miscellaneous Details
Det-2	Miscellaneous Details
Det-3	Sediment and Erosion Control Notes and Details
Det-4	Sediment and Erosion Control Details


RECORD DRAWINGS

These Record Drawings have been prepared based on information provided by others. While this information is believed reliable, Chapman Technical Group, Ltd. cannot assure the accuracy, and/or completeness of this information, and thus shall not be responsible for any errors or omissions which may be incorporated herein as a result. Those relying on this record drawing document are advised to obtain independent verification of its accuracy before applying it for any purpose.

JULY 2012

Robert G. Belcher
Robert G. Belcher, P.E.

5-2-13
DATE

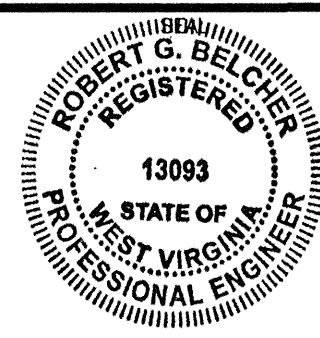

**Chapman
Technical
Group**

**AIRPORT PLANNING / DEVELOPMENT
ARCHITECTURE / INTERIOR DESIGN
CIVIL ENGINEERING / SITE DEVELOPMENT
ENVIRONMENTAL ENGINEERING
LANDSCAPE ARCHITECTURE
SURVEYING**

www.chaptech.com

200 Sixth Avenue
St. Albans, West Virginia 25177
(304)727-5501

43 East Main Street
Buckhannon, West Virginia 26201
(304)472-8914

170 Aviation Way, Suite 102
Martinsburg, West Virginia 25405
(304)260-1222

JOB NUMBER:	08053
SCALE:	NONE
DATE:	JUNE 2010
DRAWN BY:	LDA
DESIGNED BY:	MJC
CHECKED BY:	RGB

SHEET NO.

COVER

REVISION

0