



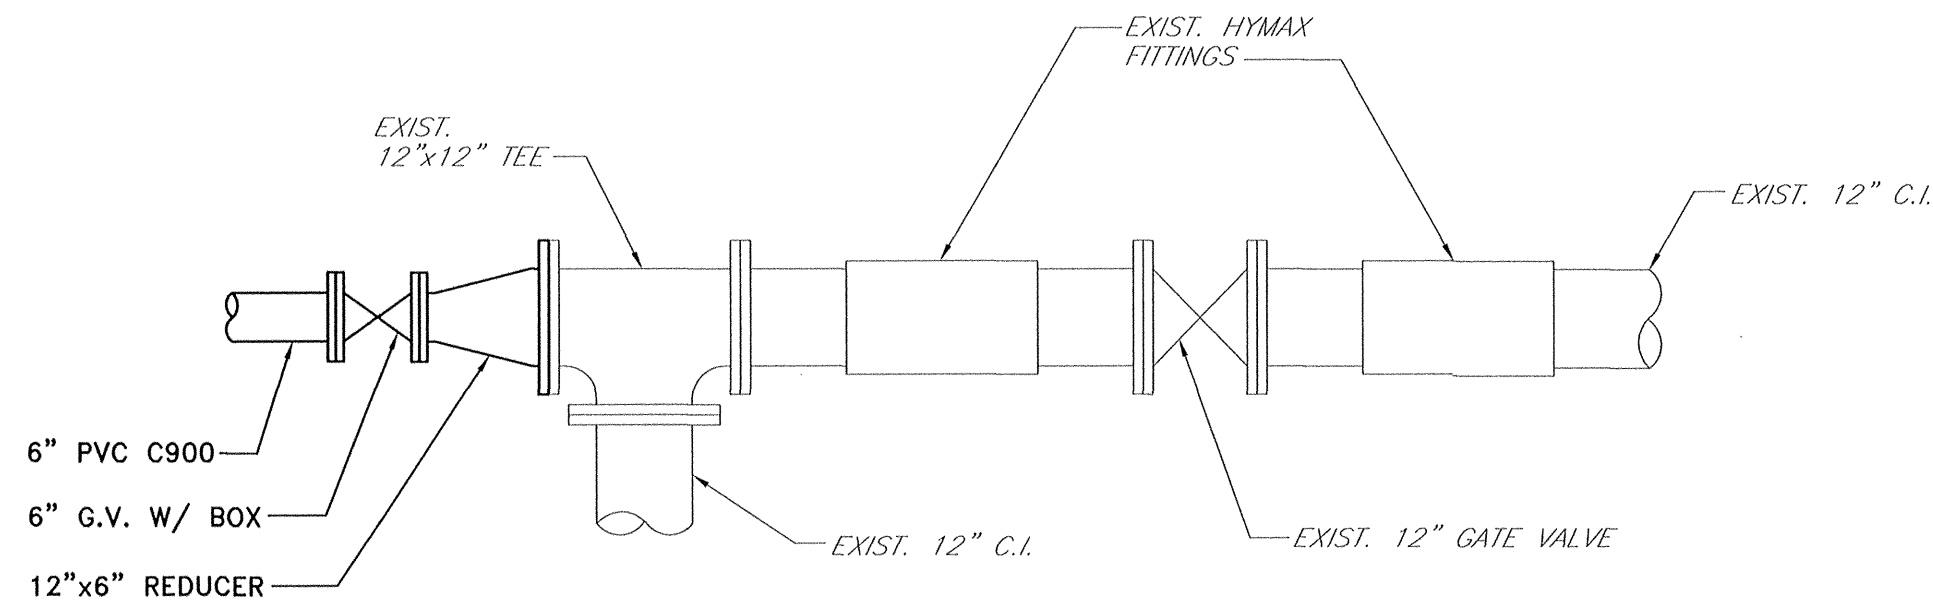

PLAN

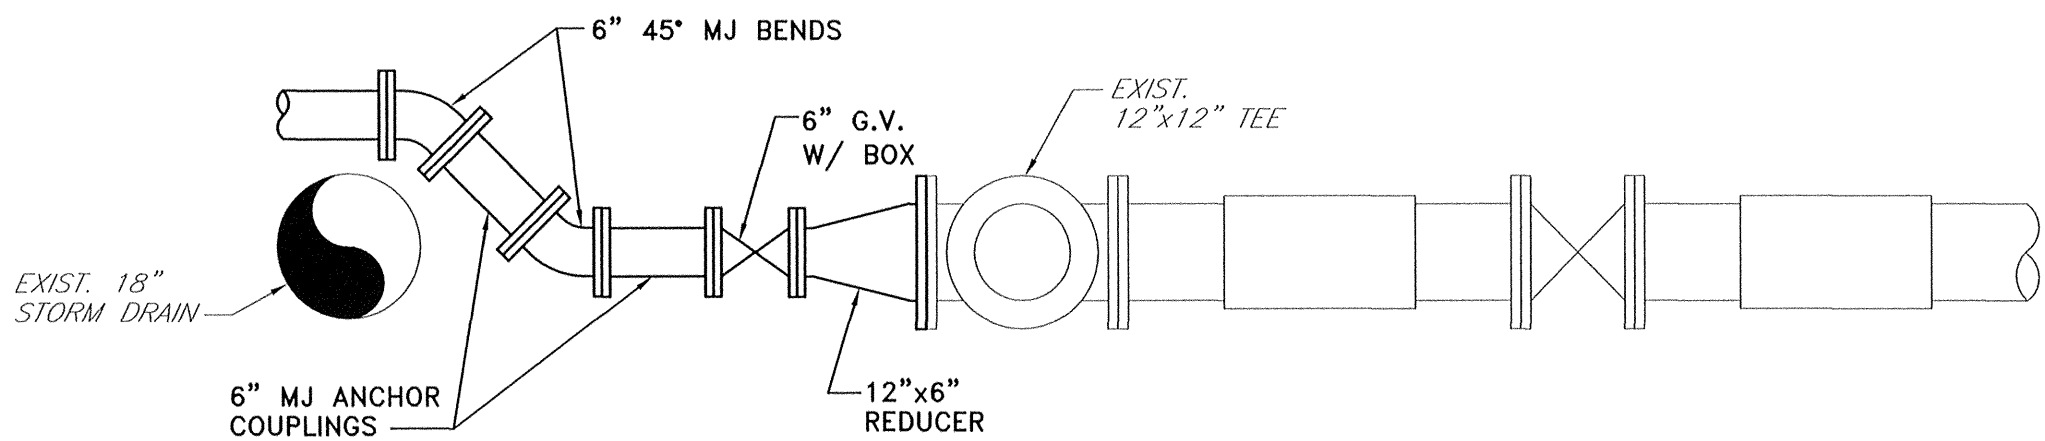

ELEVATION


CONNECTION DETAILS

SCALE: NONE

RECORD DRAWINGS

These Record Drawings have been prepared based on information provided by others. While this information is believed reliable, Chapman Technical Group, Ltd. cannot assure the accuracy, and/or completeness of this information, and thus shall not be responsible for any errors or omissions which may be incorporated herein as a result. Those relying on this record drawing document are advised to obtain independent verification of its accuracy before applying it for any purpose.

October 2013

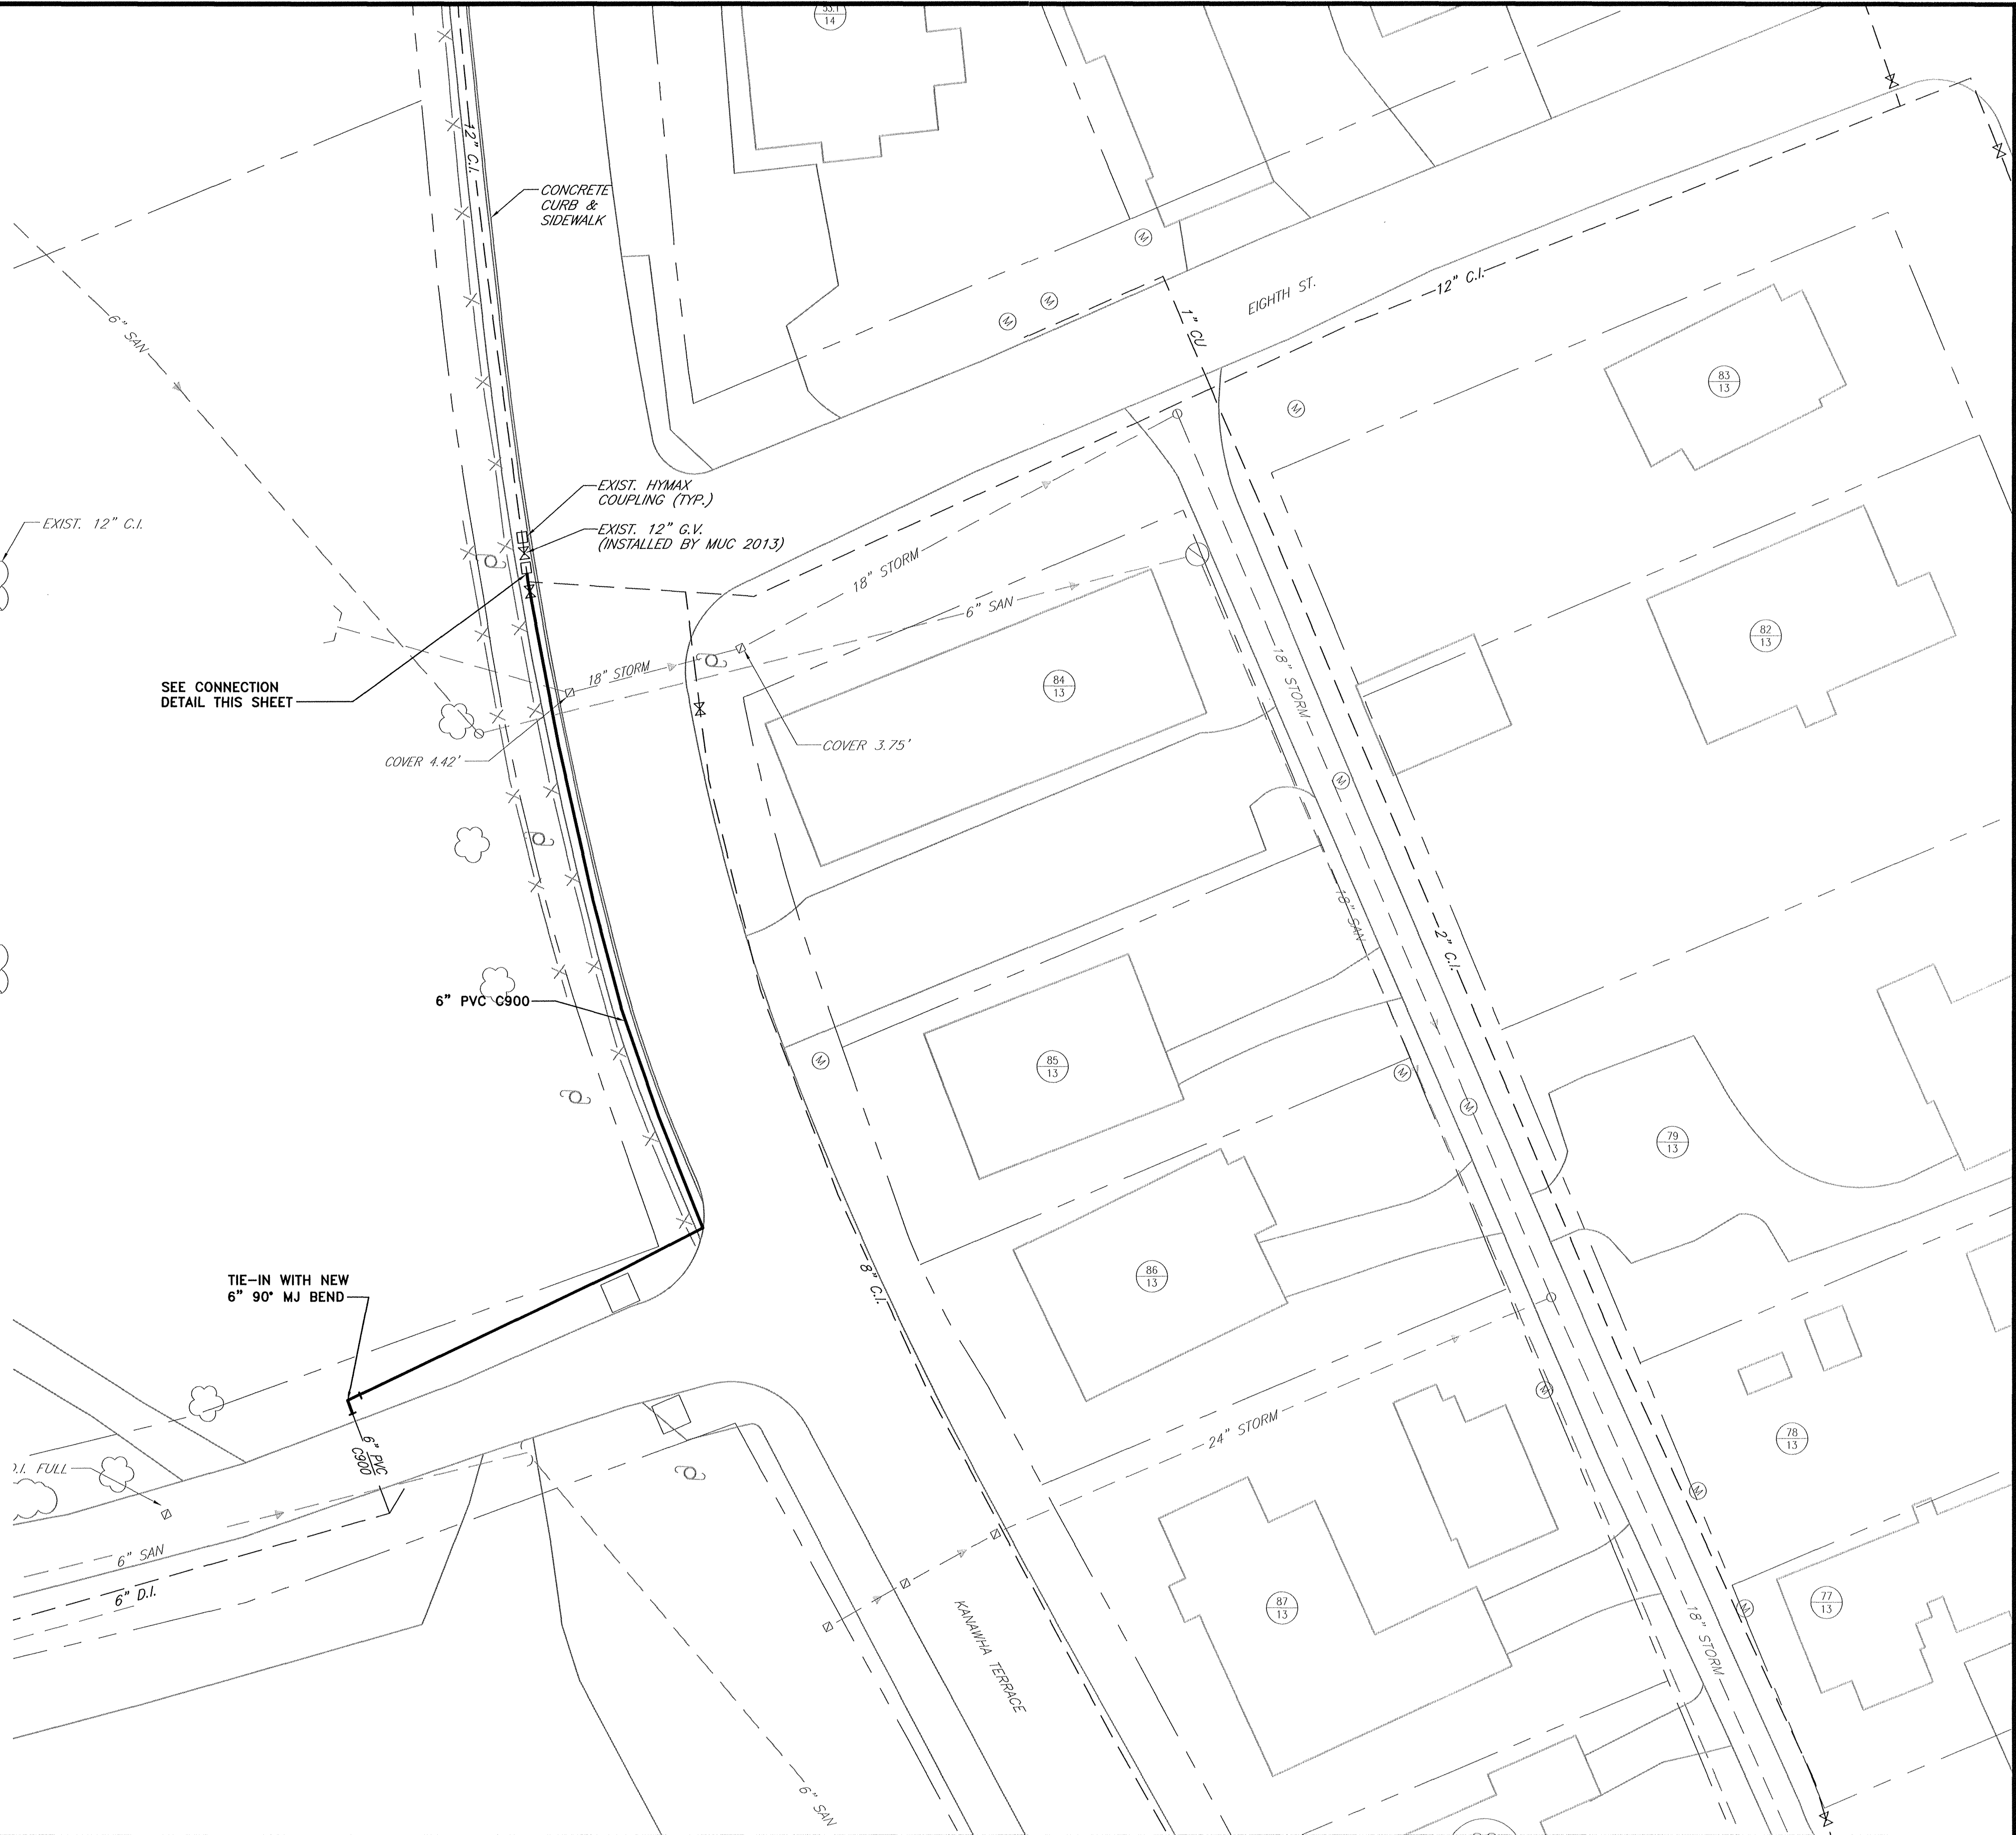

REVISION NUMBER	REVISIONS	DATE	BY

AIRPORT PLANNING / DEVELOPMENT

ARCHITECTURE / INTERIOR DESIGN

CIVIL ENGINEERING / SITE DEVELOPMENT

ENVIRONMENTAL ENGINEERING

LANDSCAPE ARCHITECTURE

SURVEYING

St. Albans, WV
(304) 727-5501

Buckhannon, WV
(304) 472-8914

Martinsburg, WV
(304) 260-1222

www.chaptech.com

PROJECT INFORMATION

ST. ALBANS MUNICIPAL UTILITY COMMISSION

ST. ALBANS, WEST VIRGINIA

WATER SYSTEM IMPROVEMENTS

CONTRACT NO. 2 - DISTRIBUTION SYSTEM

PLAN SHEET

JOB NUMBER:	08053
SCALE:	1" = 20'
DATE:	MAY 2013
DRAWN BY:	LDA
DESIGNED BY:	RGB
CHECKED BY:	RGB/JDE
SHEET NO.	3A
REVISION	