



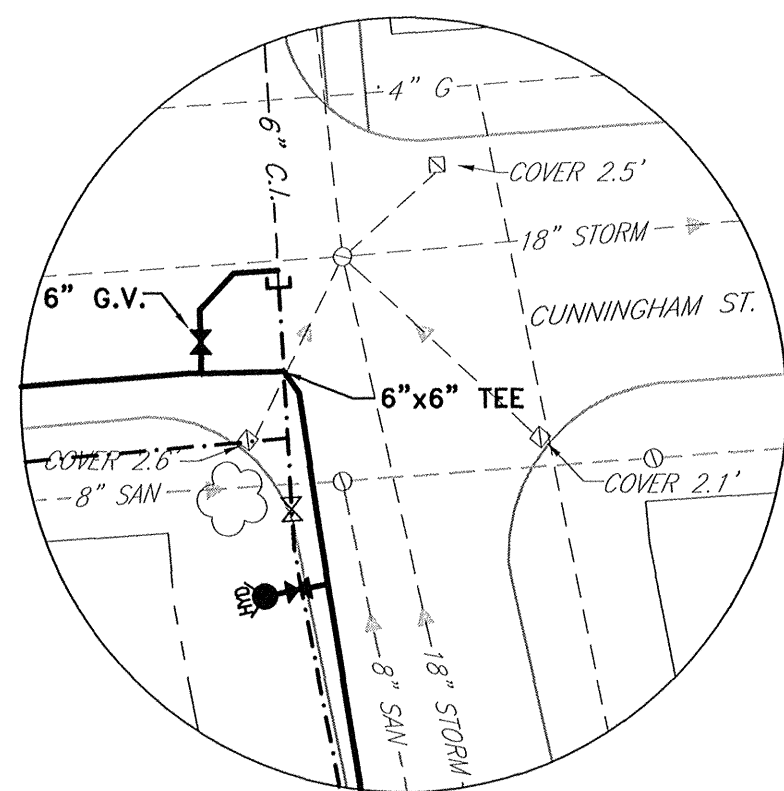


CONNECTION NO. 6-A
SCALE: 1" = 20'

CONNECTION NO. 6-B
SCALE: 1" = 20'

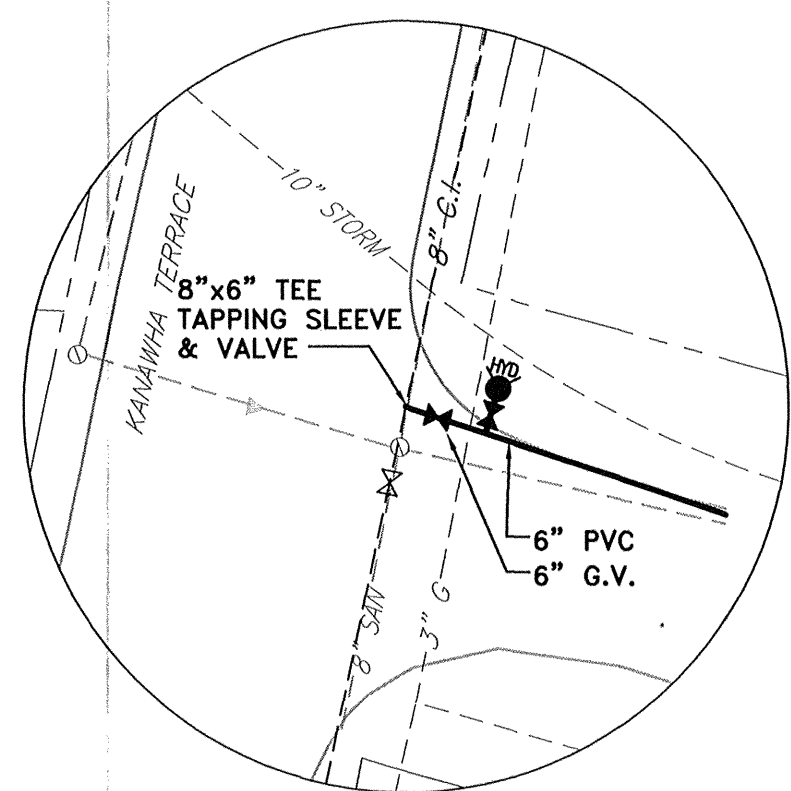

CONNECTION NO. 6-C
SCALE: 1" = 20'

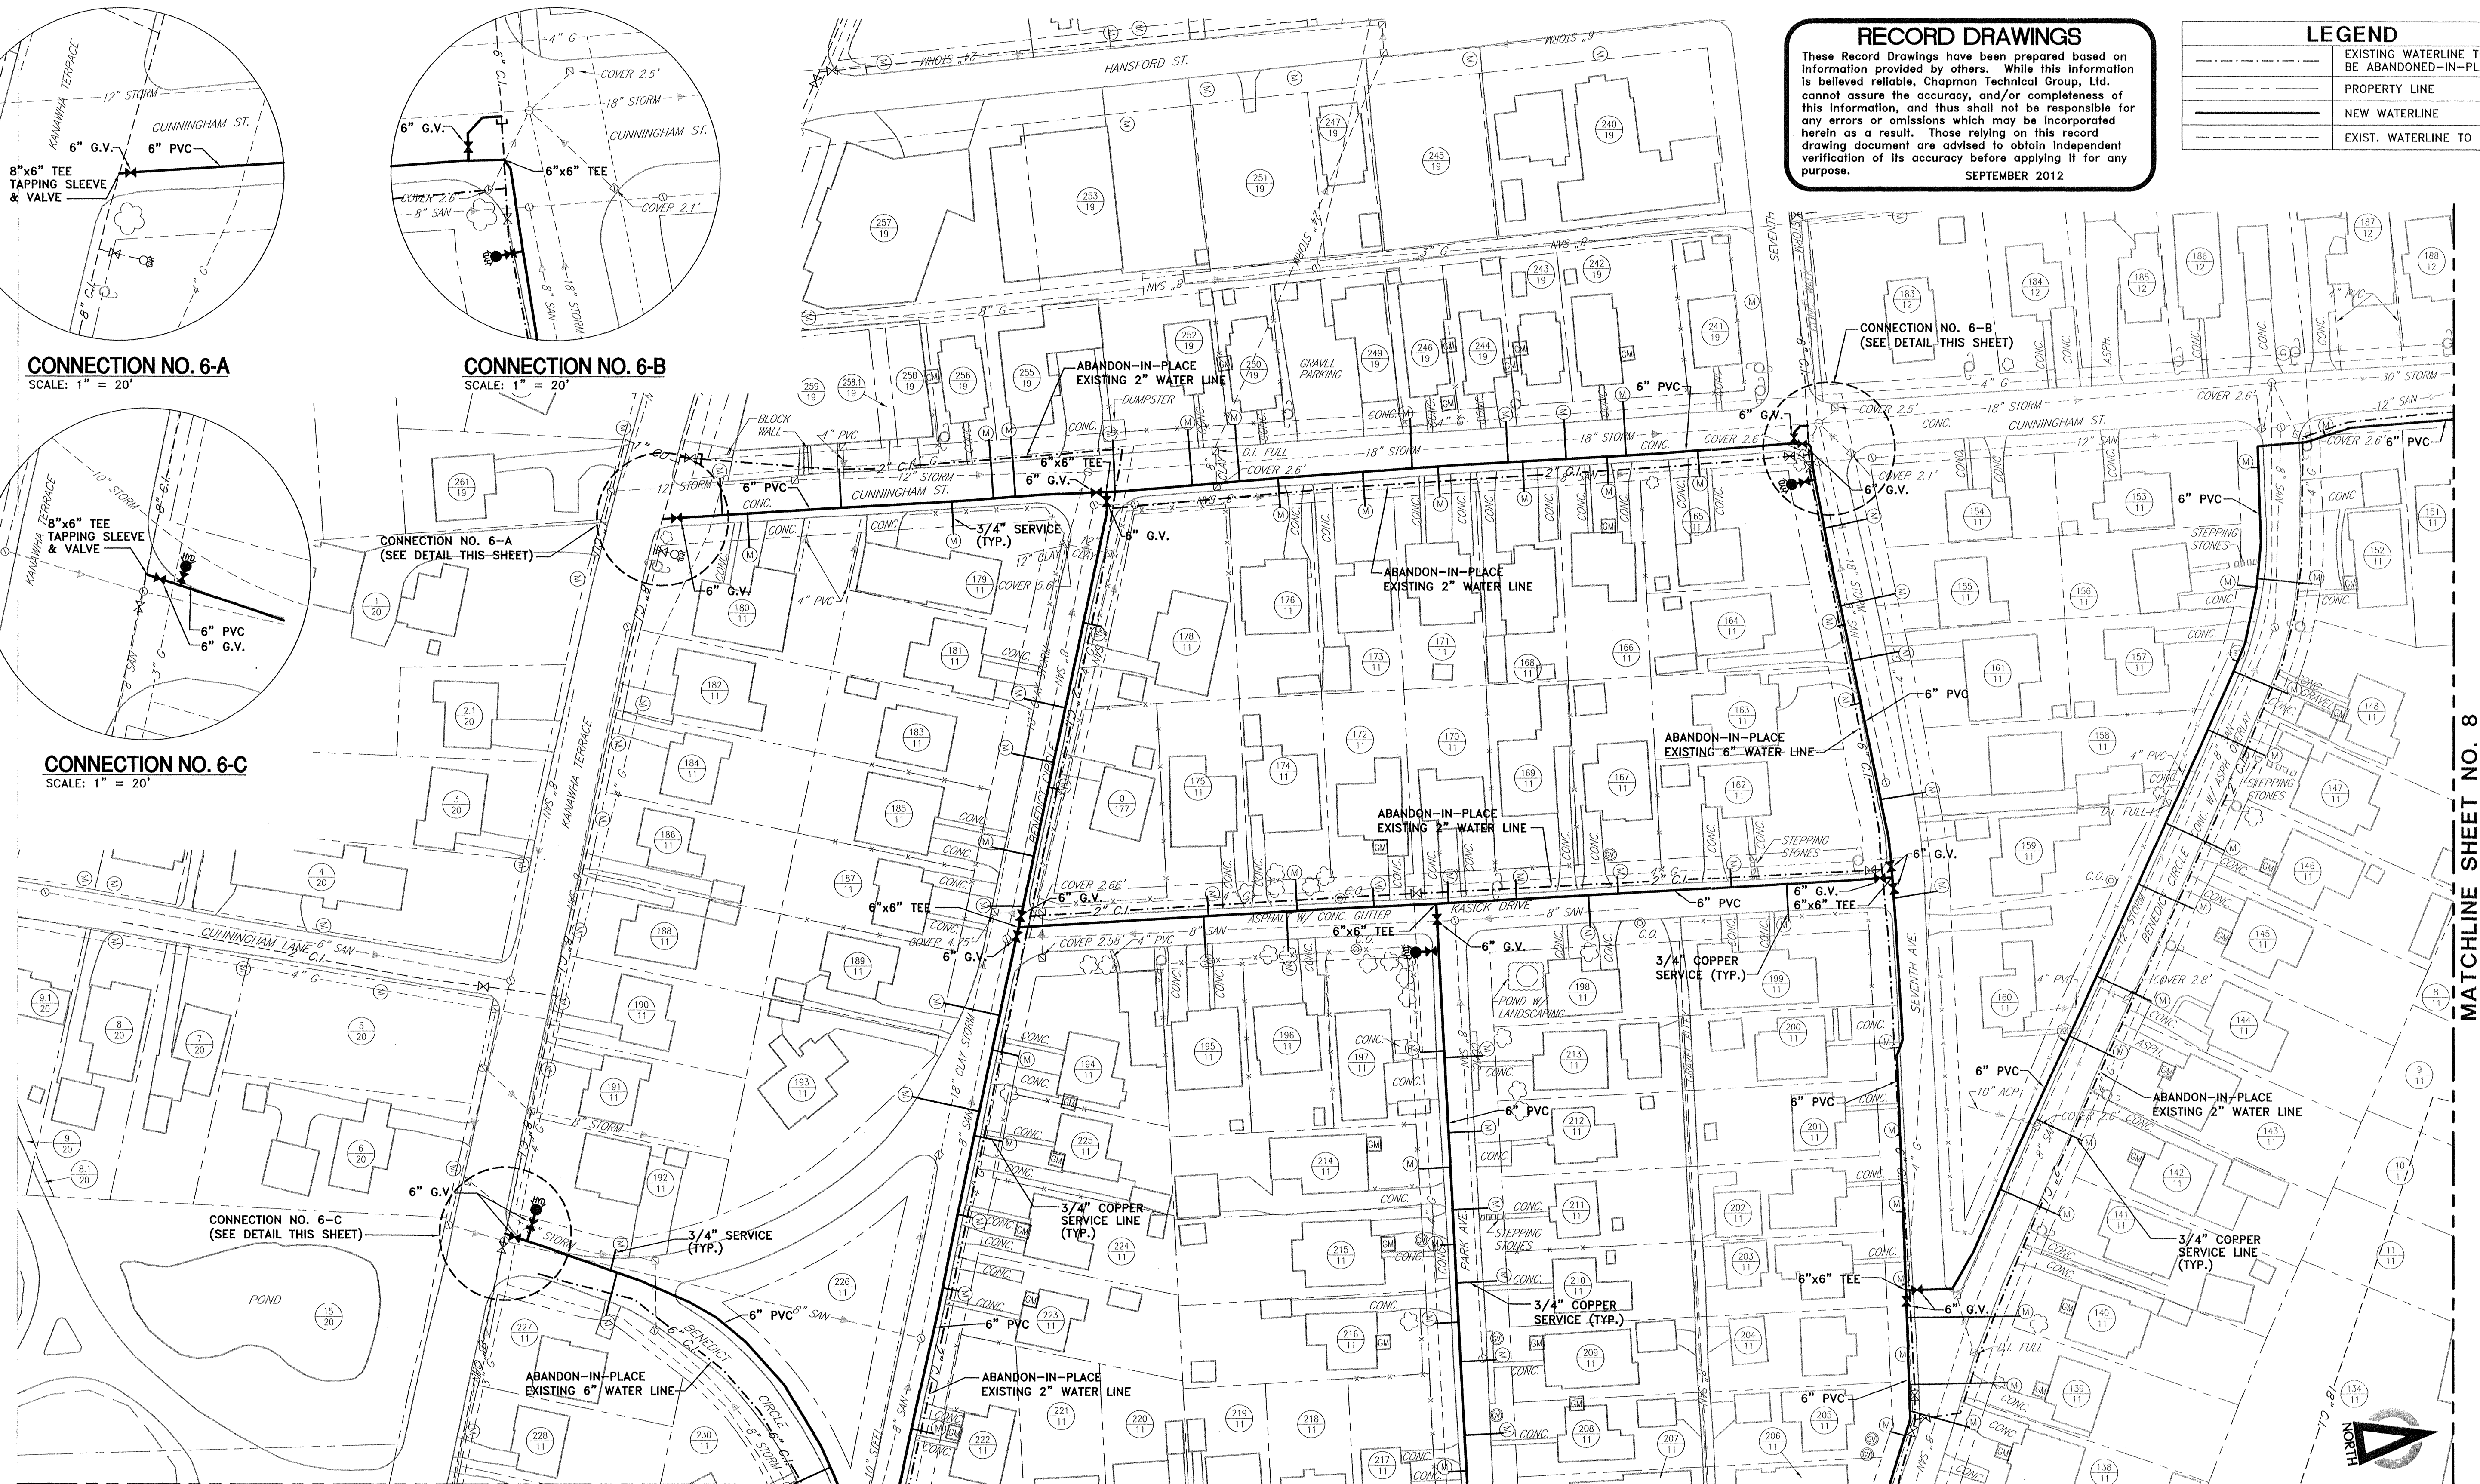

MATCHLINE SHEET NO. 7

[illegible]

- AIRPORT PLANNING / DEVELOPMENT
- ARCHITECTURE / INTERIOR DESIGN
- CIVIL ENGINEERING / SITE DEVELOPMENT
- ENVIRONMENTAL ENGINEERING
- LANDSCAPE ARCHITECTURE
- SURVEYING

St. Albans, WV
(304) 727-5501

Buckhannon, WV
(304) 472-8914


Martinsburg, WV
(304) 260-1222

www.chaptech.com

PROJECT INFORMATION

ST. ALBANS MUNICIPAL UTILITY COMMISSION
ST. ALBANS, WEST VIRGINIA
WATER SYSTEM IMPROVEMENTS
CONTRACT NO. 2 - DISTRIBUTION SYSTEM

PLAN SHEET

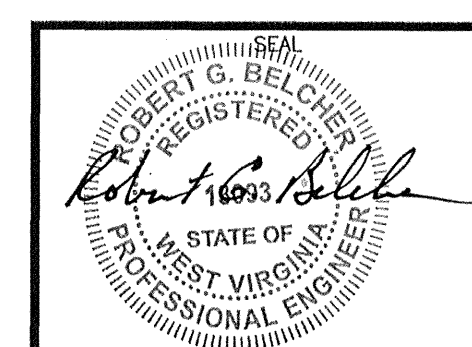

JOB NUMBER:	08053	
SCALE:	1" = 50'	
DATE:	MAY 2010	
DRAWN BY:	FLB	
DESIGNED BY:	MJC	
CHECKED BY:	RGB/JDE	
SHEET NO.		REVISION
6		△