



Map of West Virginia showing county boundaries and names. The map includes labels for neighboring states: OHIO, PENNSYLVANIA, MD, VIRGINIA, and KENTUCKY. A shaded area in Lincoln County is labeled 'PROJECT LOCATION' with a line pointing to it. A scale bar at the bottom right indicates 'APPROXIMATE MILES' from 0 to 40. A north arrow is located on the right side of the map.

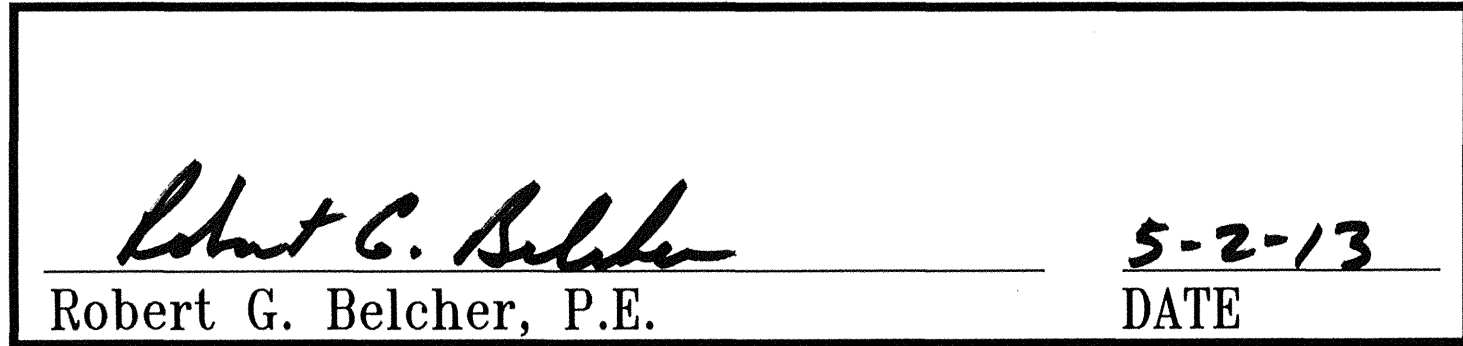

RECORD DRAWINGS

These Record Drawings have been prepared based on information provided by others. While this information is believed reliable, Chapman Technical Group, Ltd. cannot assure the accuracy, and/or completeness of this information, and thus shall not be responsible for any errors or omissions which may be incorporated herein as a result. Those relying on this record drawing document are advised to obtain independent verification of its accuracy before applying it for any purpose.

SEPTEMBER 2012

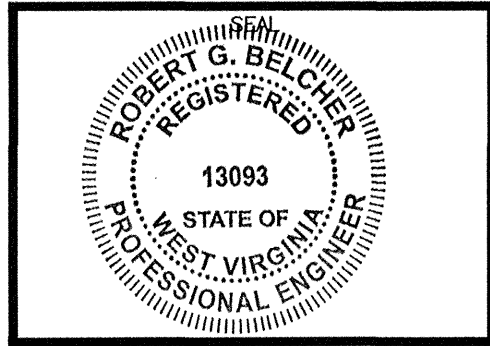

170 Aviation Way, Suite 102
Martinsburg, West Virginia 25405
(304)260-1222

JOB NUMBER:	08053	
SCALE:	NONE	
DATE:	JUNE 2010	
DRAWN BY:	LDA	
DESIGNED BY:	MJC	
CHECKED BY:	RGB	
SHEET NO.		REVISION
COVER		0