




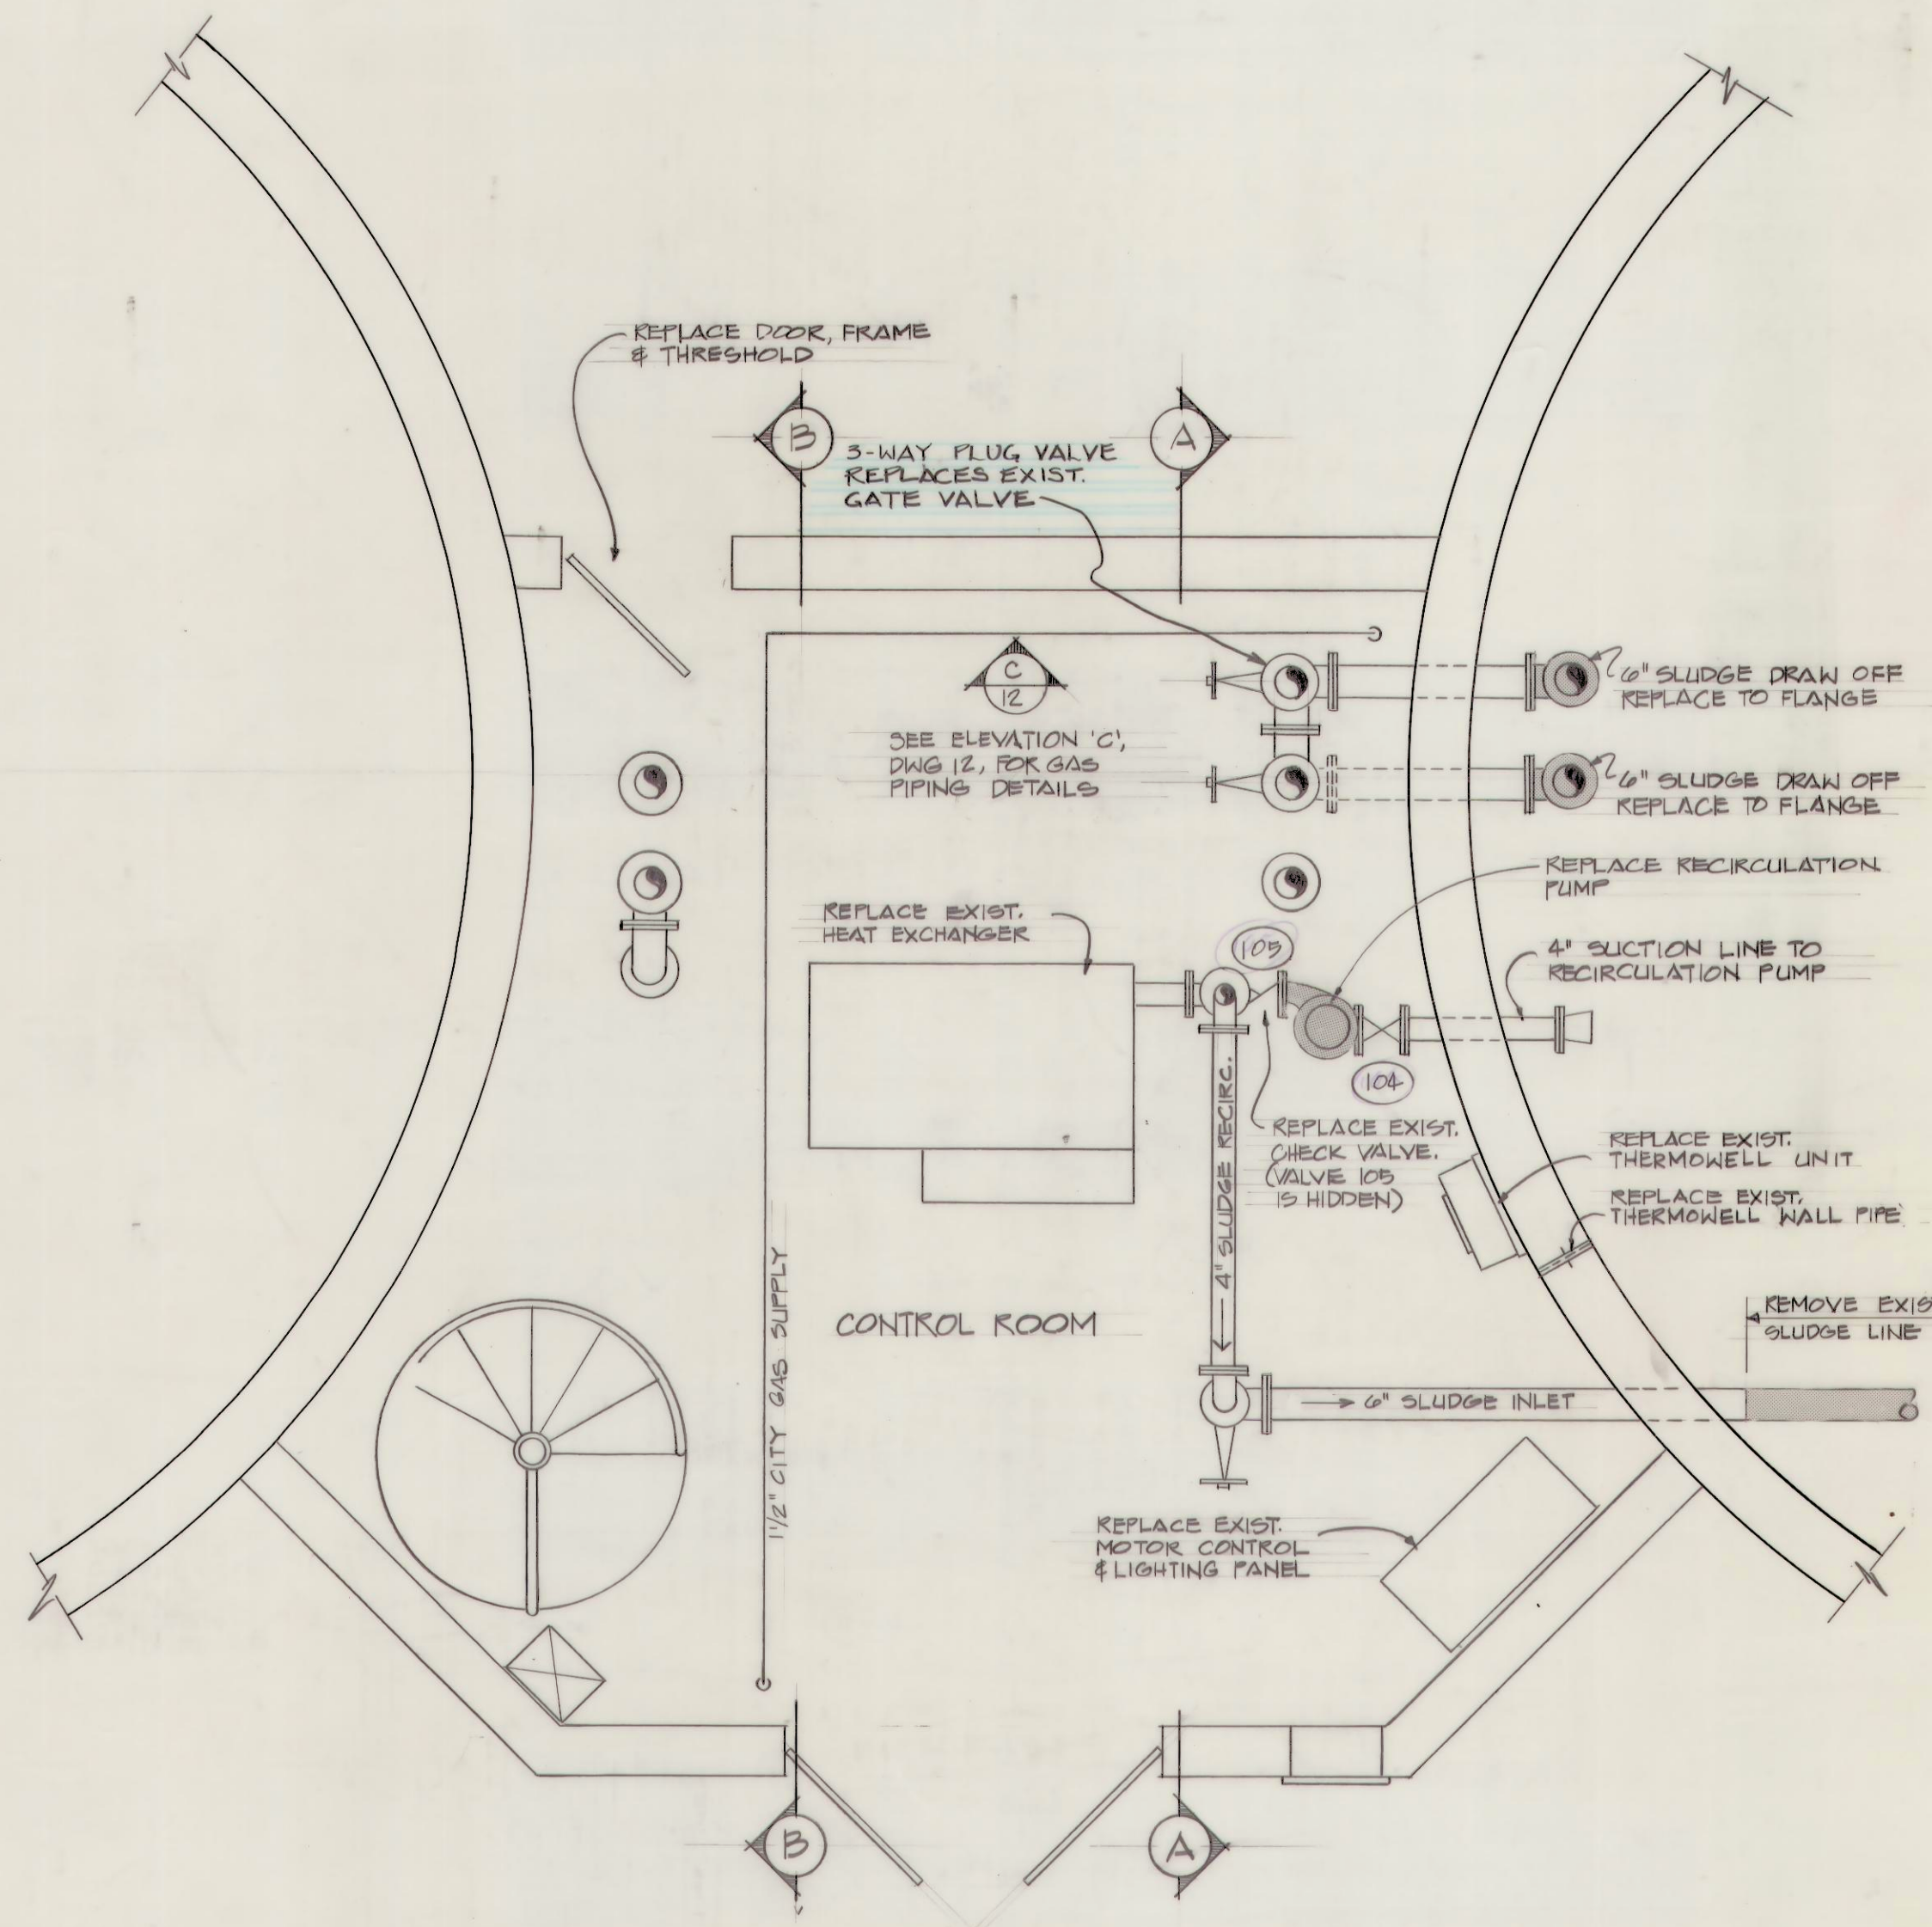

EXISTING UPPER LEVEL PLAN
 SCALE: 3/8" = 1'-0"

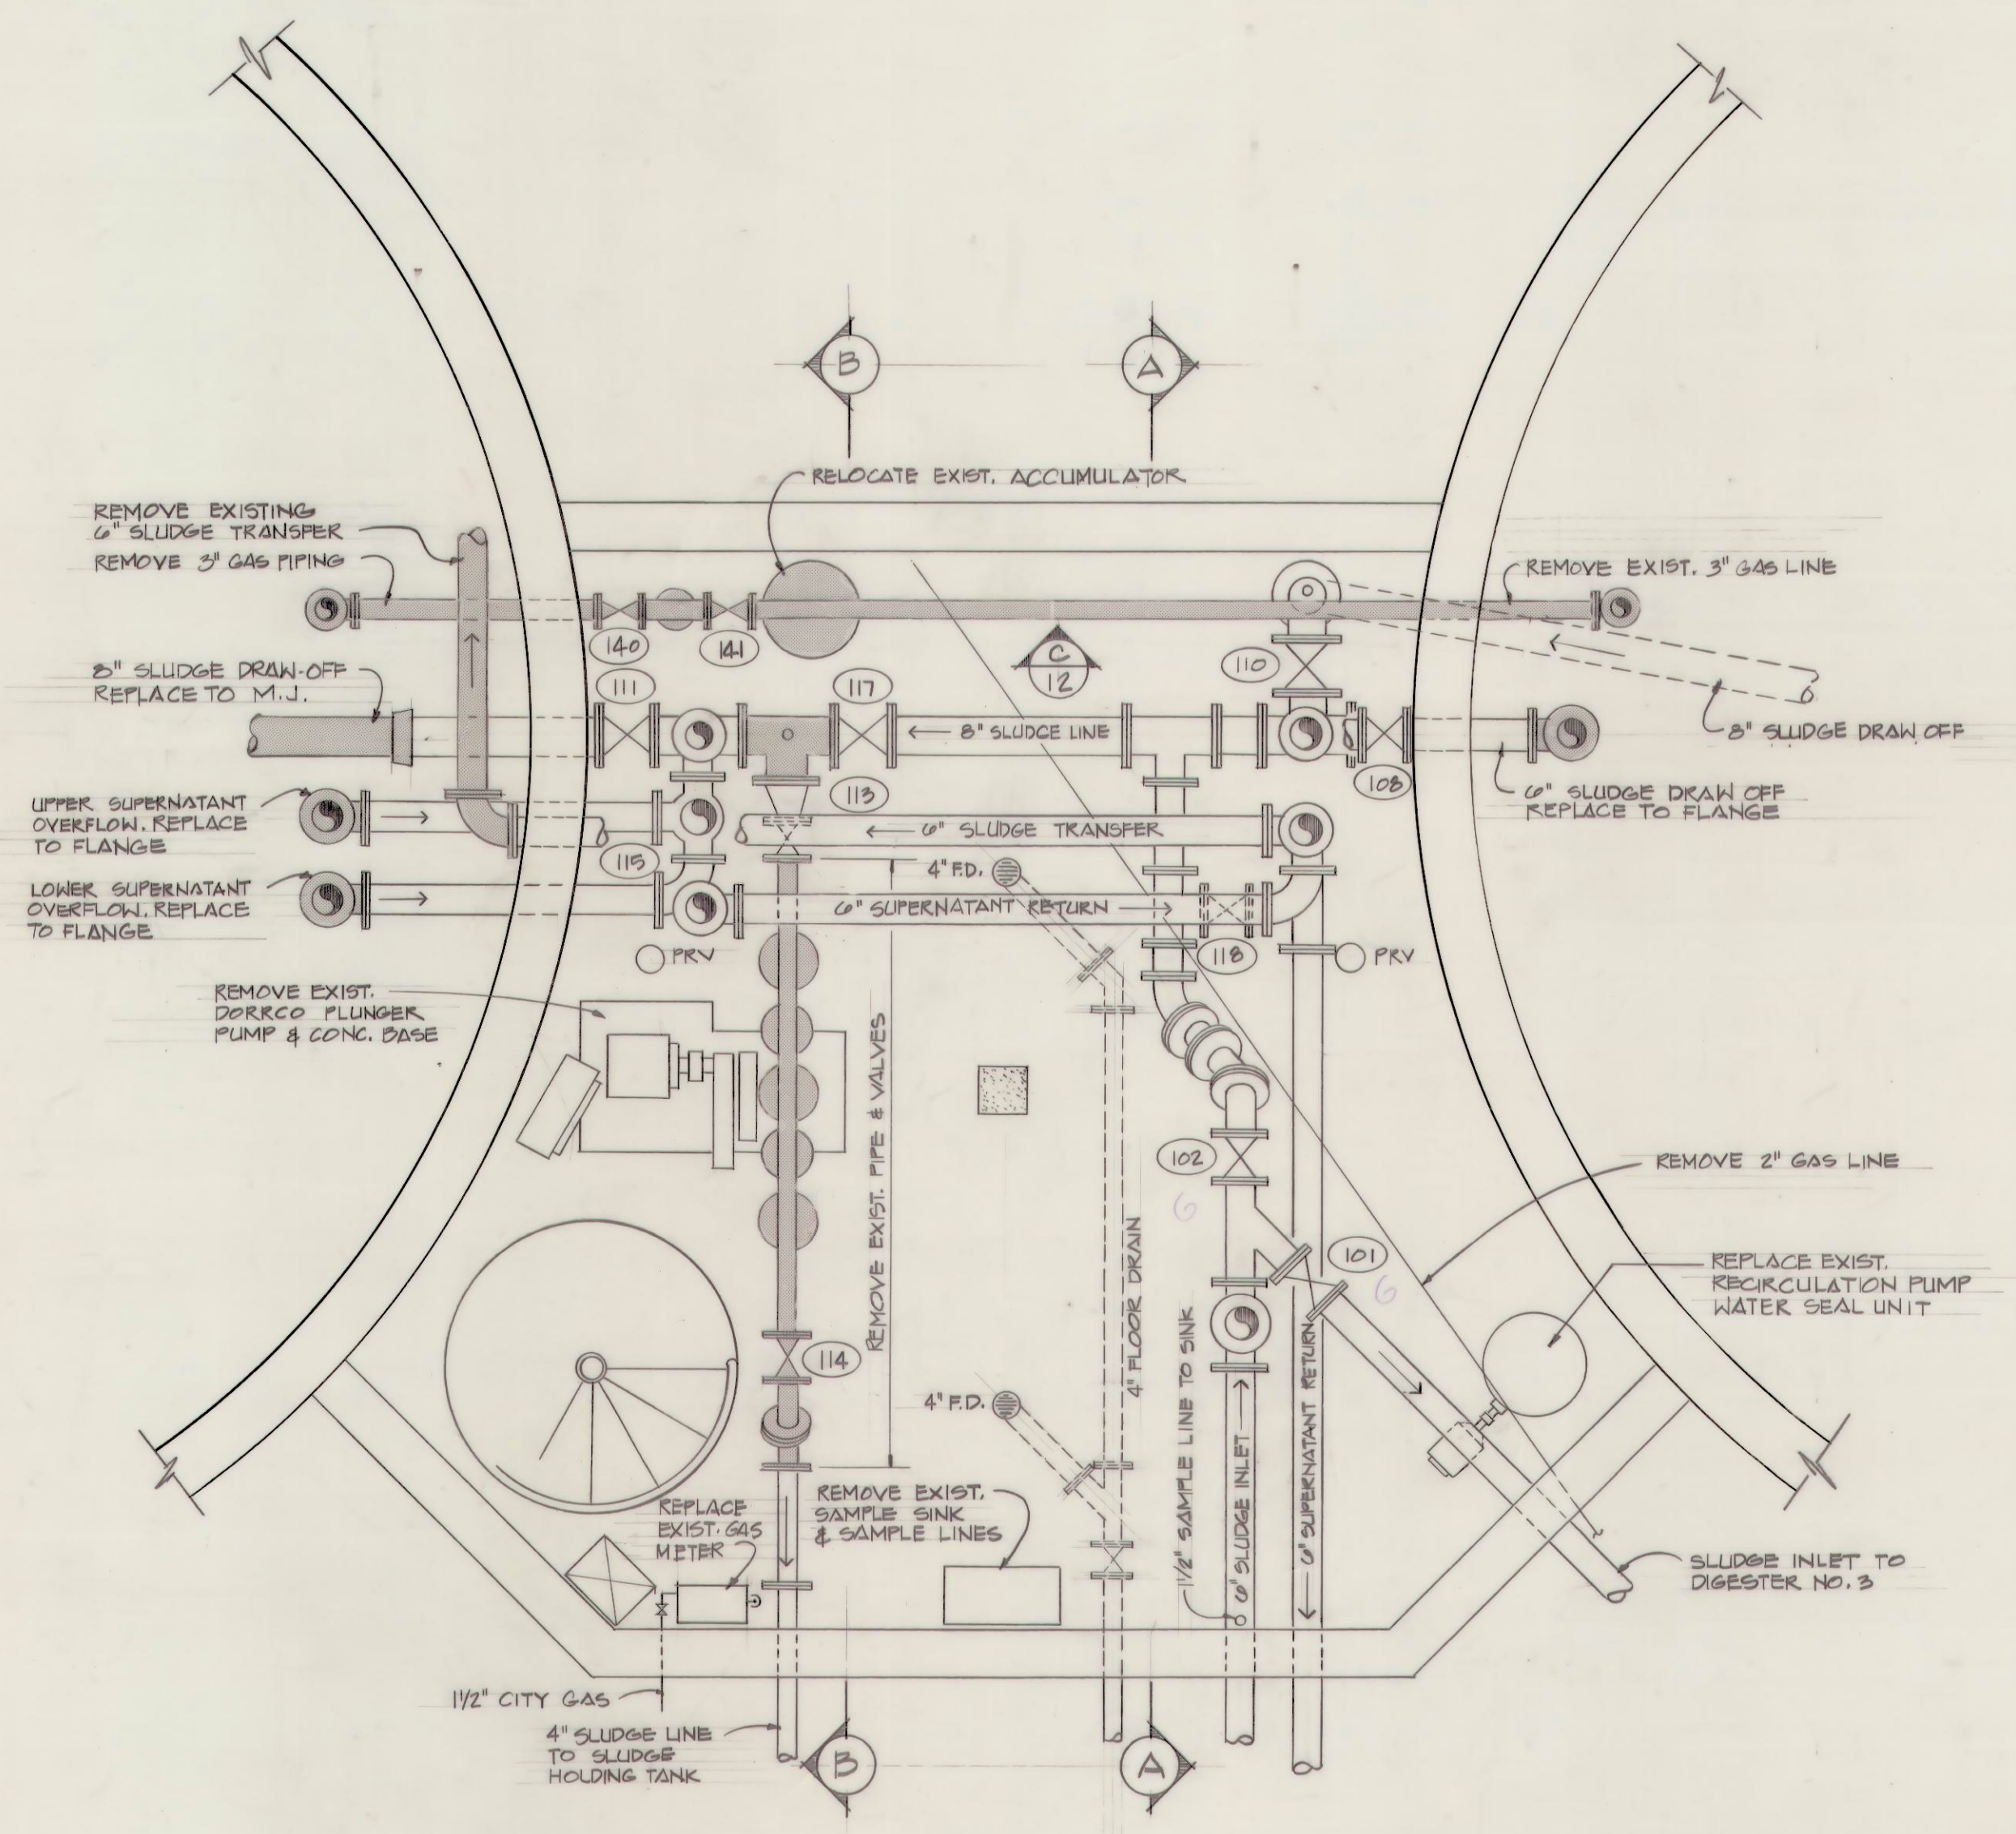


EXISTING LOWER LEVEL PLAN
 SCALE: 3/8" = 1'-0"

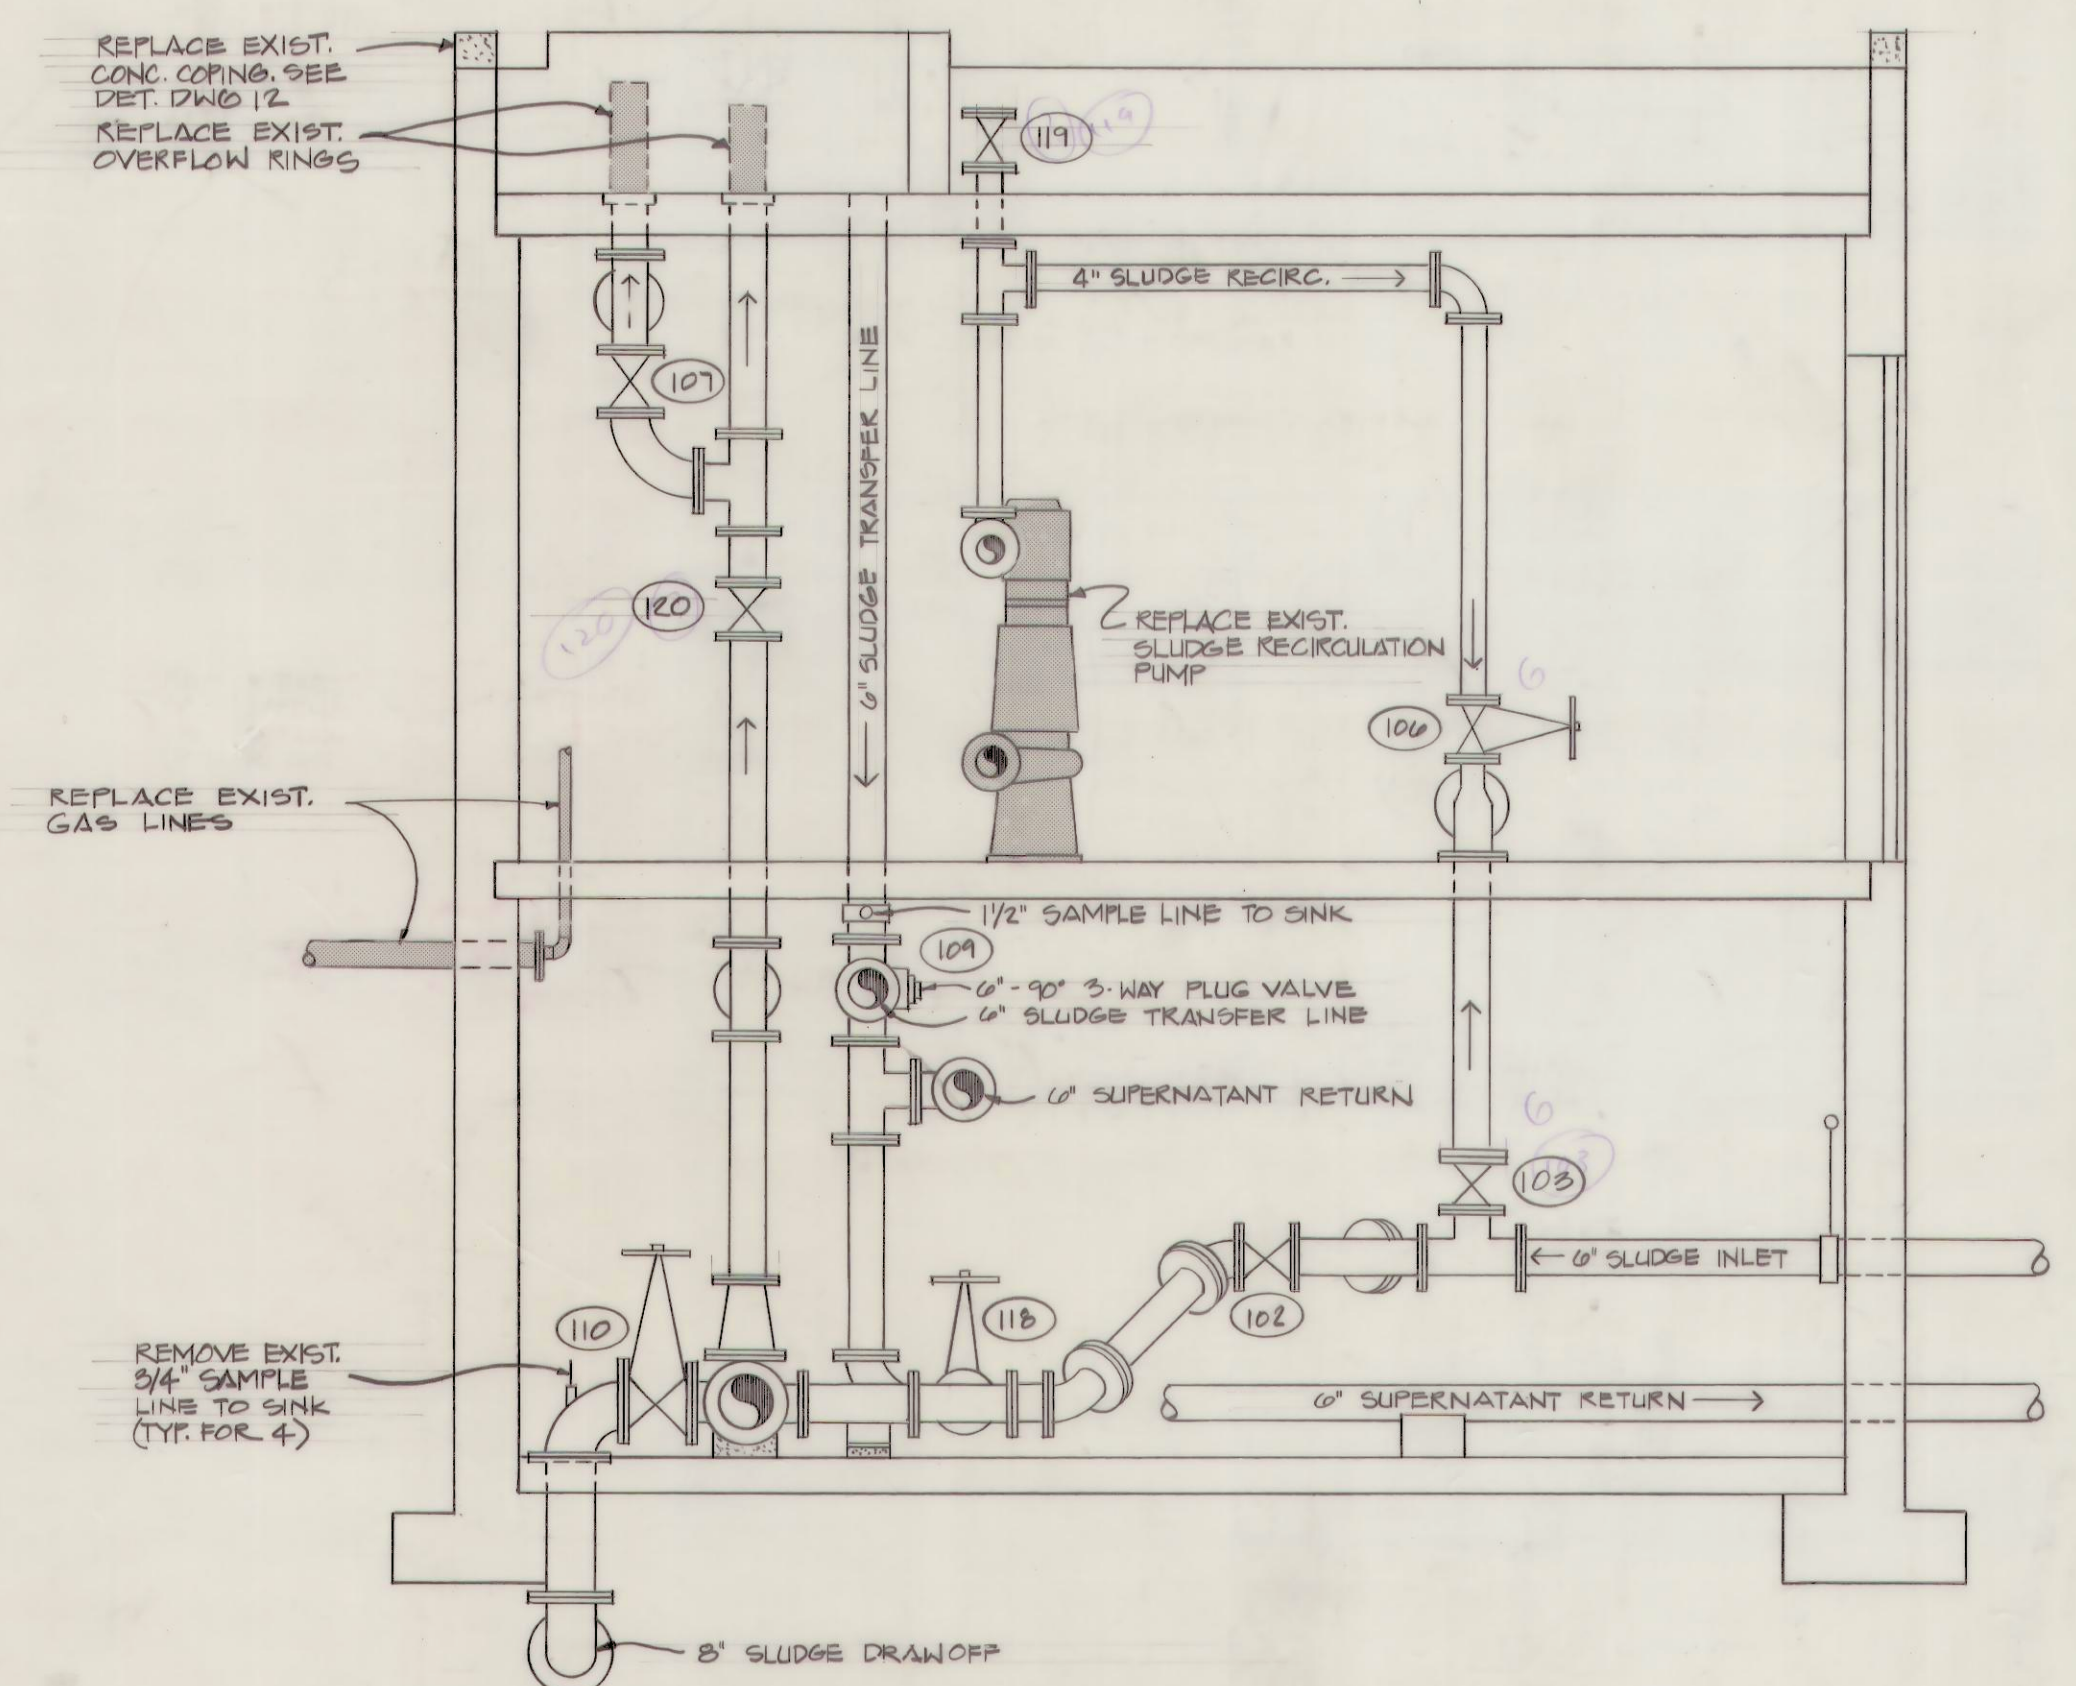


A EXISTING SECTION
 SCALE: 3/8" = 1'-0"

NOTE: ALL EXISTING PIPING TO REMAIN
 SHALL BE HIGH-PRESSURE
 CLEANED BY THE CONTRACTOR

VALVE SCHEDULE		
Valve No.	Existing Description	Required Action
101	6" Gate Valve	Replace with 6" Gate Valve
102	6" Gate Valve	Replace with 6" Gate Valve
103	6" Gate Valve	Replace with 6" Gate Valve
104	4" Gate Valve	Replace with 4" Plug Valve
105	4" Gate Valve	Replace with 4" Plug Valve
106	4" Gate Valve	Replace with 4" Gate Valve
107	6" Gate Valve	Replace with 6" Plug Valve
108	6" Gate Valve	Replace with 6" Plug Valve
109	6" 90° 3-way Plug Valve	Replace with 6" 90° 3-way Plug Valve
110	8" Gate Valve	Replace with 8" Plug Valve
111	8" Gate Valve	Replace with 8" Plug Valve
112	4" Gate Valve	Replace with 4" Plug Valve
113	4" Gate Valve	Replace with 4" Plug Valve
114	6" 90° 3-way Plug Valve	Replace with 6" 90° 3-way Plug Valve
115	6" Gate Valve	Replace with 6" Plug Valve
116	8" Gate Valve	Replace with 8" Plug Valve
117	8" Gate Valve	Replace with 8" Plug Valve
118	6" Gate Valve	Replace with 6" Plug Valve
119	4" Gate Valve	Replace with 4" Plug Valve
120	6" Gate Valve	Replace with 6" Plug Valve
140	3" Plug Valve	Replace with 3" Plug Valve
141	3" Plug Valve	Replace with 3" Plug Valve

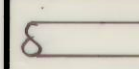LEGEND	
	EXIST. PIPE TO REMAIN
	EXIST. PIPE TO BE REMOVED

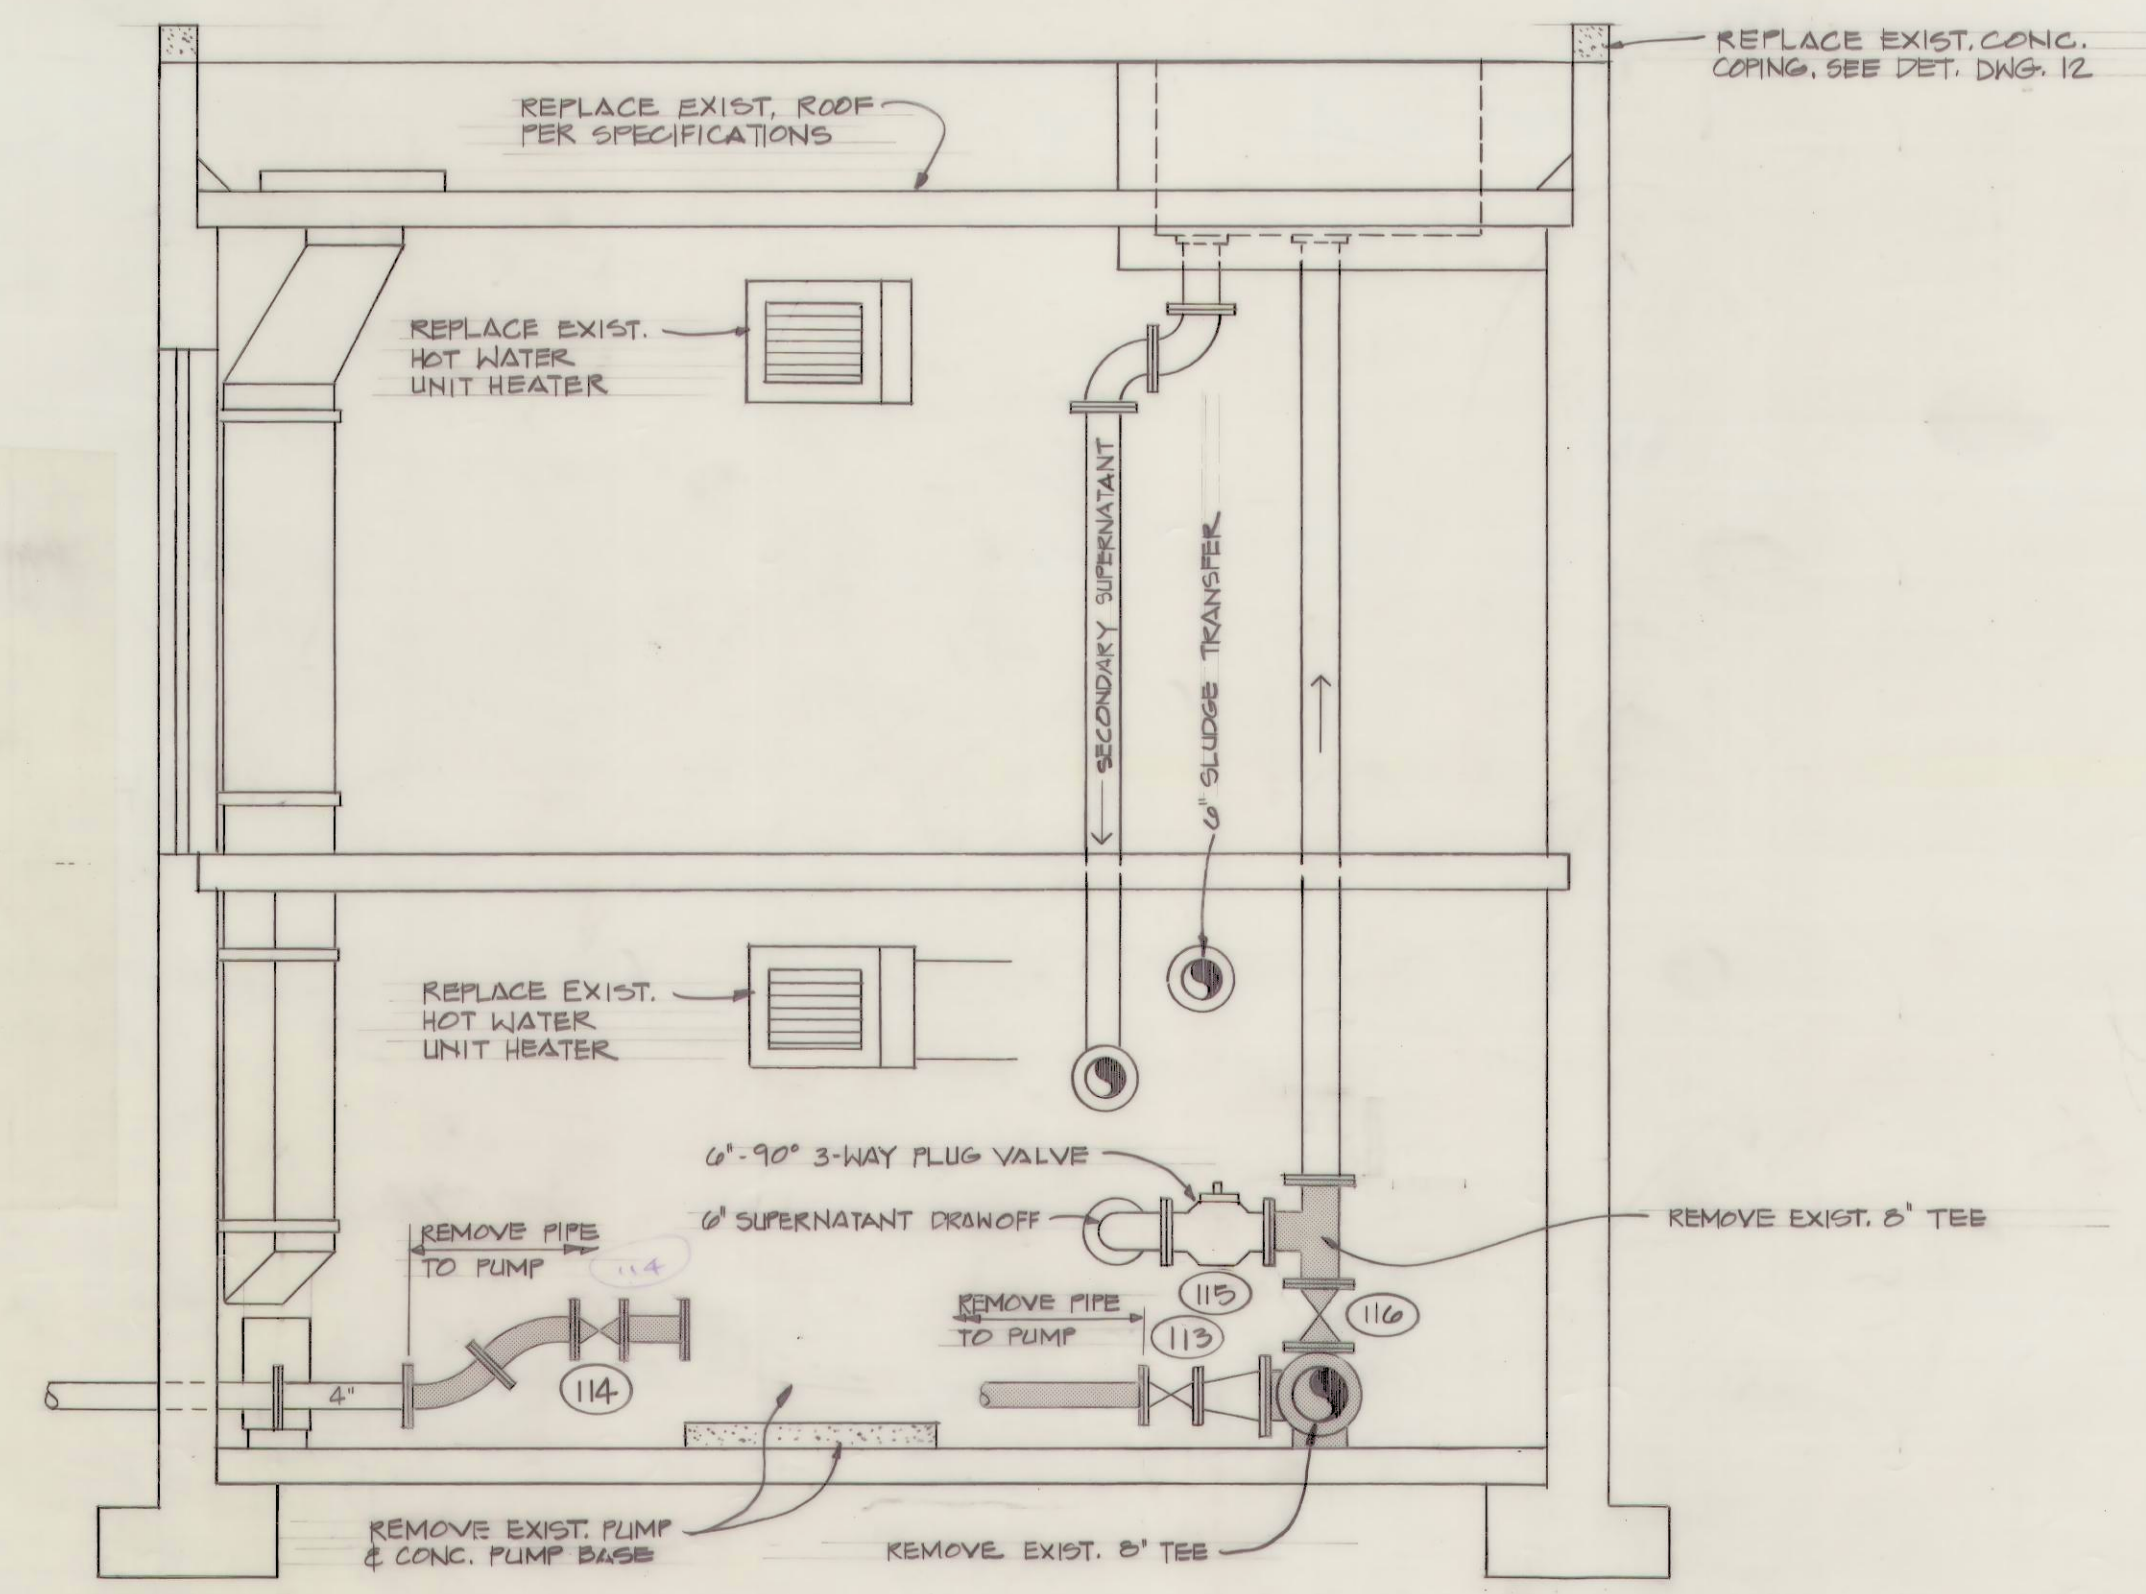

B EXISTING SECTION
 SCALE: 3/8" = 1'-0"