




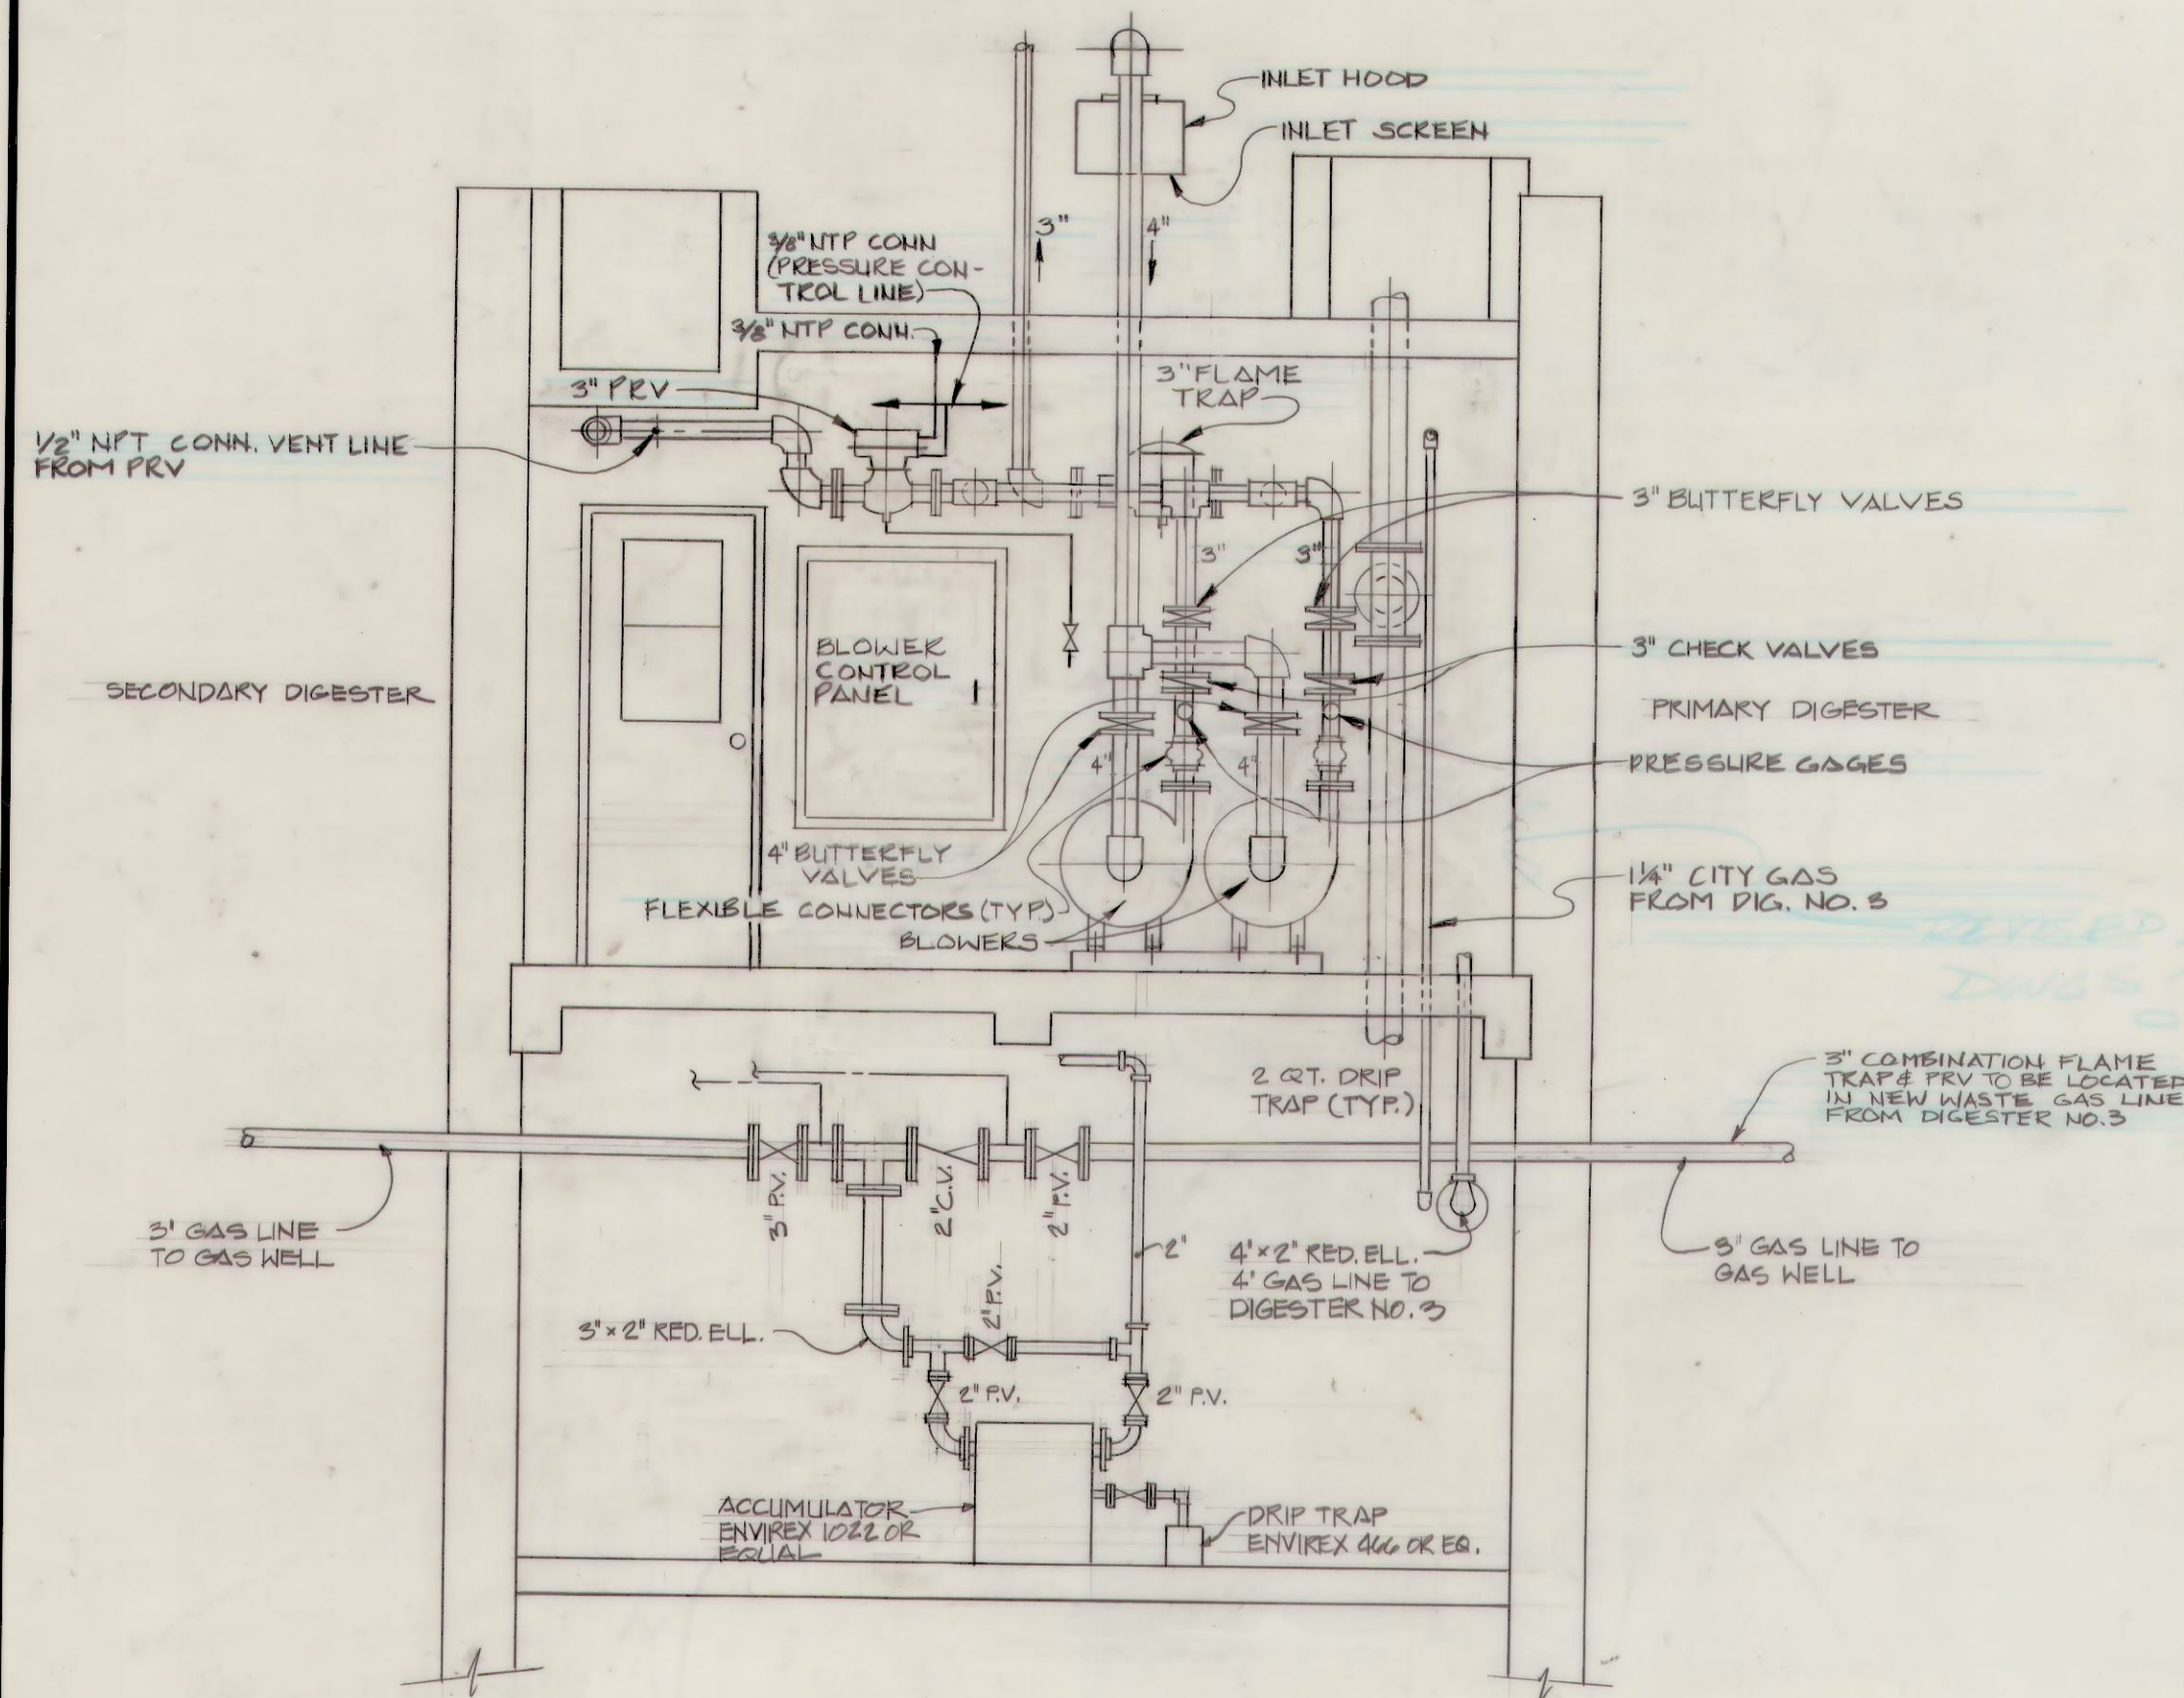

C SECTION
SCALE: 3/8" = 1'-0"

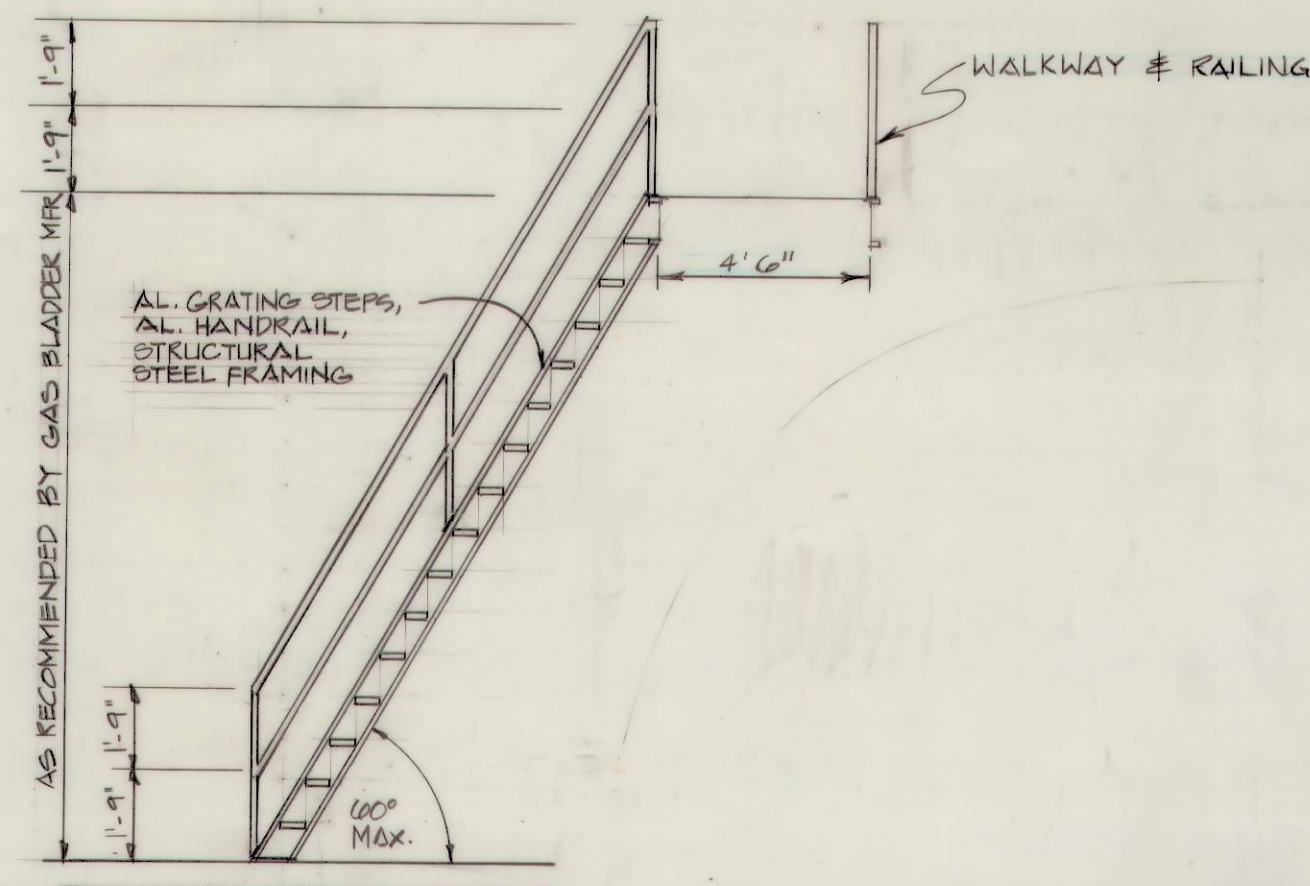


B SECTION THRU ACCESS STAIRS
SCALE: 1/4" = 1'-0"

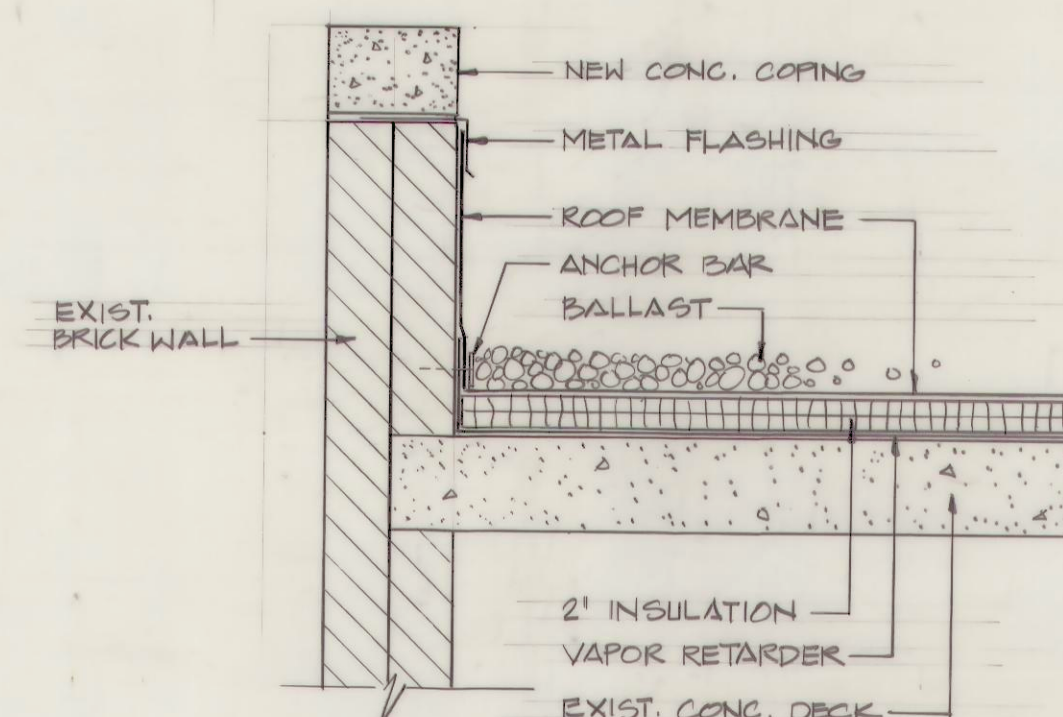


NOTE: EXISTING BUILT-UP ROOF IS TO BE REMOVED COMPLETELY PRIOR TO INSTALLATION OF NEW ROOF

4 DIGESTER ROOF DETAIL
SCALE: 1" = 1'-0"

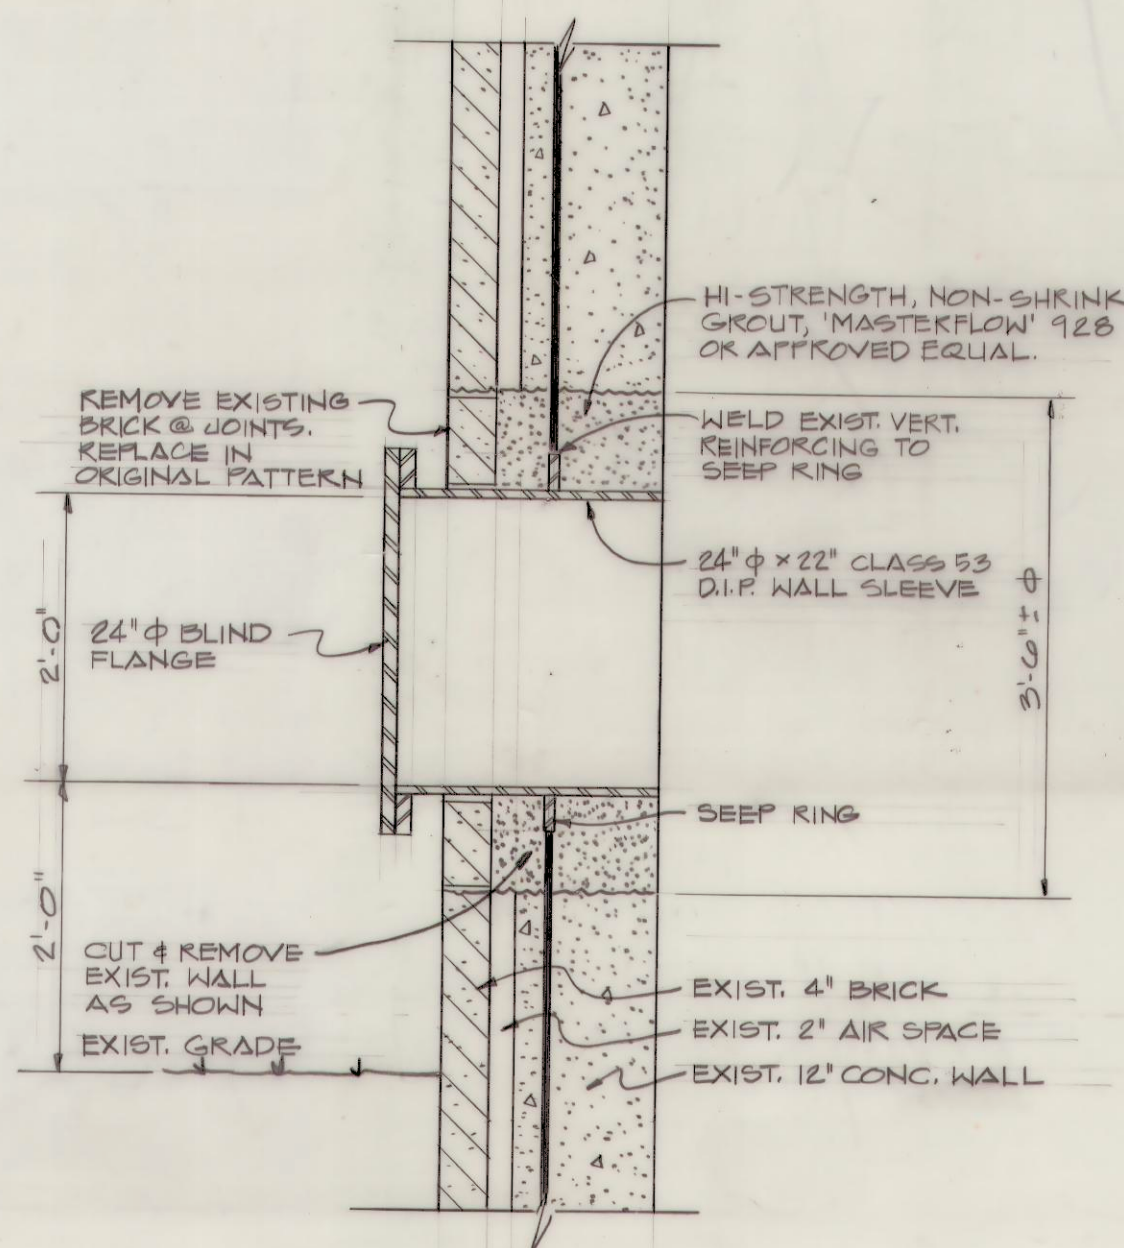


NOTE: TWO NEW MANWAYS ARE REQUIRED, SEE DWG. 9 FOR LOCATION.

3 DIGESTER MANWAY DETAIL
SCALE: 3/4" = 1'-0"

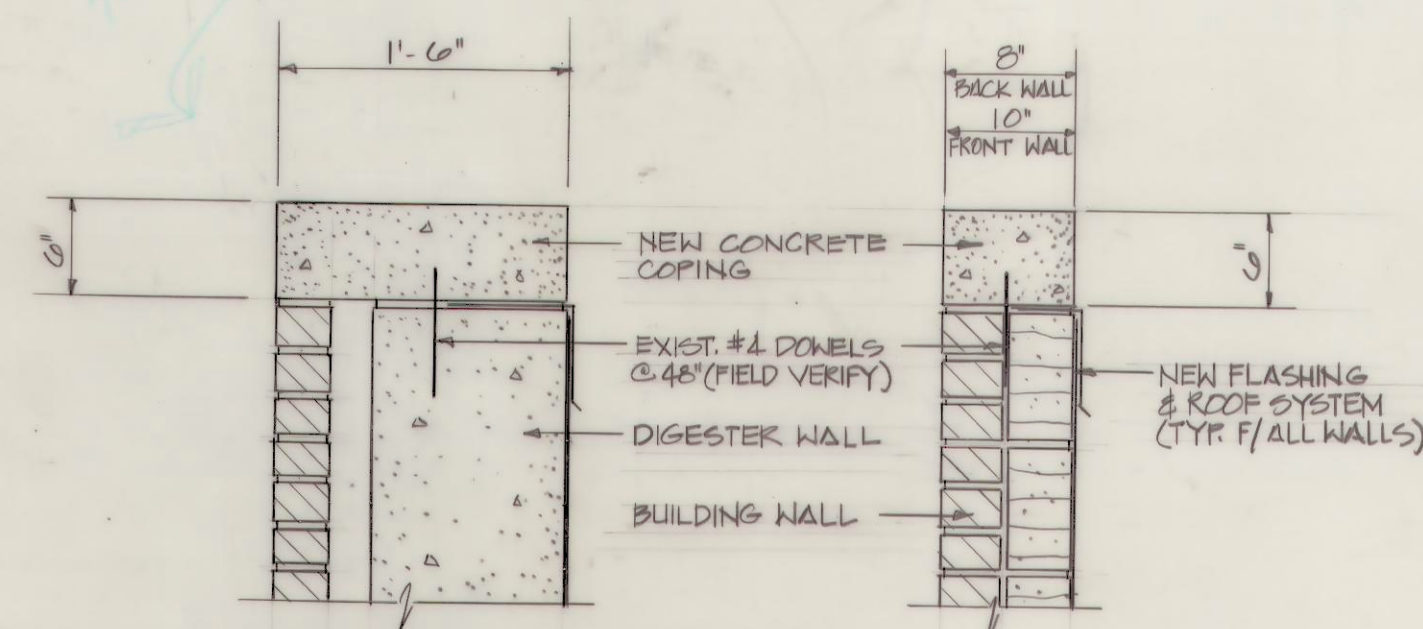

NEW CONCRETE COPING DETAIL
SCALE: 1" = 1'-0"

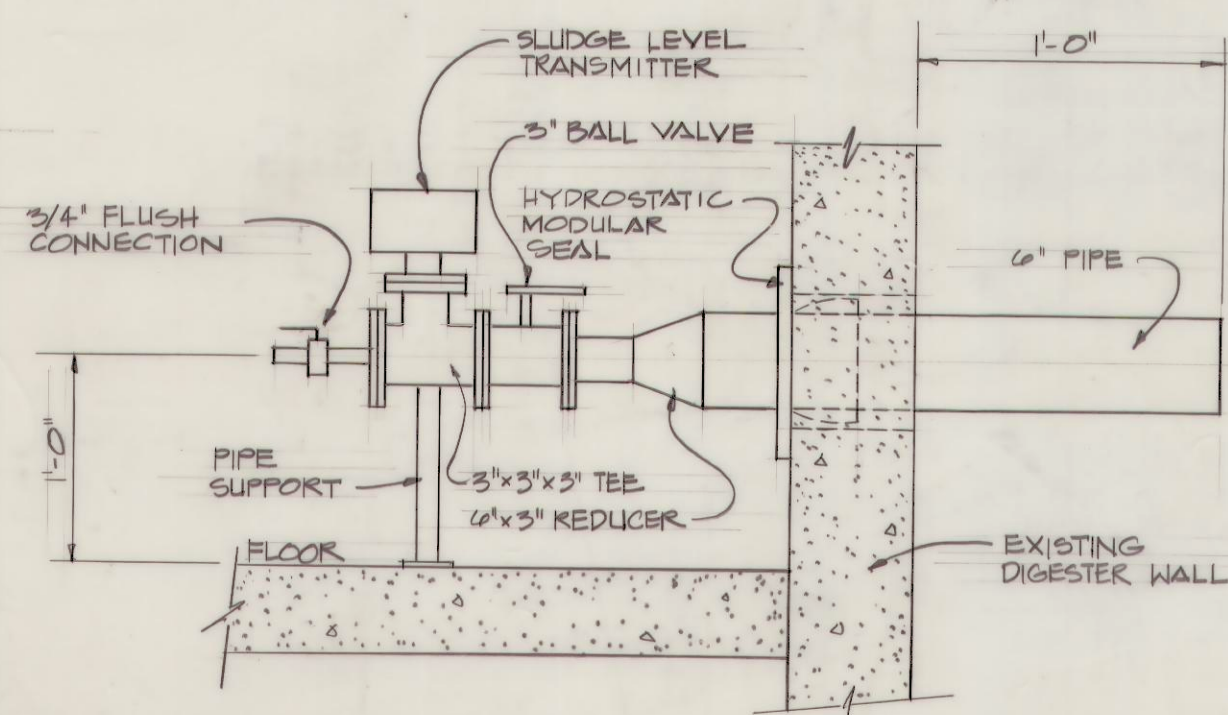

LIQUID LEVEL INDICATOR DETAIL
SCALE: NONE (BY GAS SYSTEM MFR.)



PROJECT INFORMATION
CITY OF ST. ALBANS
MUNICIPAL UTILITY COMMISSION
KANAWHA COUNTY, WEST VIRGINIA
WASTEWATER SYSTEM IMPROVEMENTS
EPA PROJECT NO. C-540618-01

CONTRACT NO. 1



Chapman Technical Group

DRAWING TITLE

PRIMARY & SECONDARY DIGESTERS
MISCELLANEOUS DETAILS & SECTIONS

DRAWN: JEB
CHECKED: RSB
DATE: OCTOBER, 1989
SCALE: AS NOTED
PROJECT NUMBER: S7016
DRAWING NUMBER:

12