




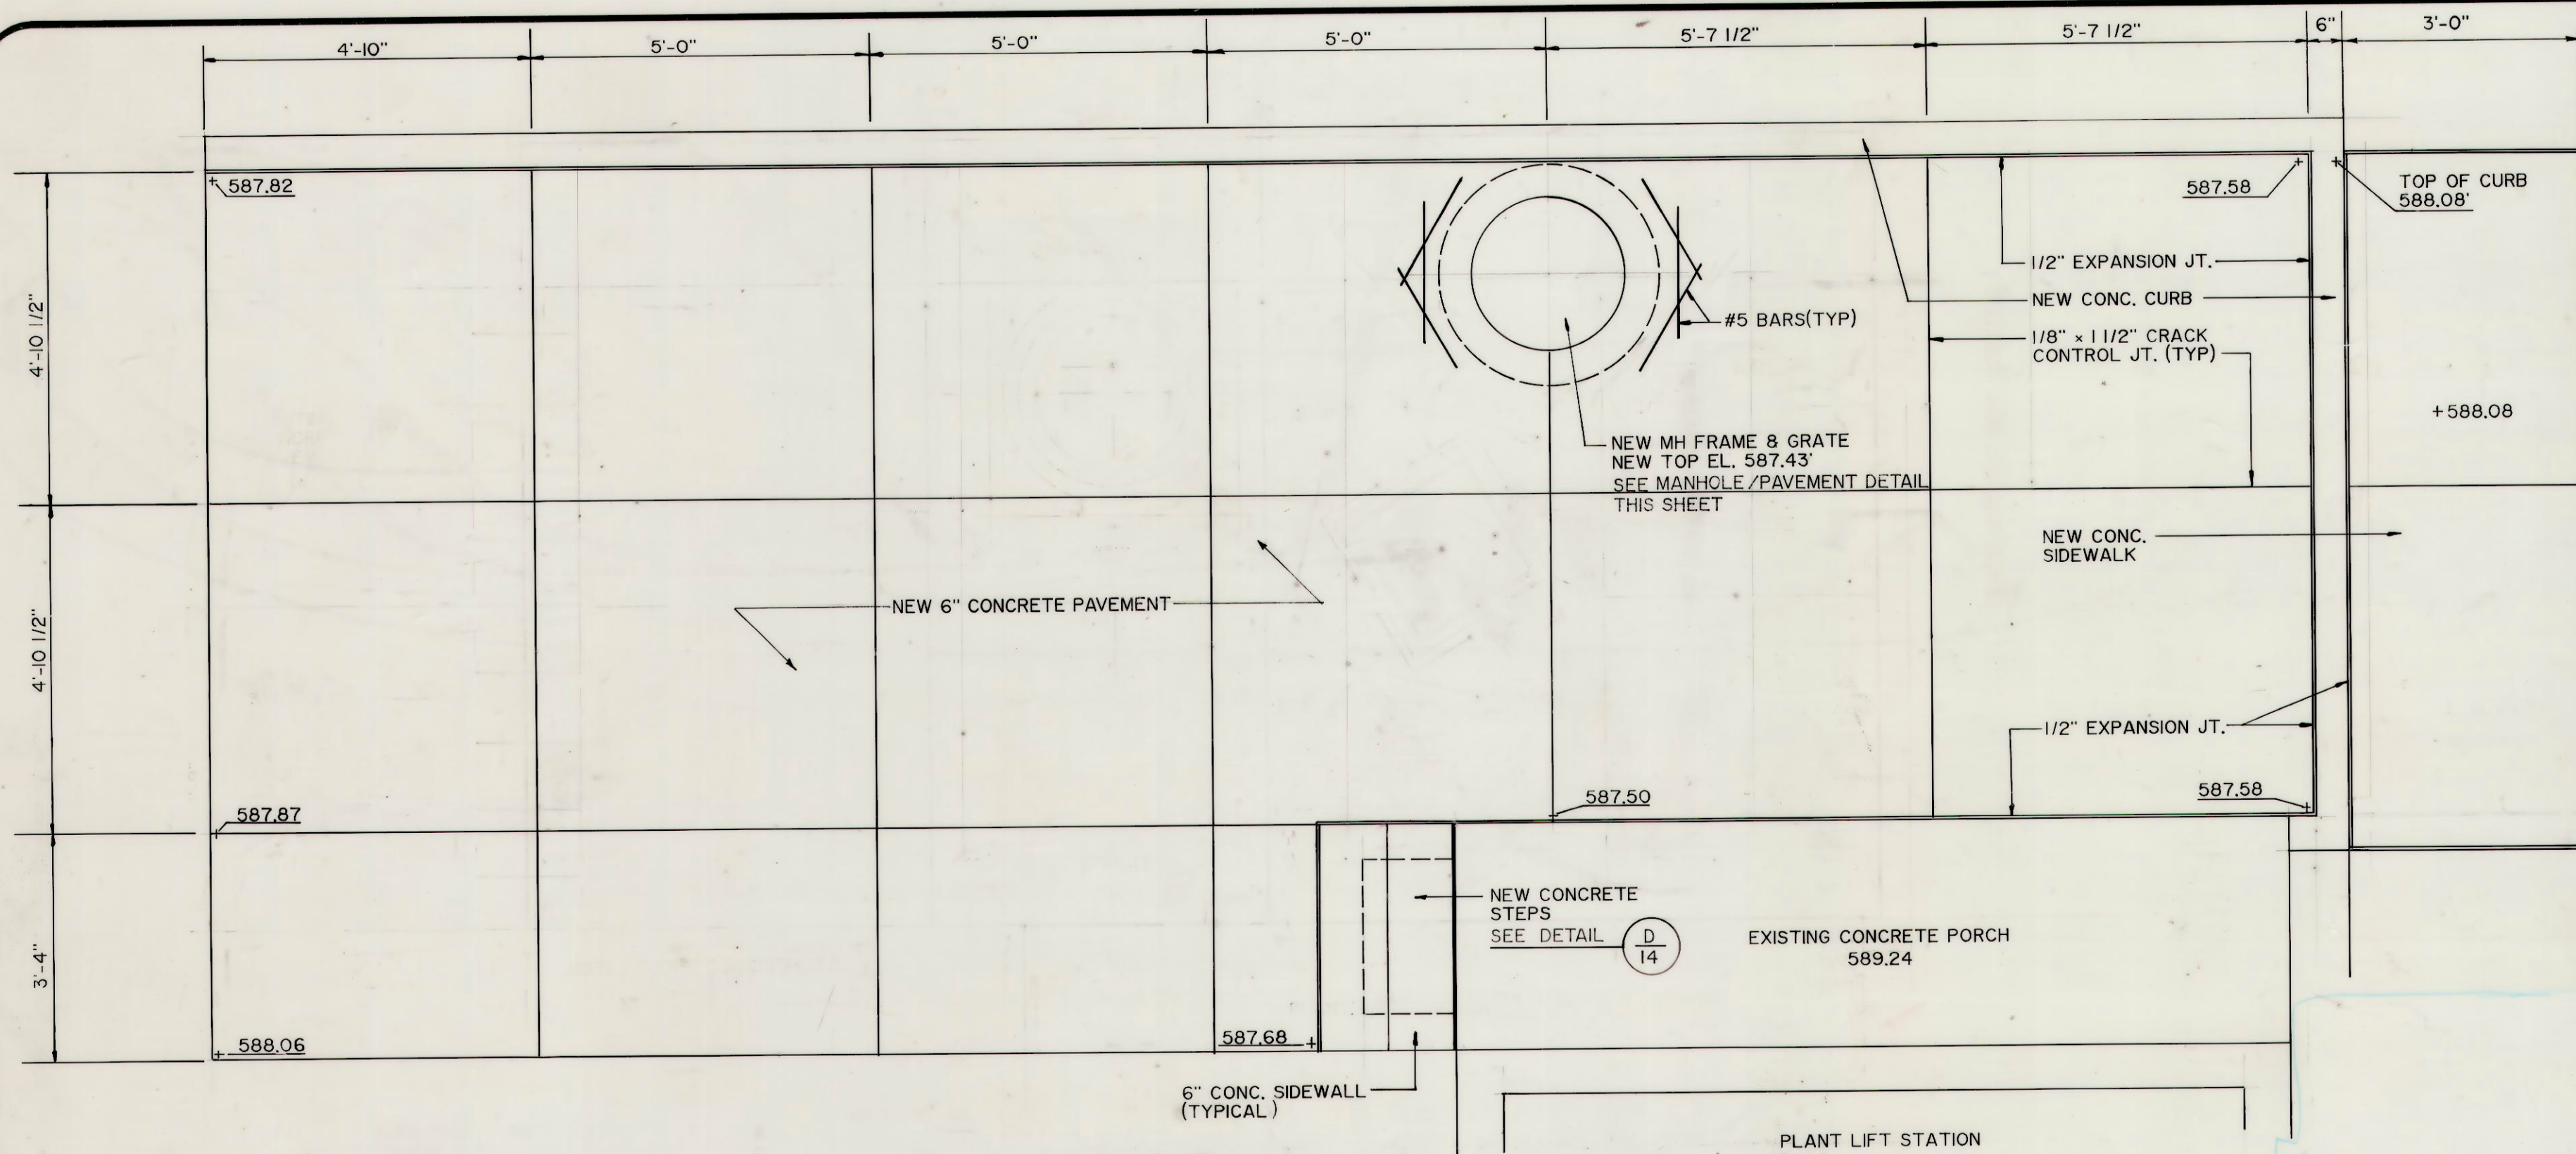


CONCRETE PAVEMENT PLAN
SCALE: 1/2" = 1'-0"

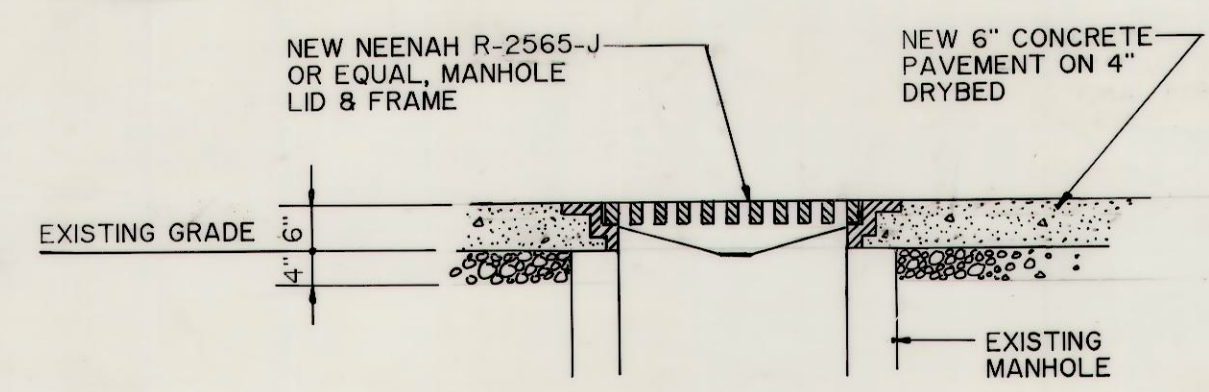


MANHOLE/PAVEMENT DETAIL
SCALE: 1/2" = 1'-0"

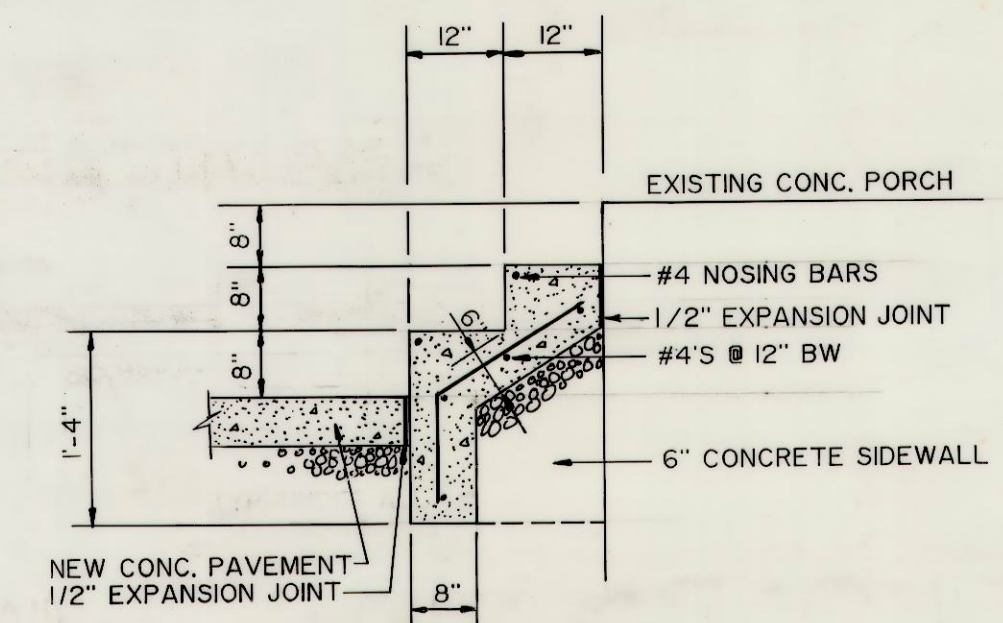


SECTION @ NEW STEPS
SCALE: 1/2" = 1'-0"

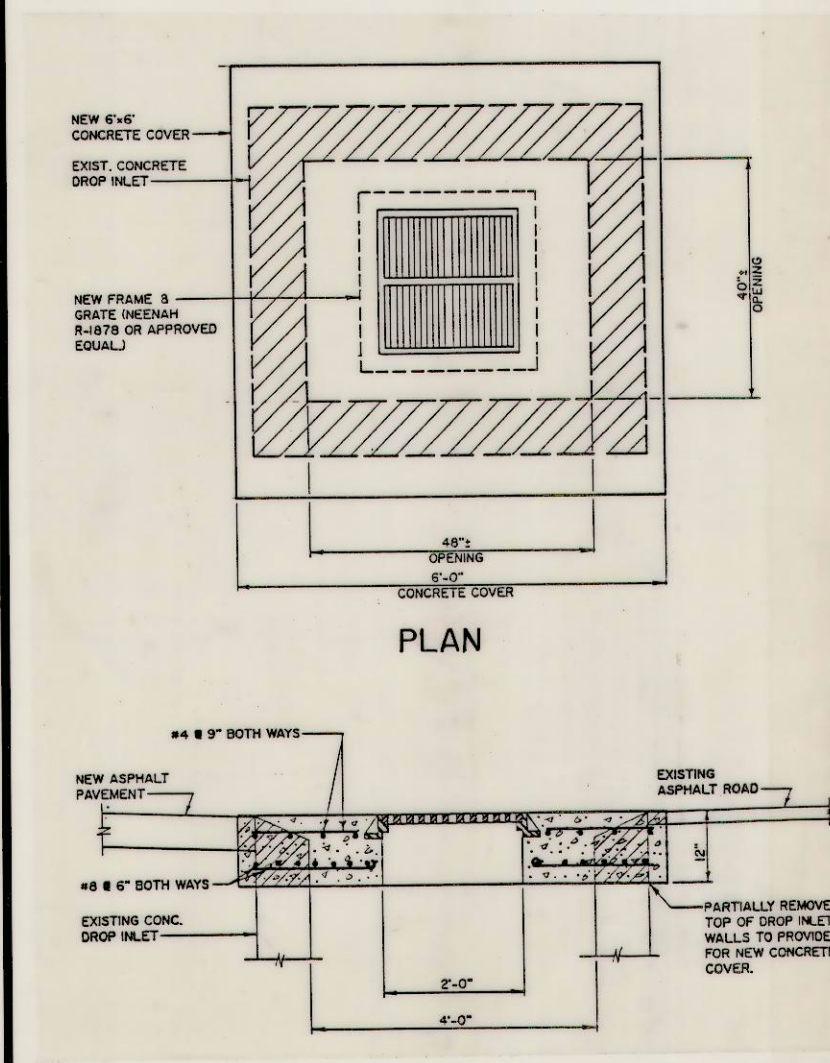


DROP INLET COVER DETAIL
SCALE: NONE

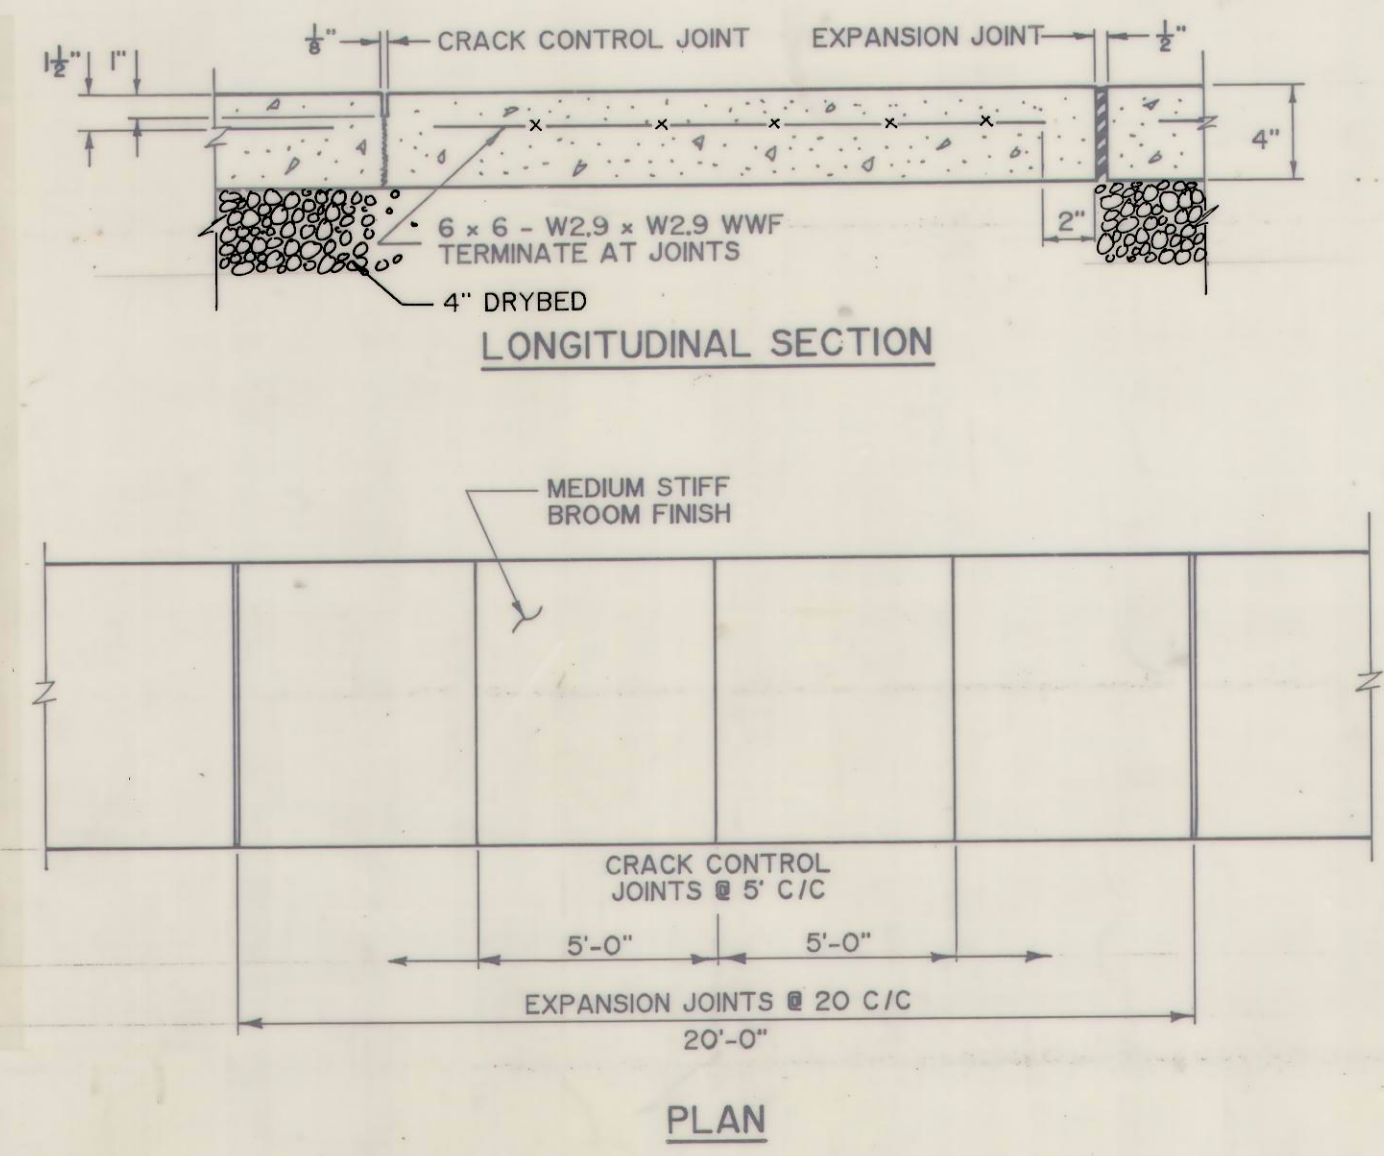

CONCRETE SIDEWALK DETAILS
SCALE: NONE

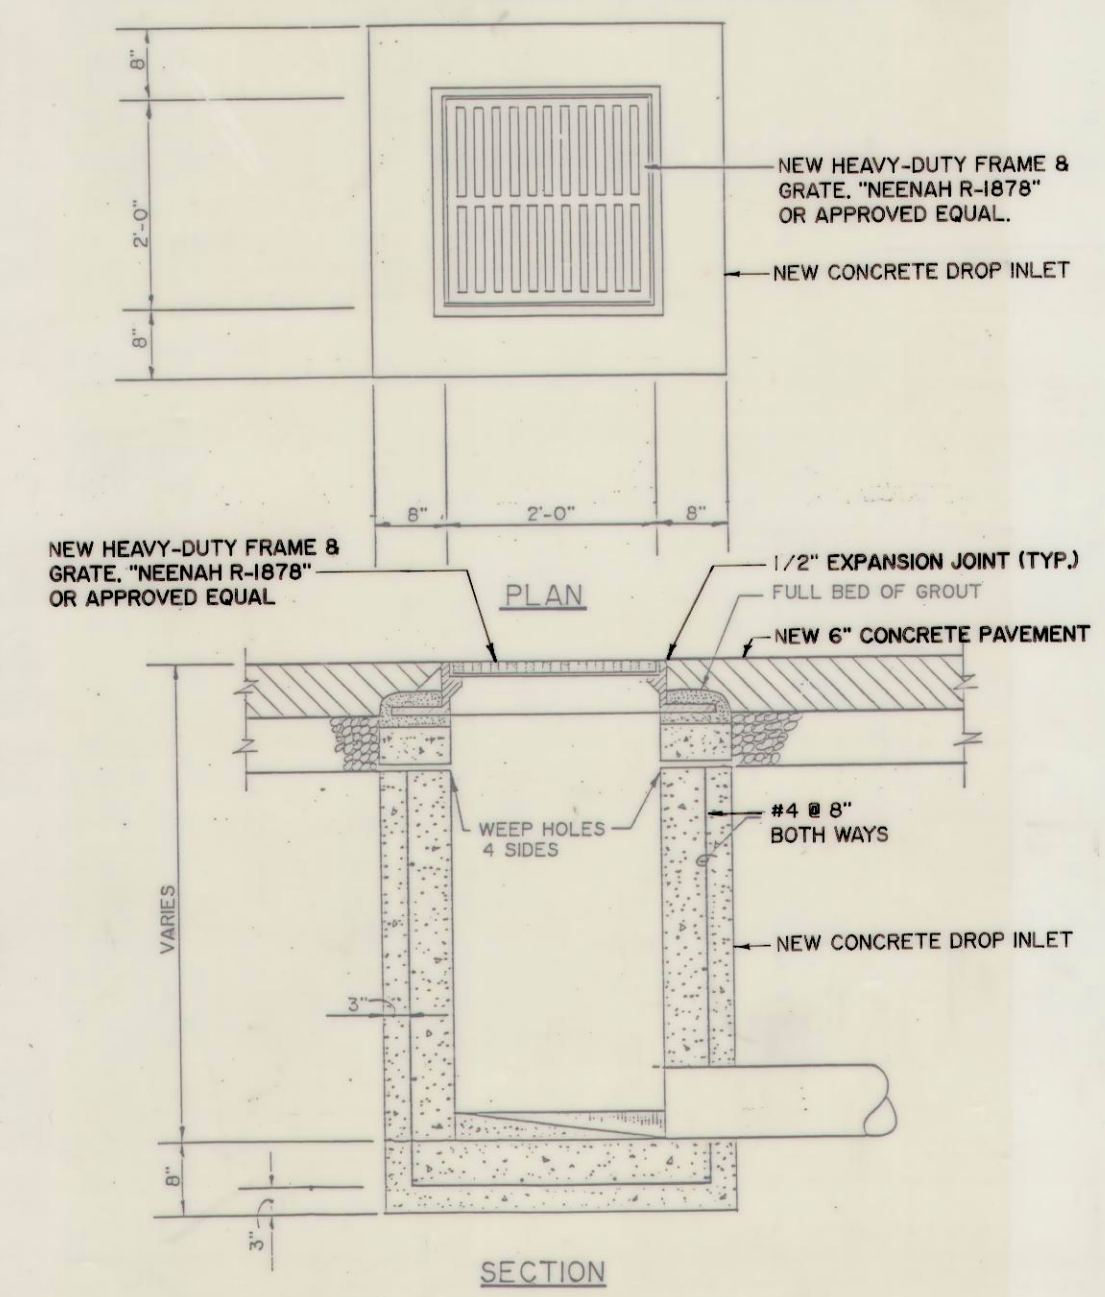


DROP INLET DETAIL
SCALE: NONE

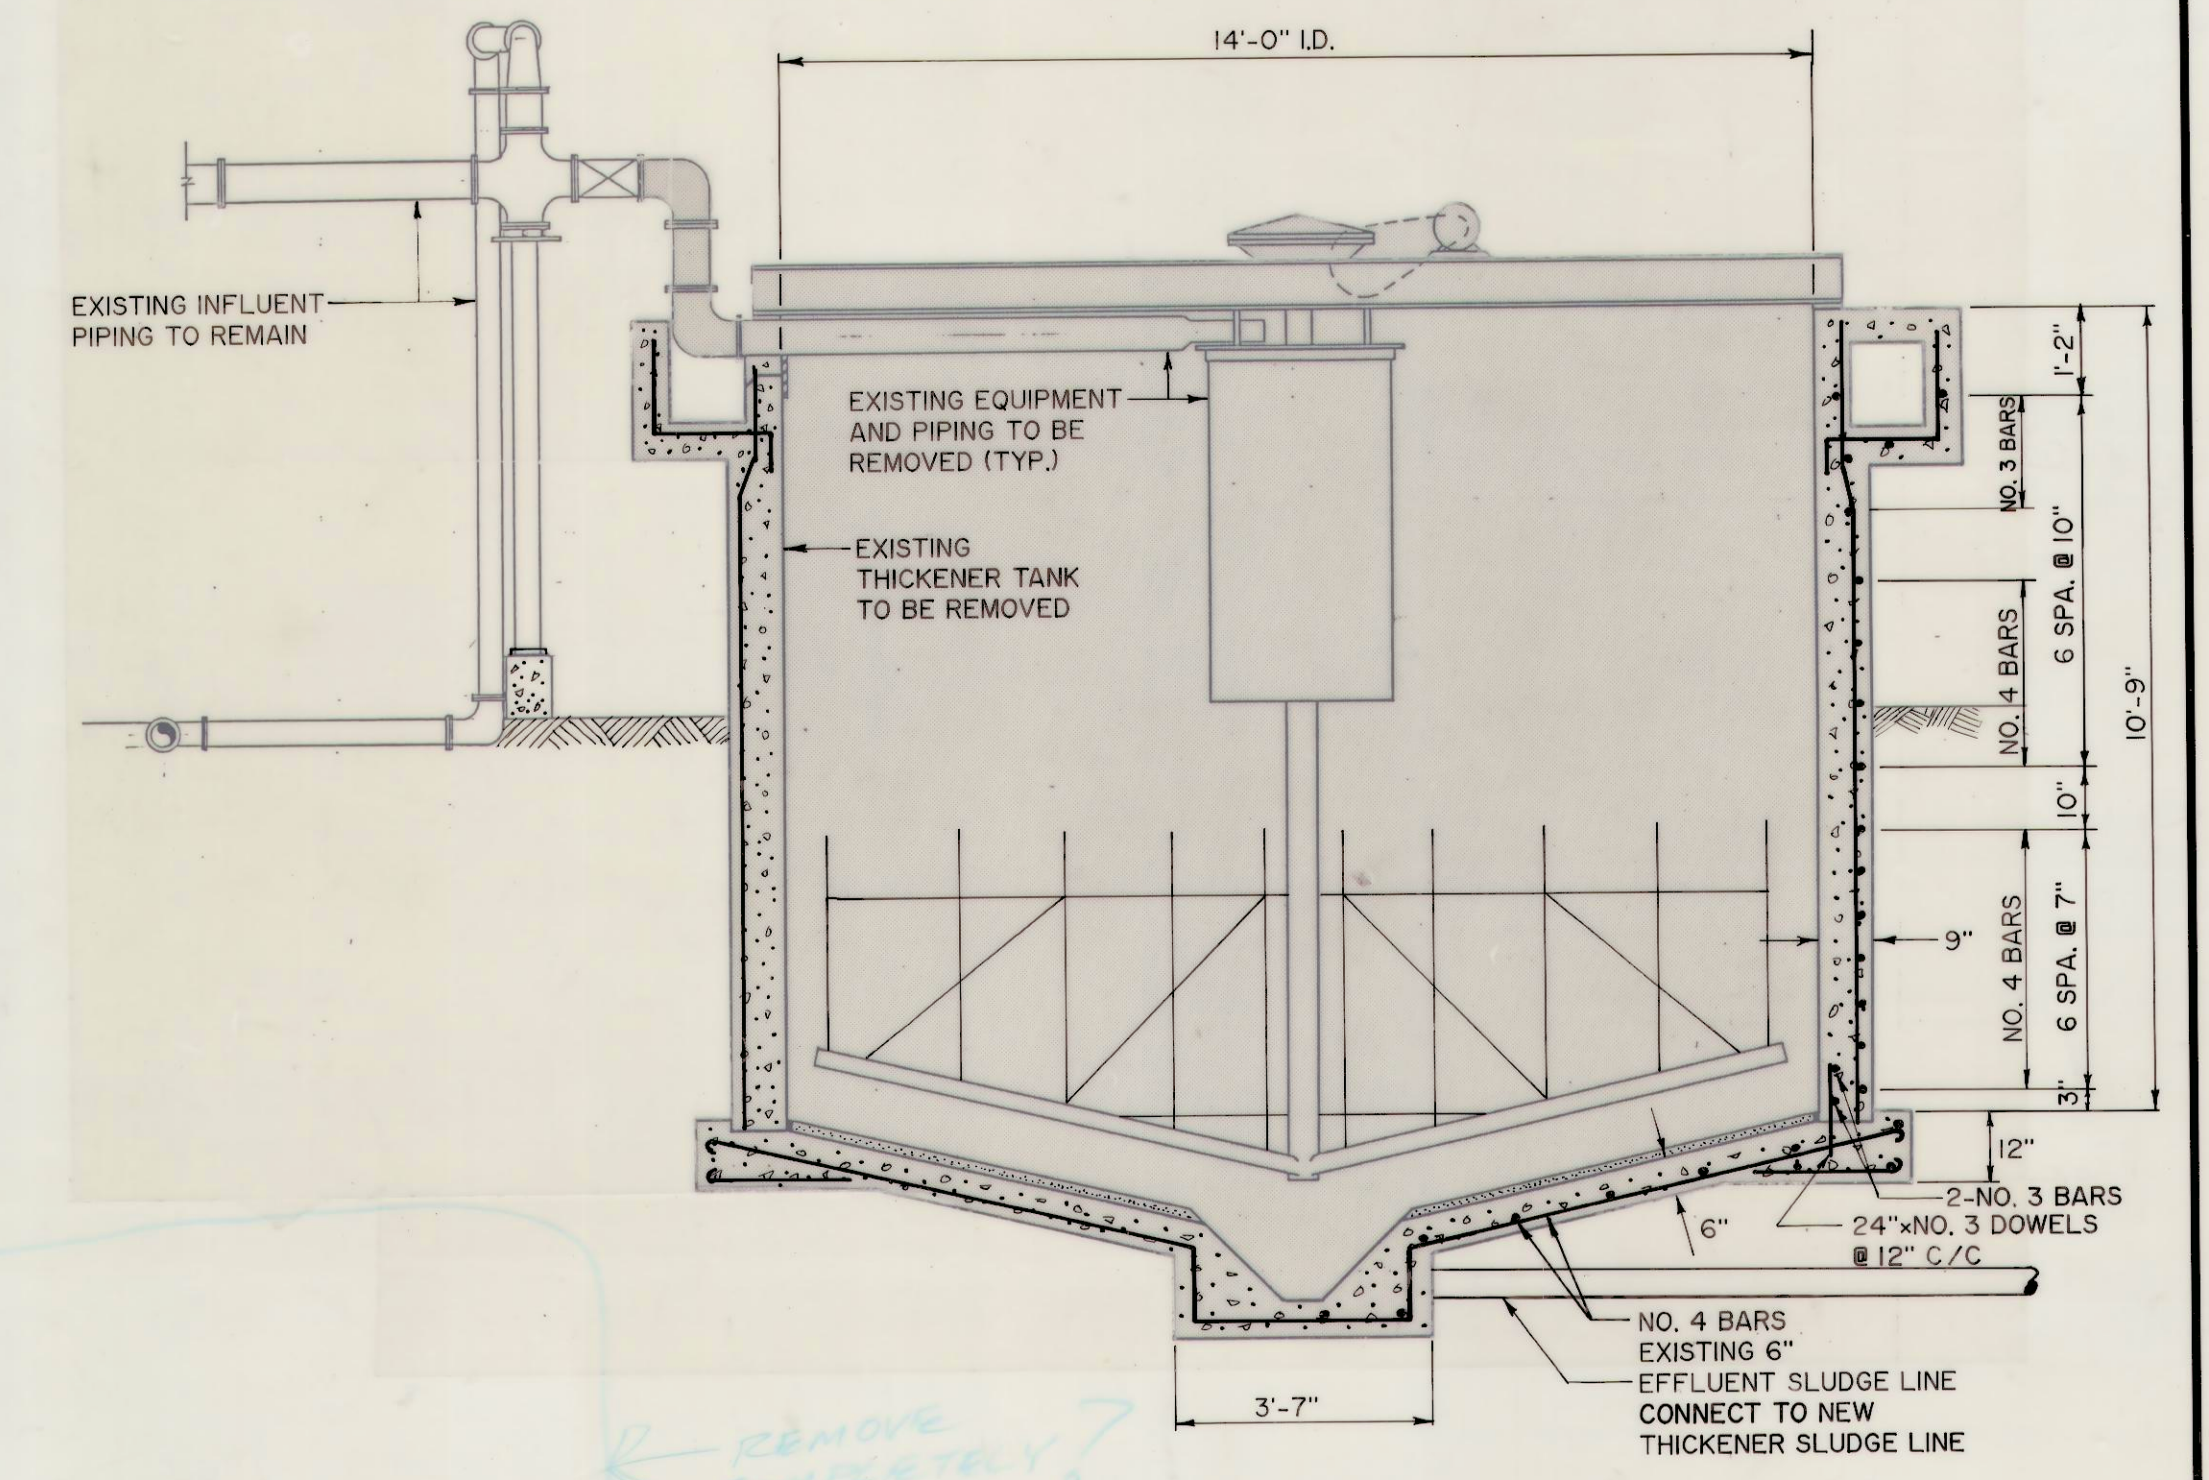

EXISTING SLUDGE THICKENER DEMOLITION PLAN
SCALE: NONE (THIS VIEW IS SCHEMATIC AND DOES NOT SHOW PROPER ORIENTATION OF EQUIPMENT IN ALL CASES.)

- NOTES:**
- EXISTING THICKENER AND MECHANICAL EQUIPMENT TO BE REMOVED
 - NEW CONCRETE PAVEMENT @ THICKENERS
 - NOTE: PAVEMENT JOINTS EQUAL TO OR GREATER THAN 1/4" SHALL BE SEALED IN ACCORDANCE WITH THE SPECIFICATIONS.

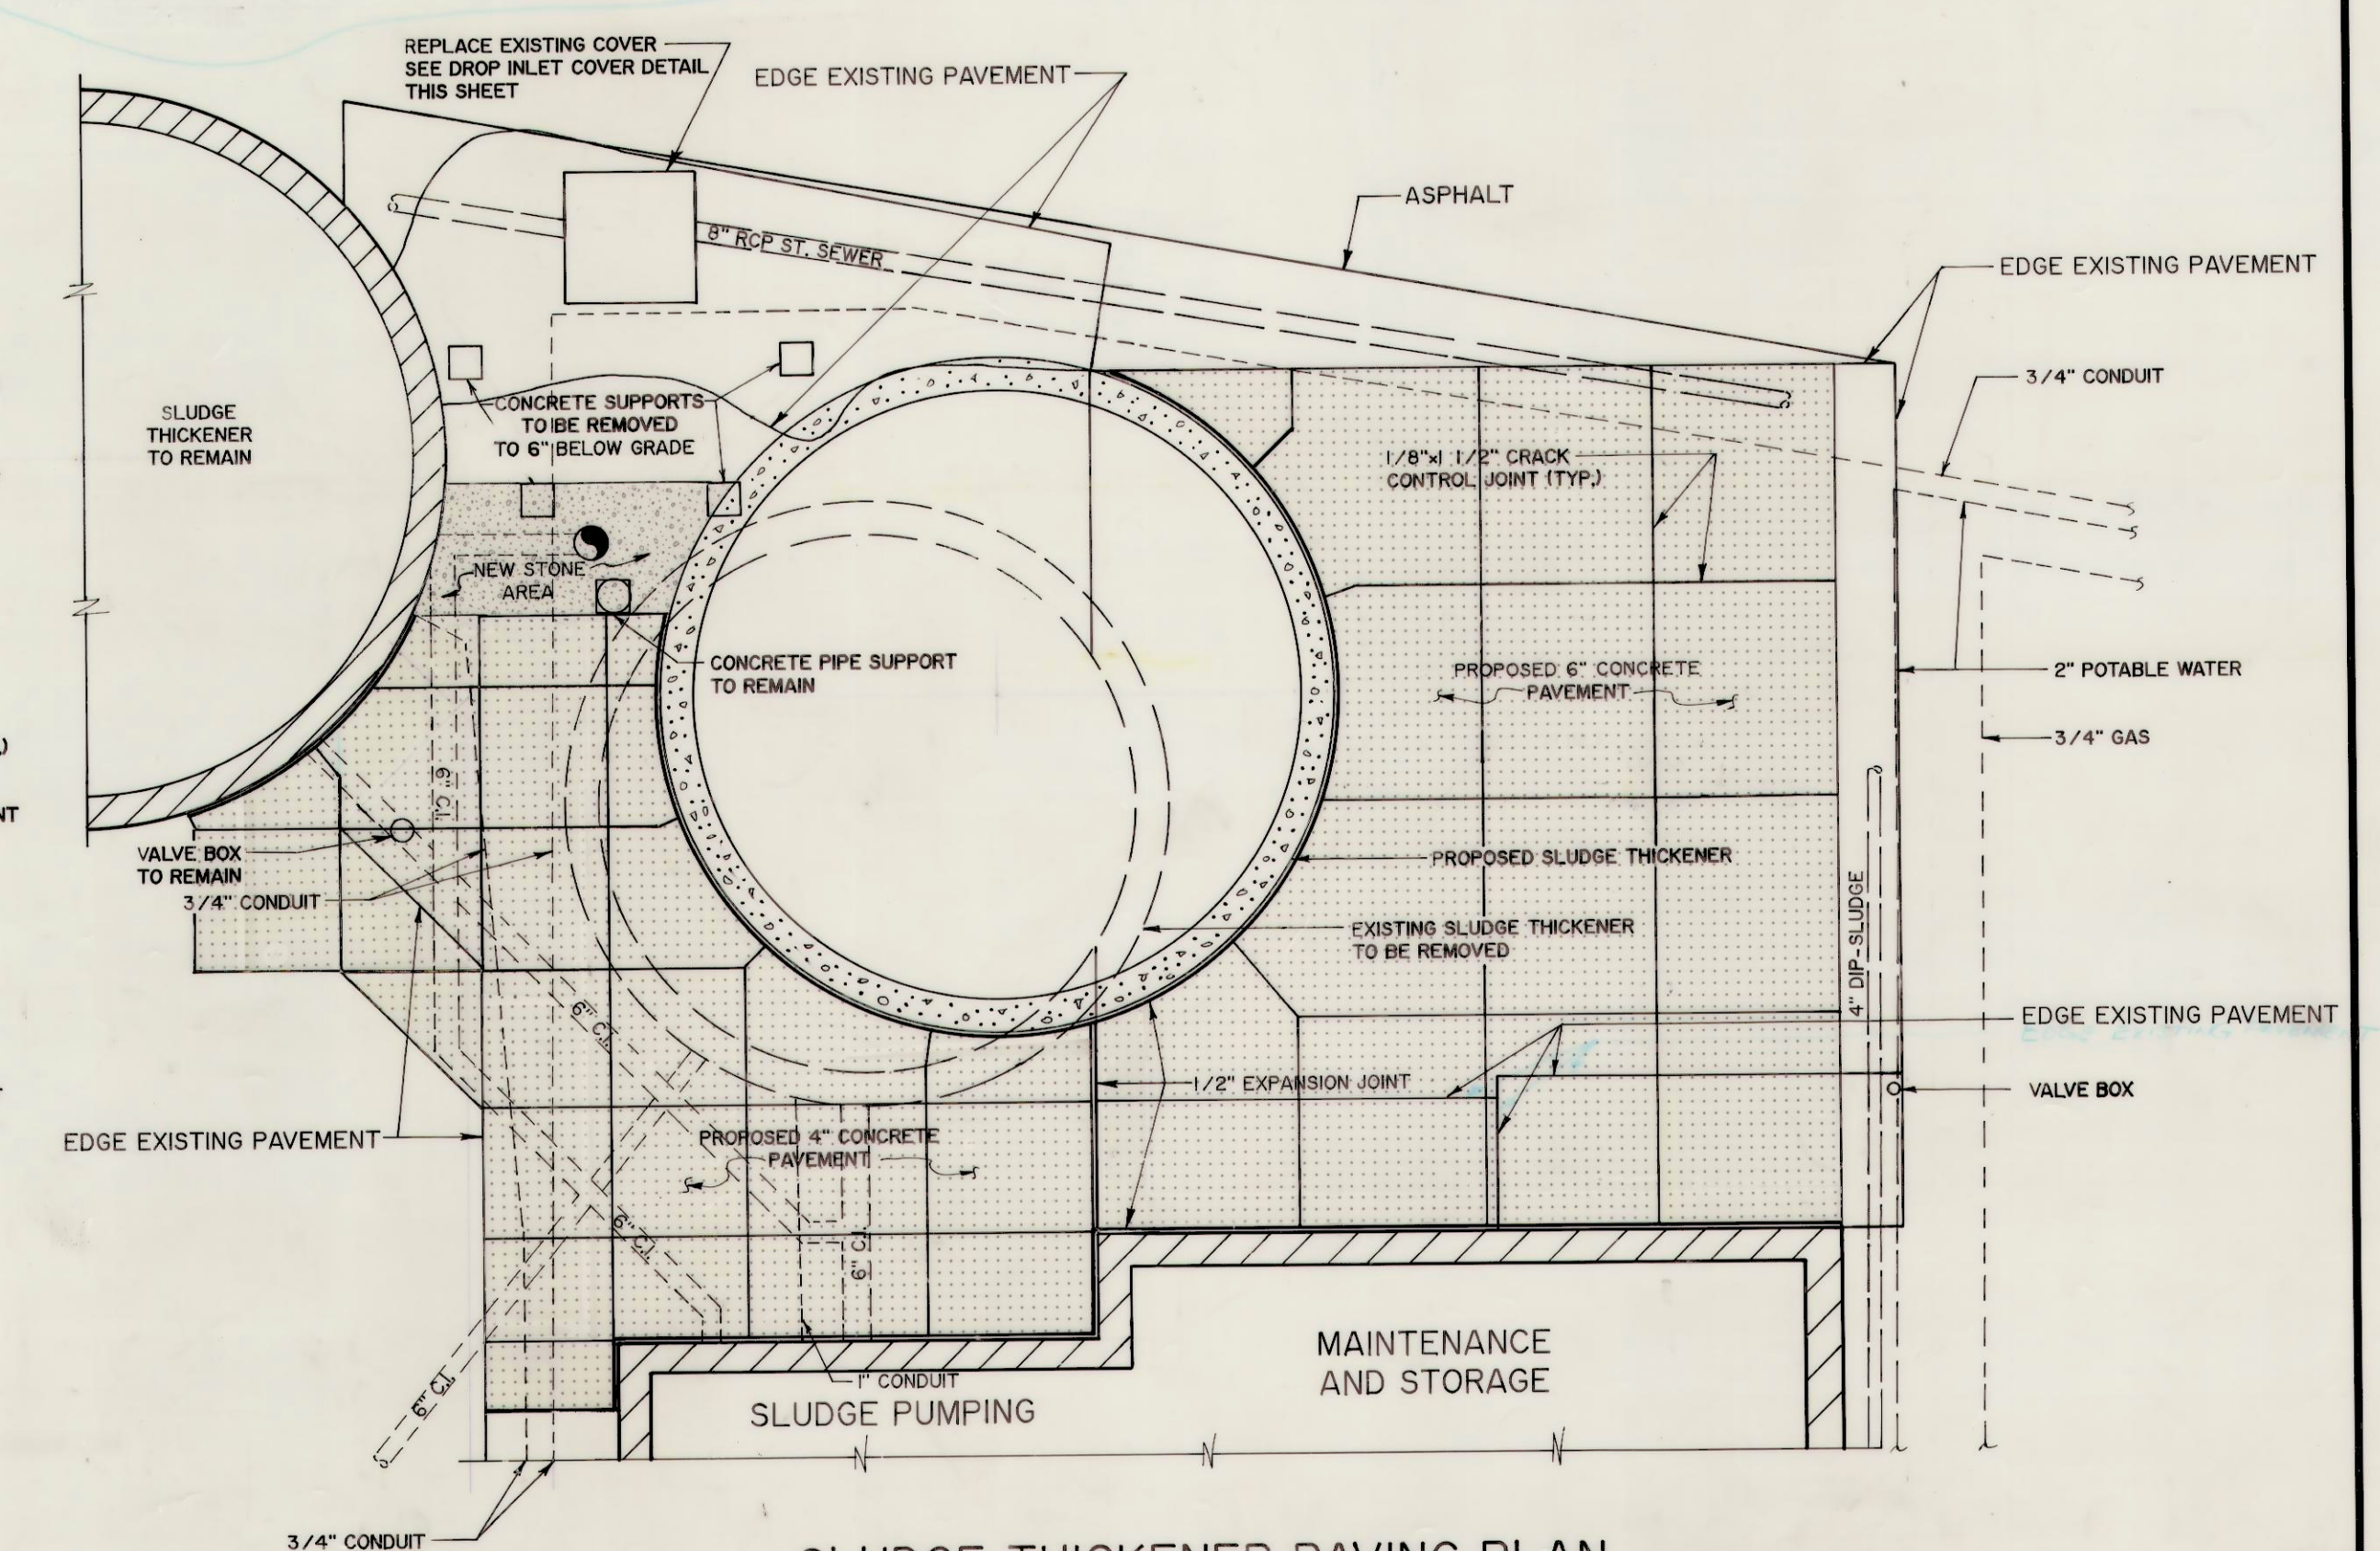

SLUDGE THICKENER PAVING PLAN
SCALE: 3/16" = 1'-0"



PROJECT INFORMATION
CITY OF ST. ALBANS
MUNICIPAL UTILITY COMMISSION
KANAWHA COUNTY, WEST VIRGINIA
WASTEWATER SYSTEM IMPROVEMENTS
EPA PROJECT NO. C-540618-01
ST. ALBANS MUNICIPAL UTILITY COMMISSION
CONTRACT NO. 1



Chapman Technical Group

DRAWING TITLE

MISCELLANEOUS DETAILS

DRAWN: JOE BIRD
CHECKED: C. BELCHER
DATE: DECEMBER 1989
SCALE: AS NOTED
PROJECT NUMBER: 87016
DRAWING NUMBER: 14