



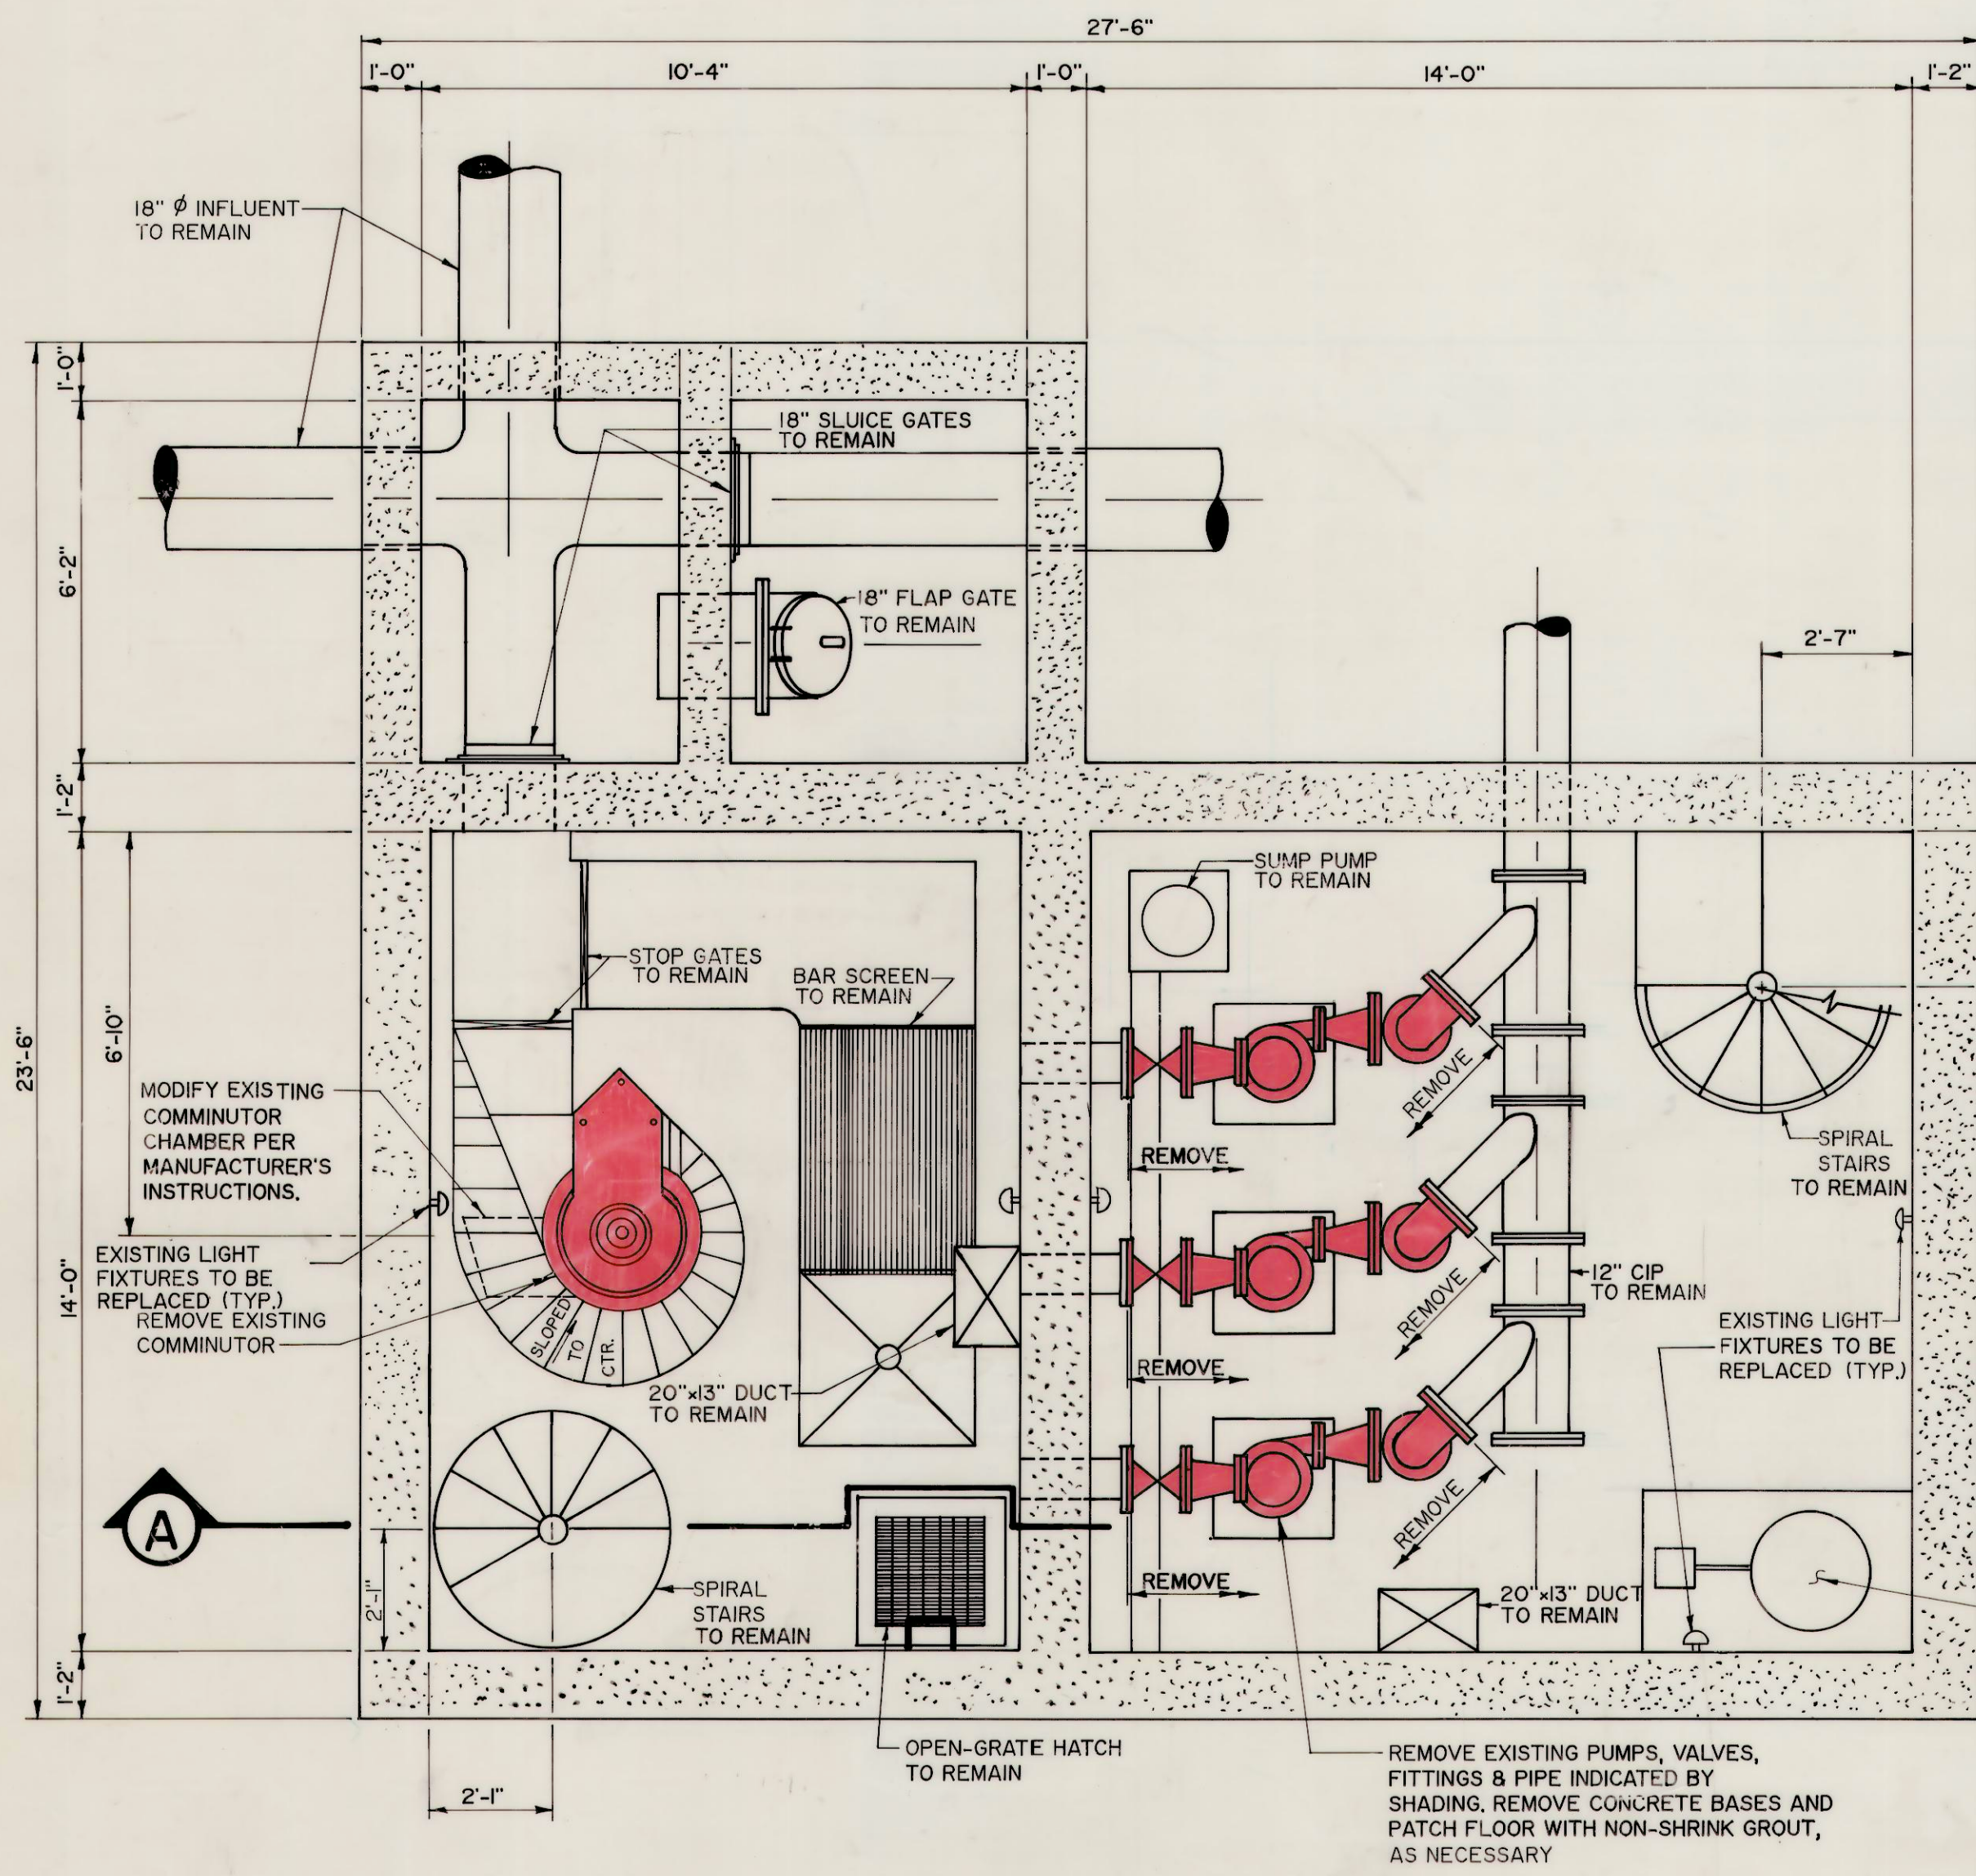


EXISTING PLAN - LOWER LEVEL
 EL. 574.56'

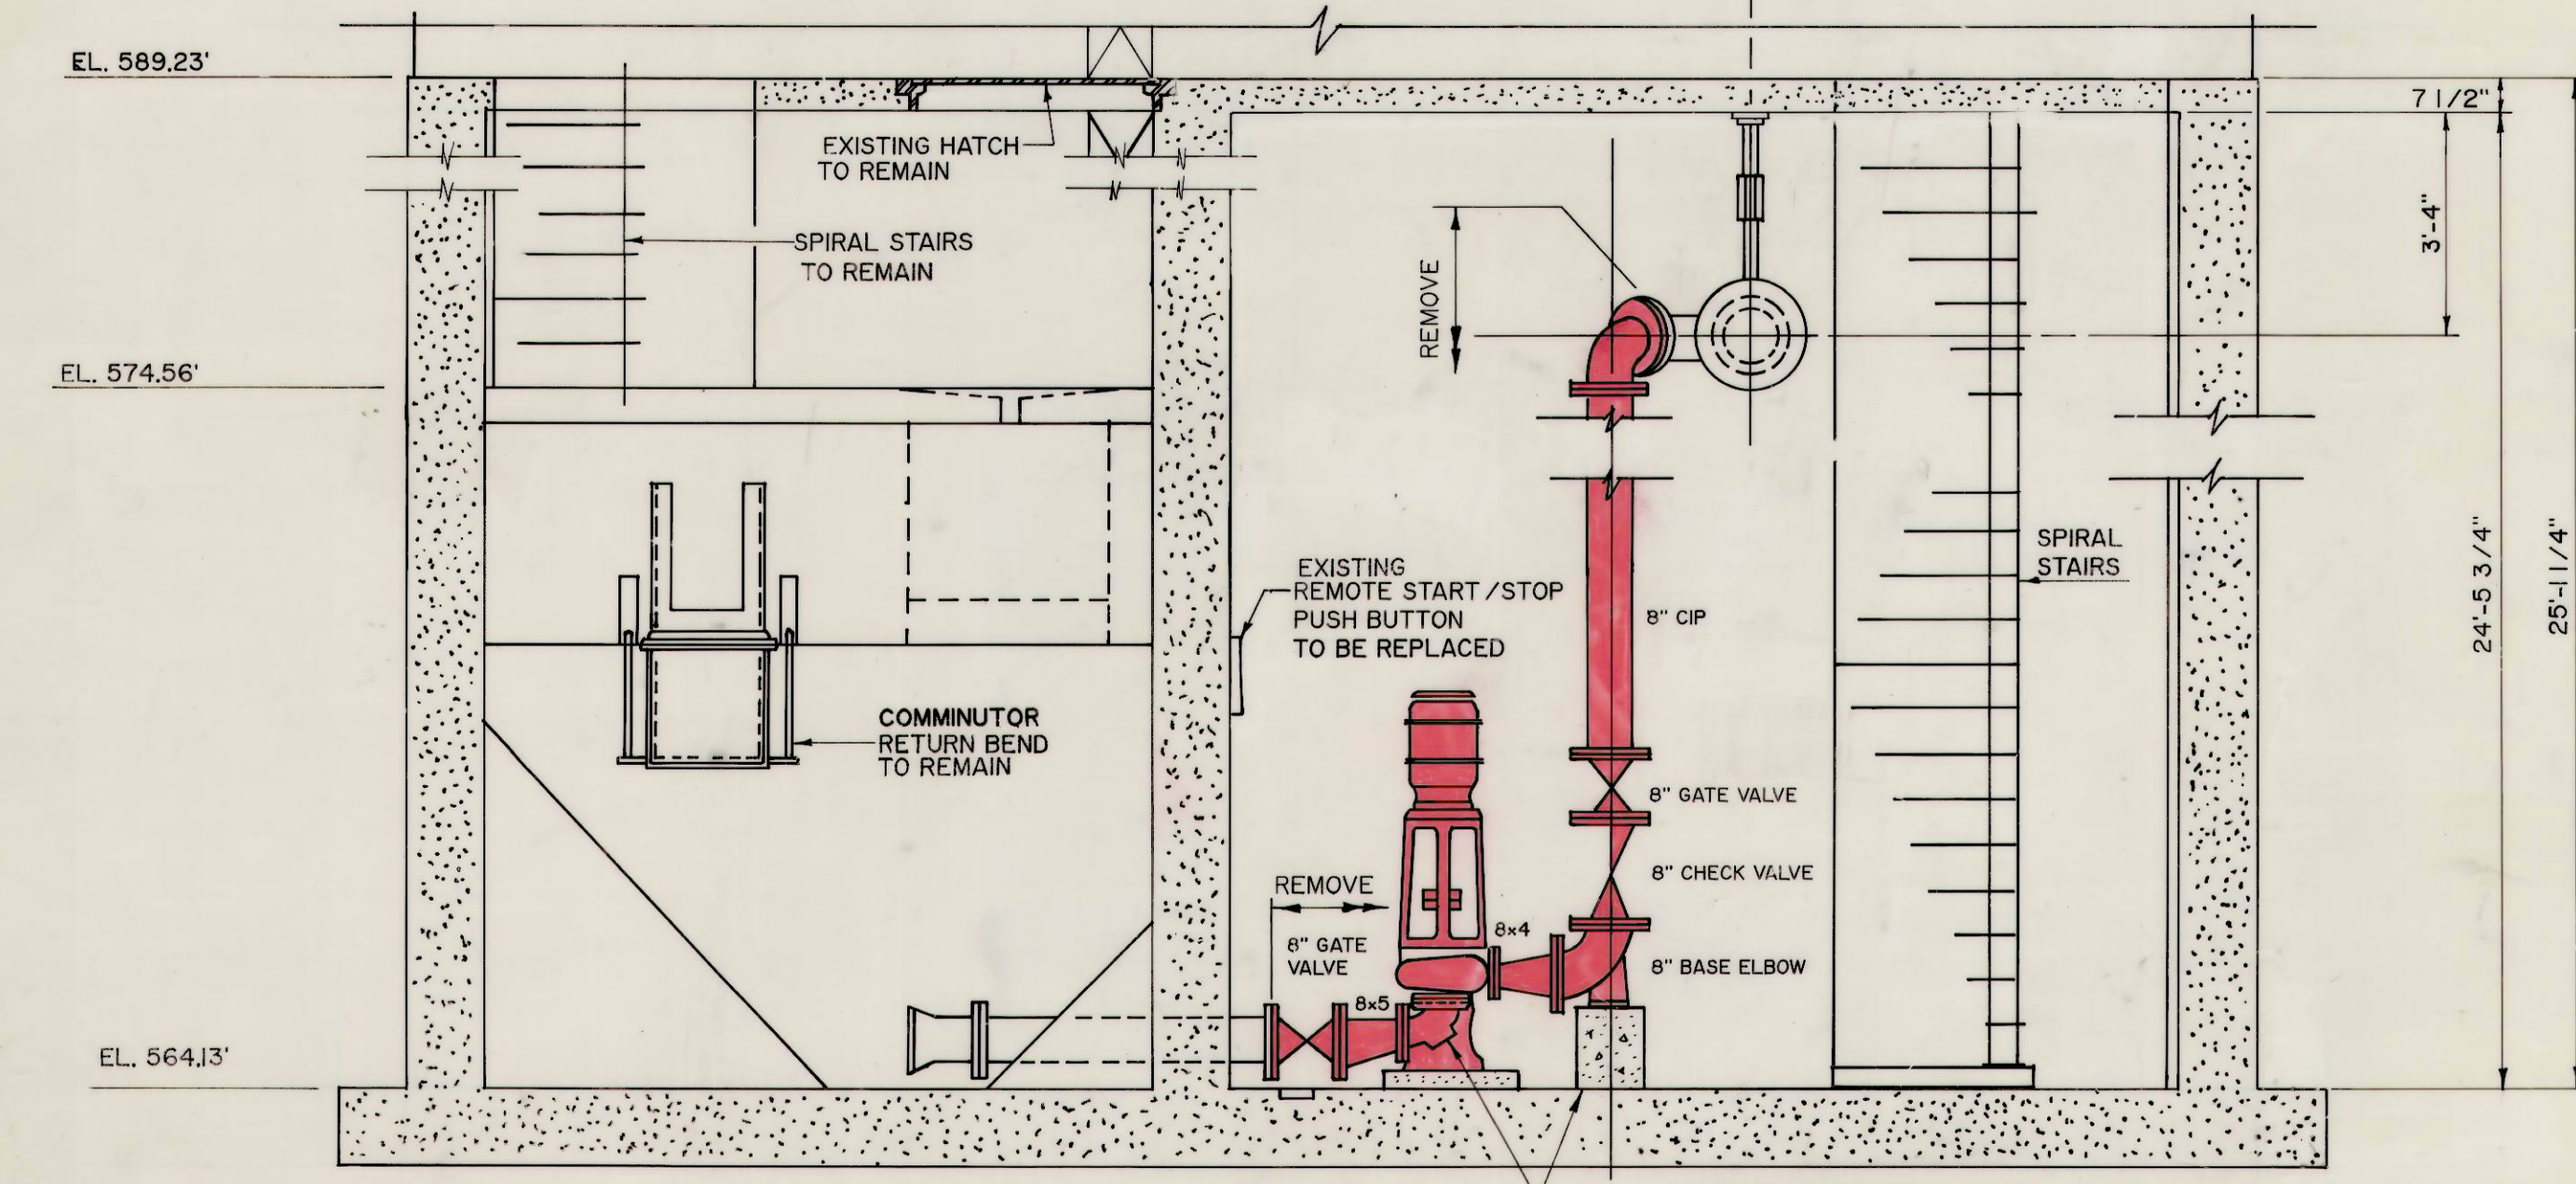


A SECTION

- EXISTING 1 1/2" CHLORINE SOLUTION PIPE, ABANDON TO POINT OF CONNECTION WITH NEW PIPE SEE DRAWING 2.
 EXISTING POTABLE WATER SUPPLY, GATE VALVE, AND VALVE BOX TO REMAIN.
 REPLACE EXISTING INTAKE SHUTTER WITH NEW EXHAUST FAN.
 REMOVE EXISTING MONORAIL SUPPORT COLUMN AND ANCHOR BOLTS, PATCH FLOOR WITH NON-SHRINK GROUT, AS NECESSARY.
 EXISTING INTAKE SHUTTER TO BE REMOVED, BRICK & BLOCK OPENING TO MATCH EXISTING.
 REMOVE EXISTING WATER SEAL PUMP, PIPING, AND RESERVOIR, POTABLE WATER LINE TO REMAIN, PROVIDE NEW CONNECTIONS AS SHOWN ON PROPOSED PLAN.

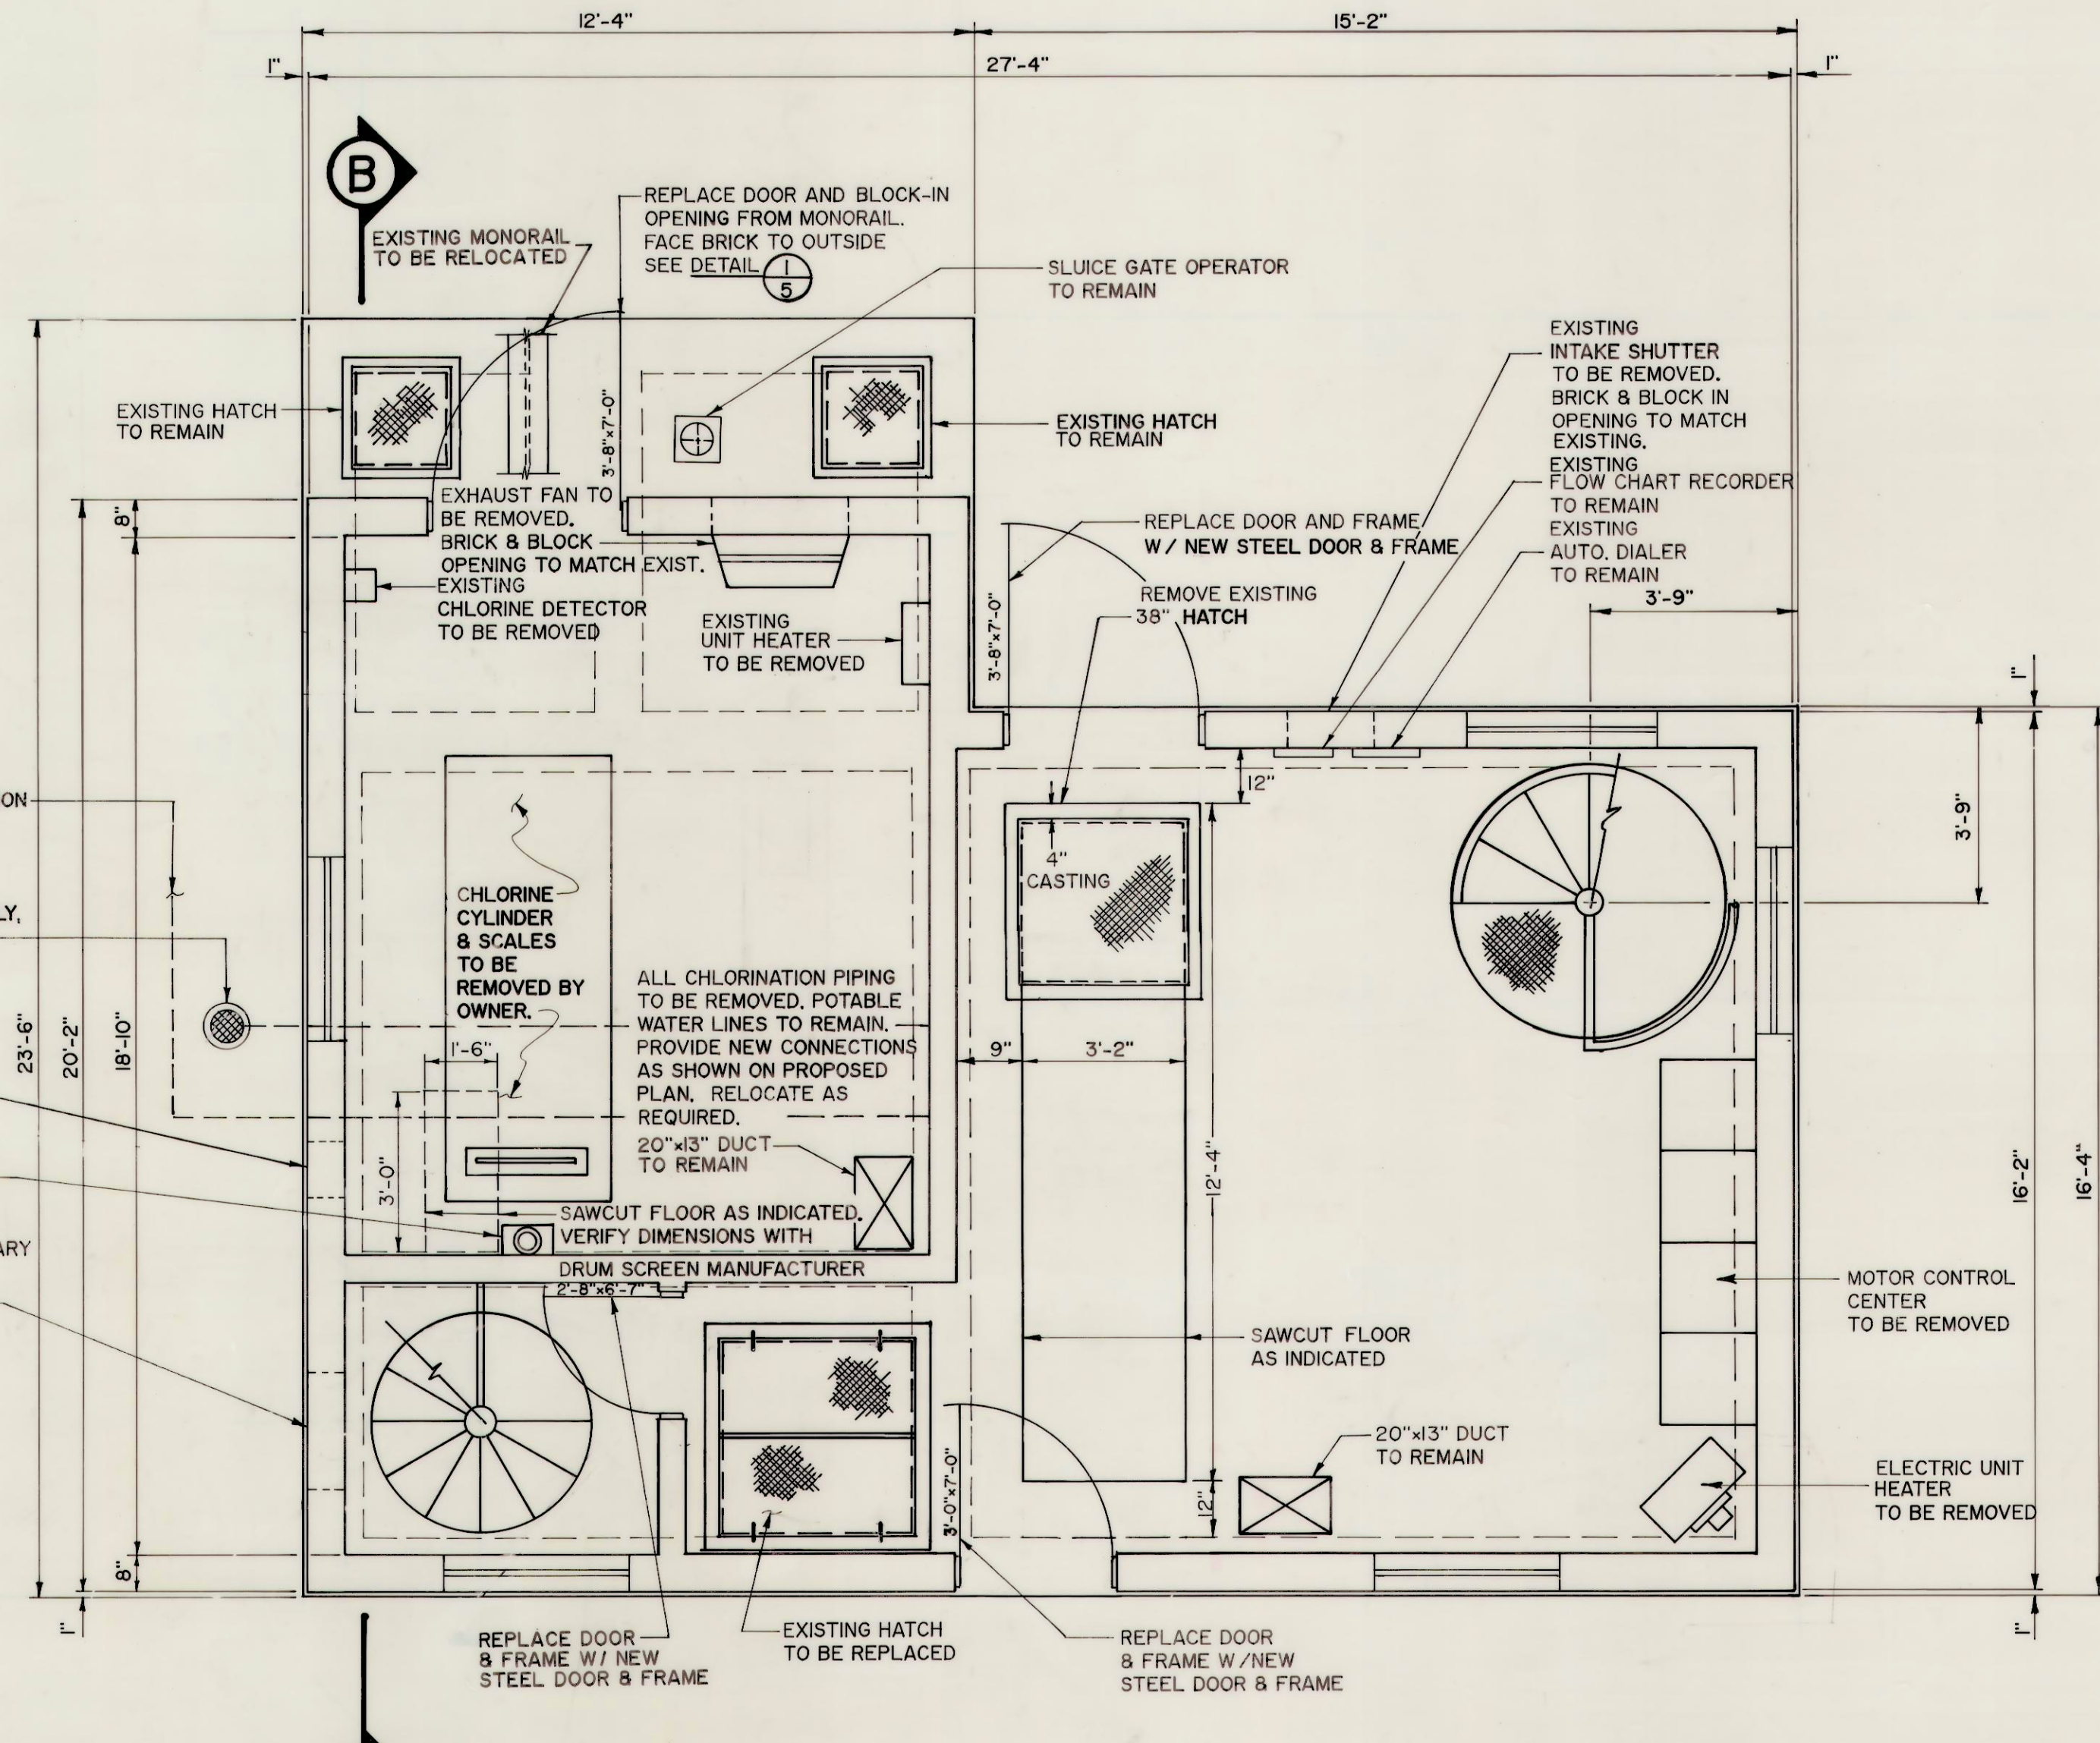

EXISTING PLAN - UPPER LEVEL
 EL. 589.23'

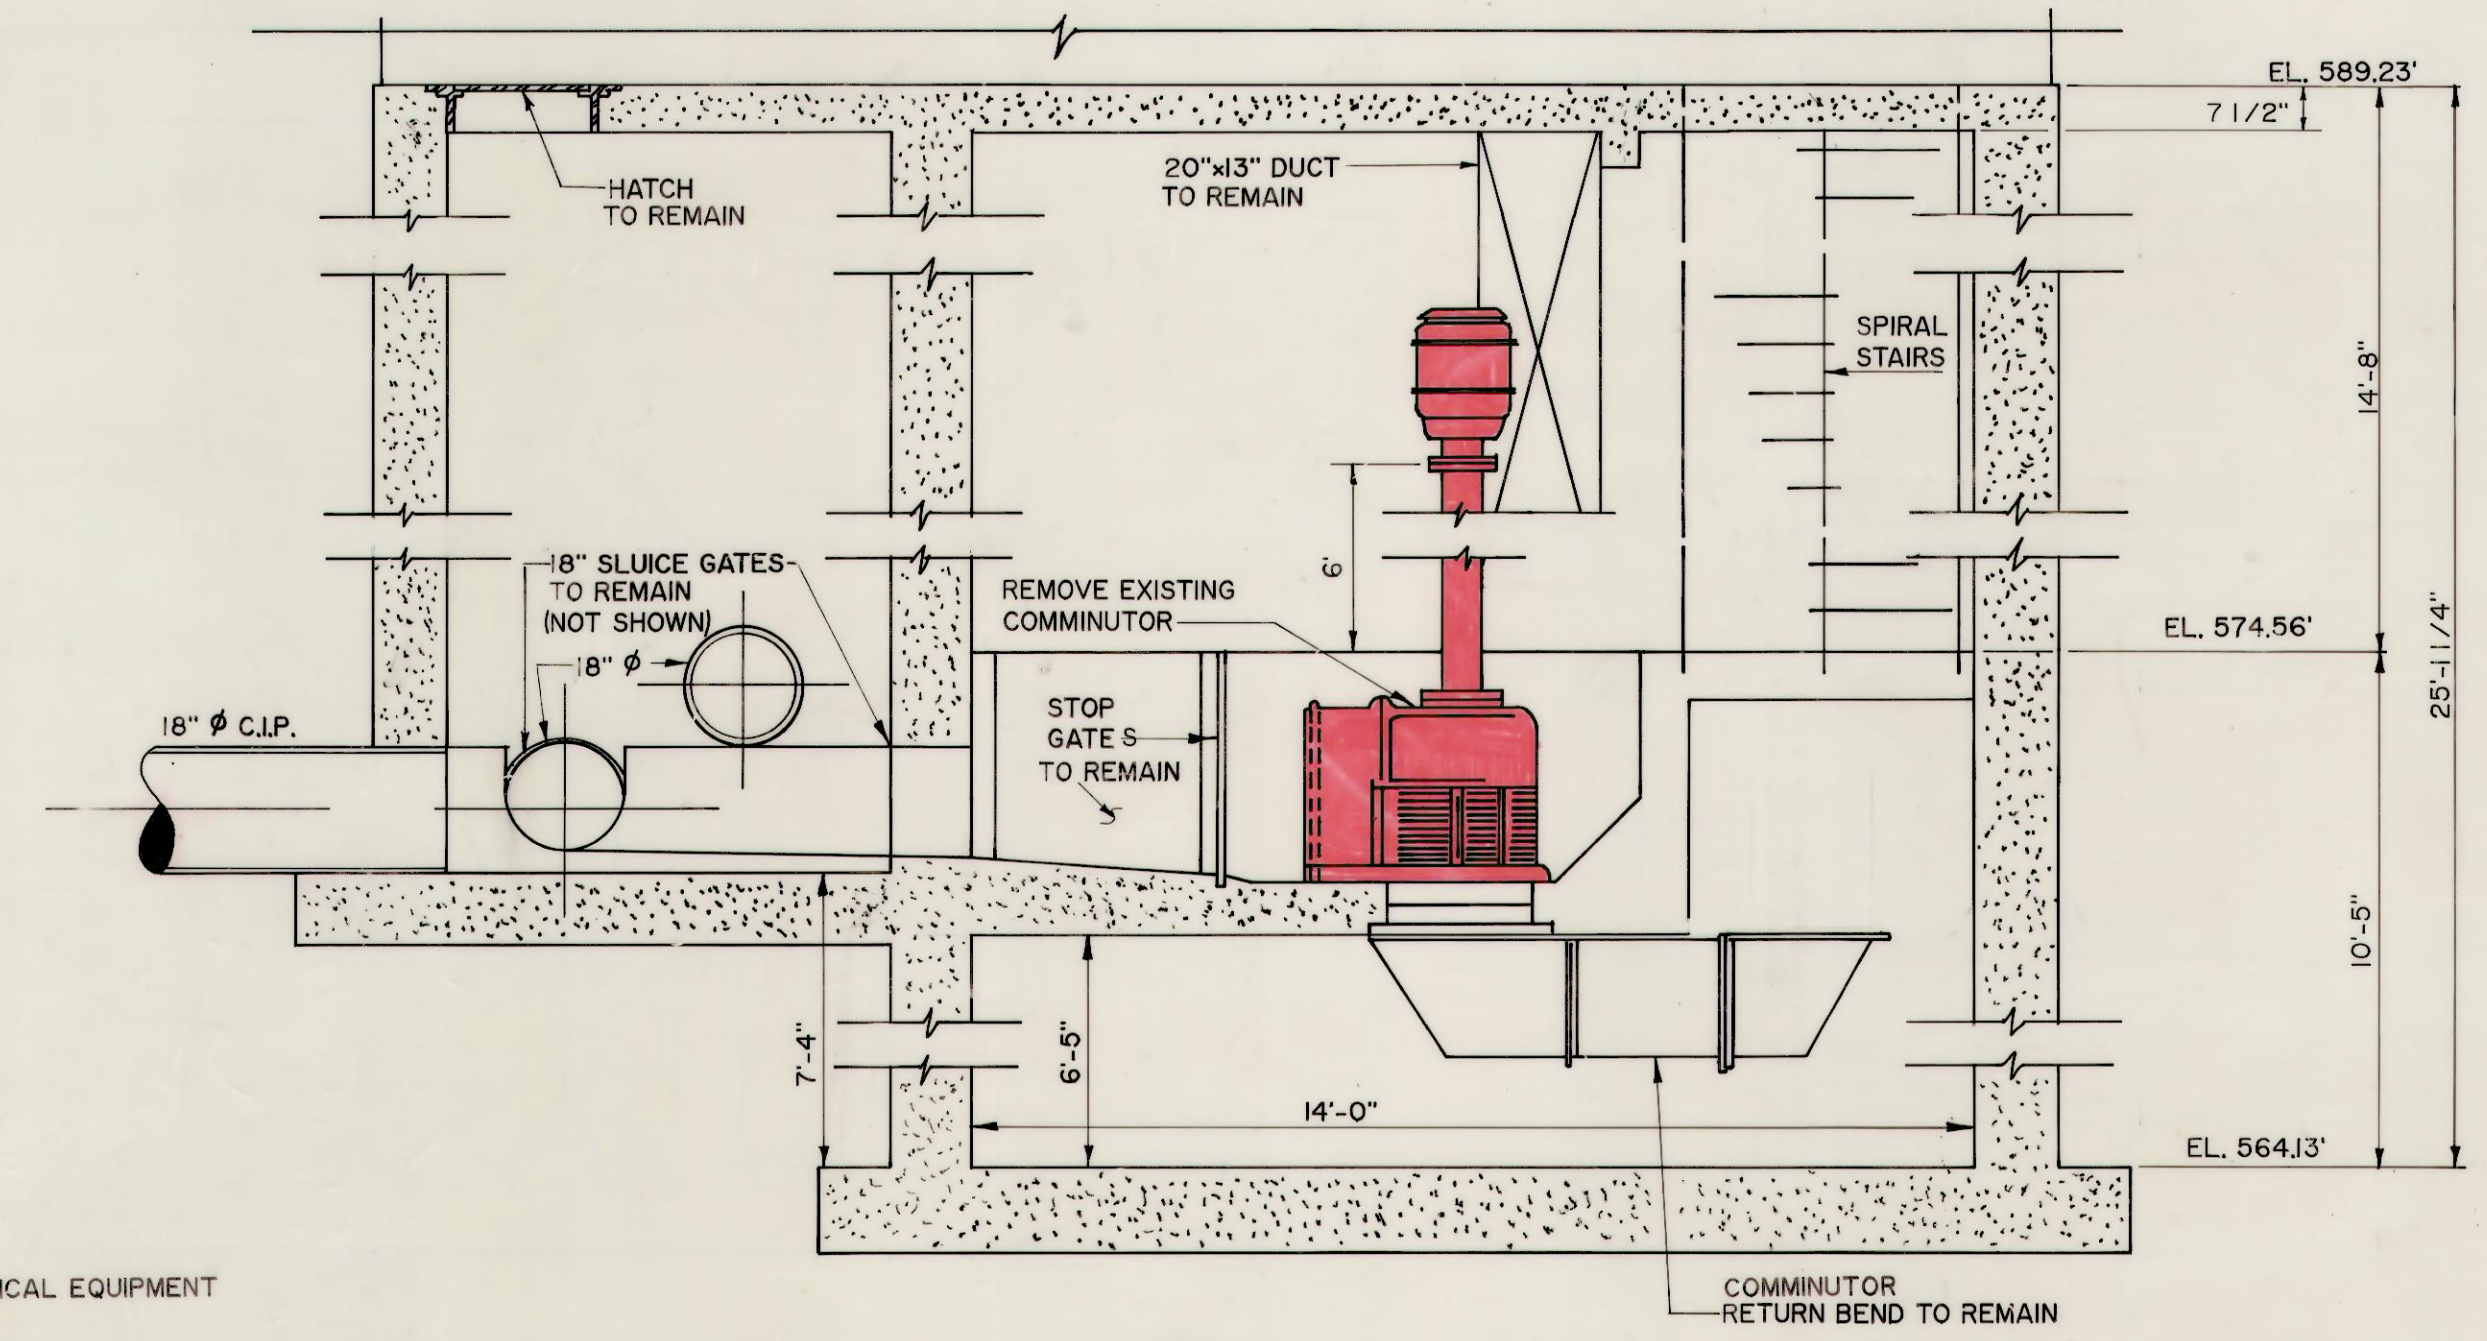

B SECTION

- NOTES:
 1.  EXISTING MECHANICAL EQUIPMENT TO BE REMOVED
 2. SEE DRAWING 15 FOR ELECTRICAL AND MECHANICAL PLANS