




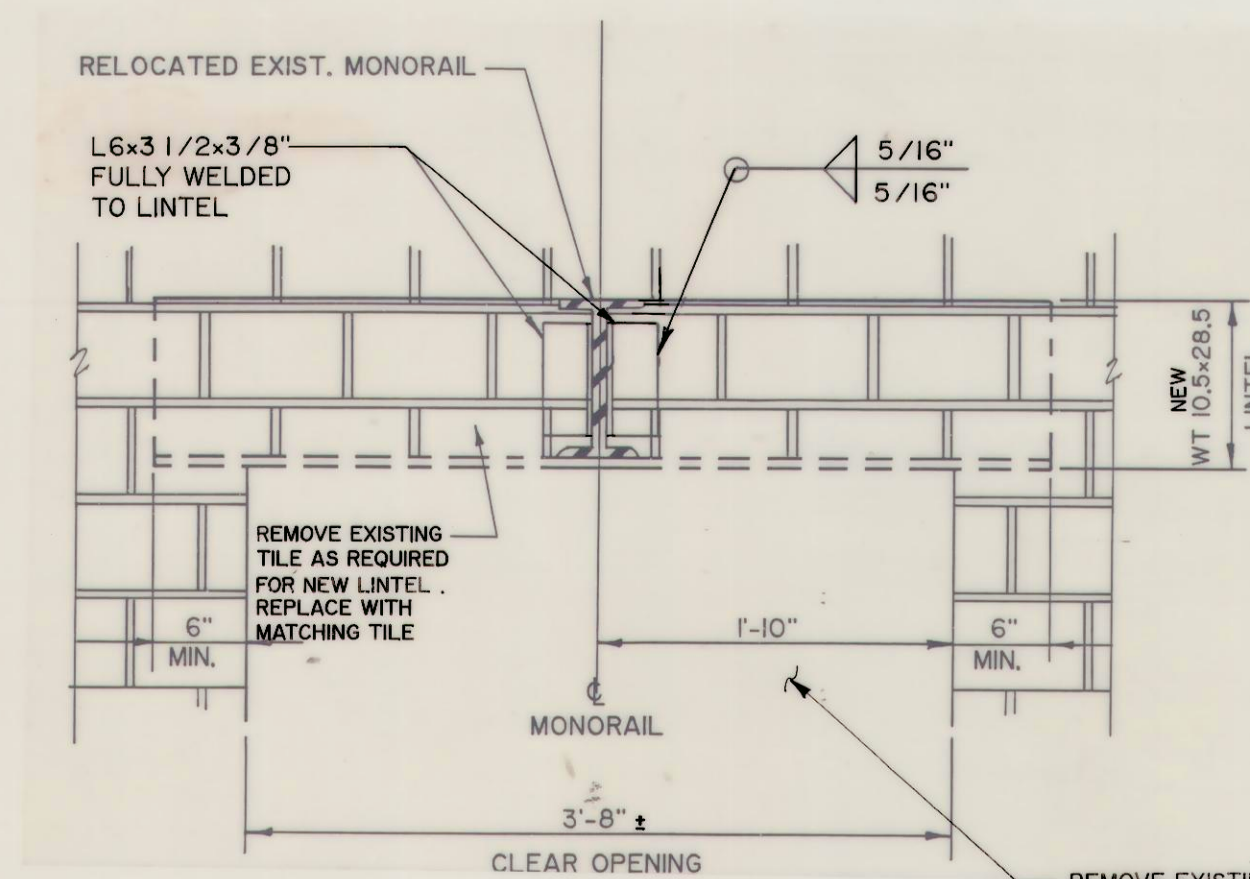


MONORAIL SECTION
SCALE: NONE

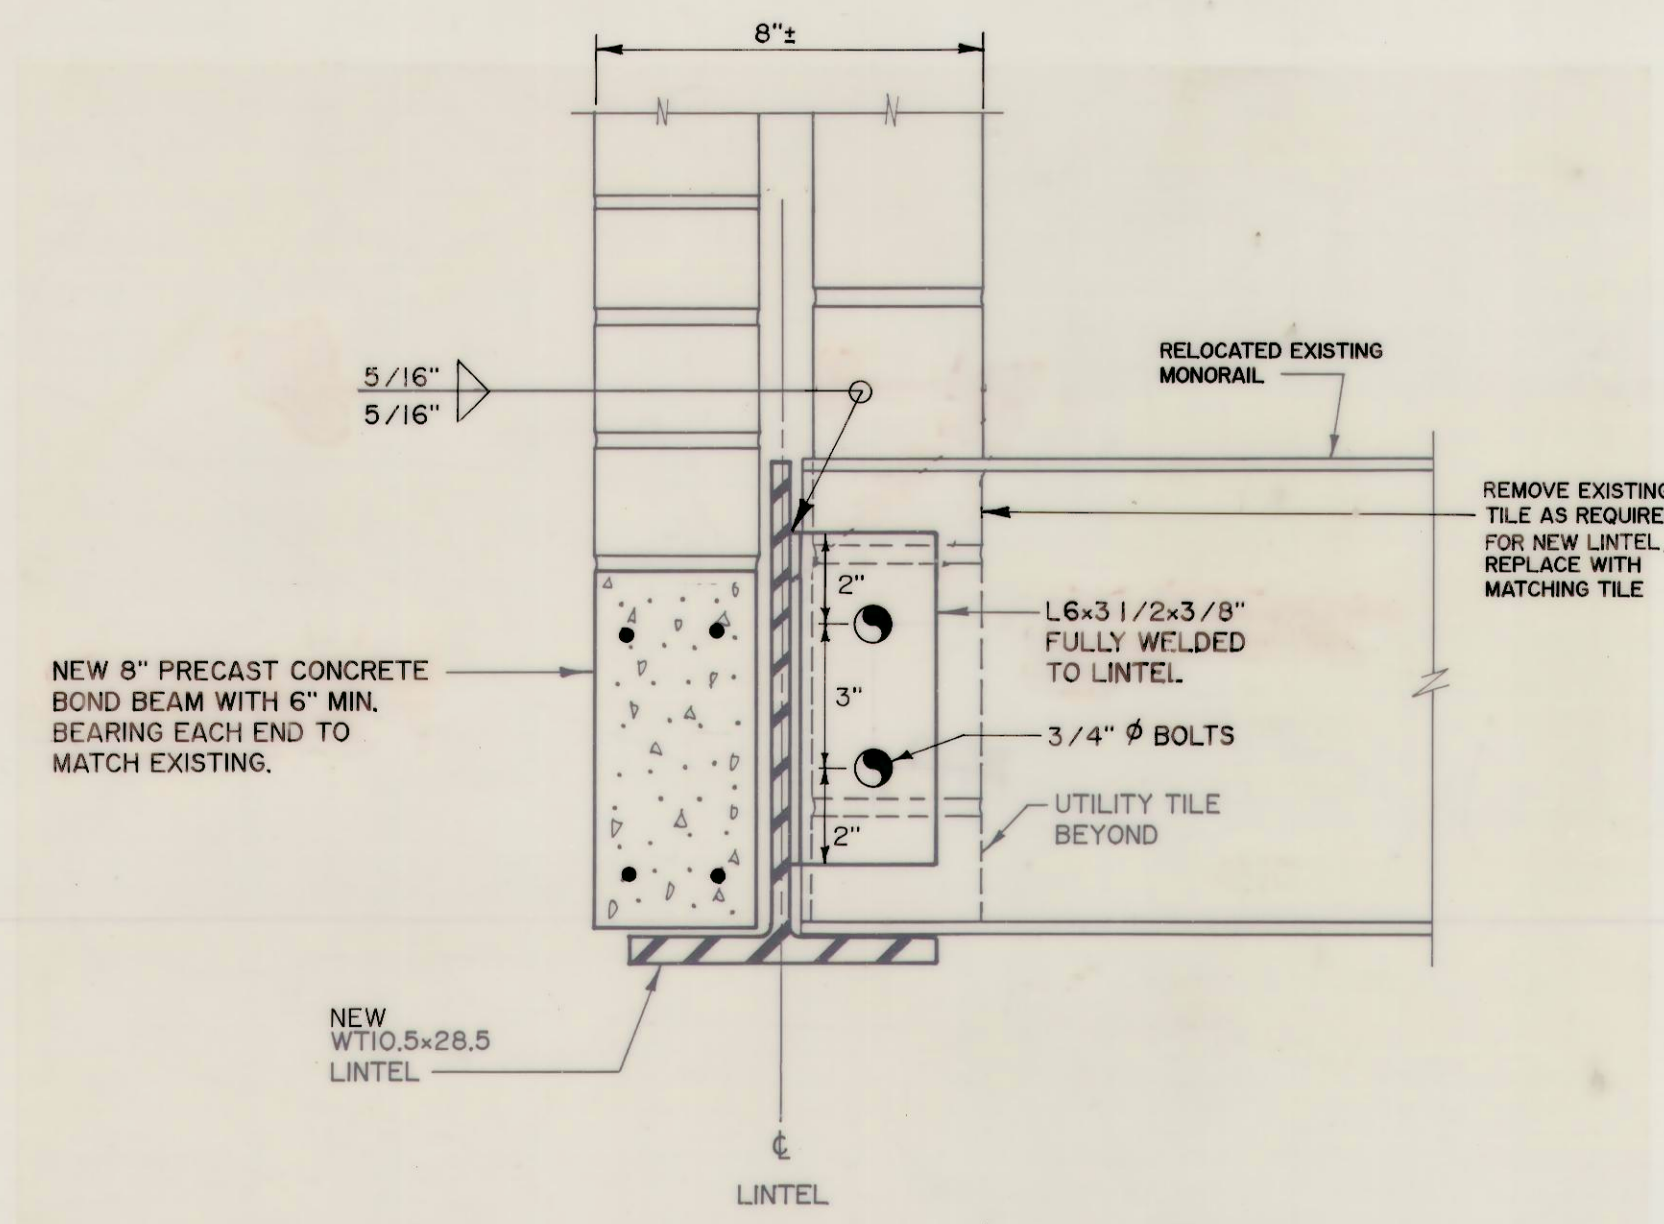


LINTEL SECTION
SCALE: NONE

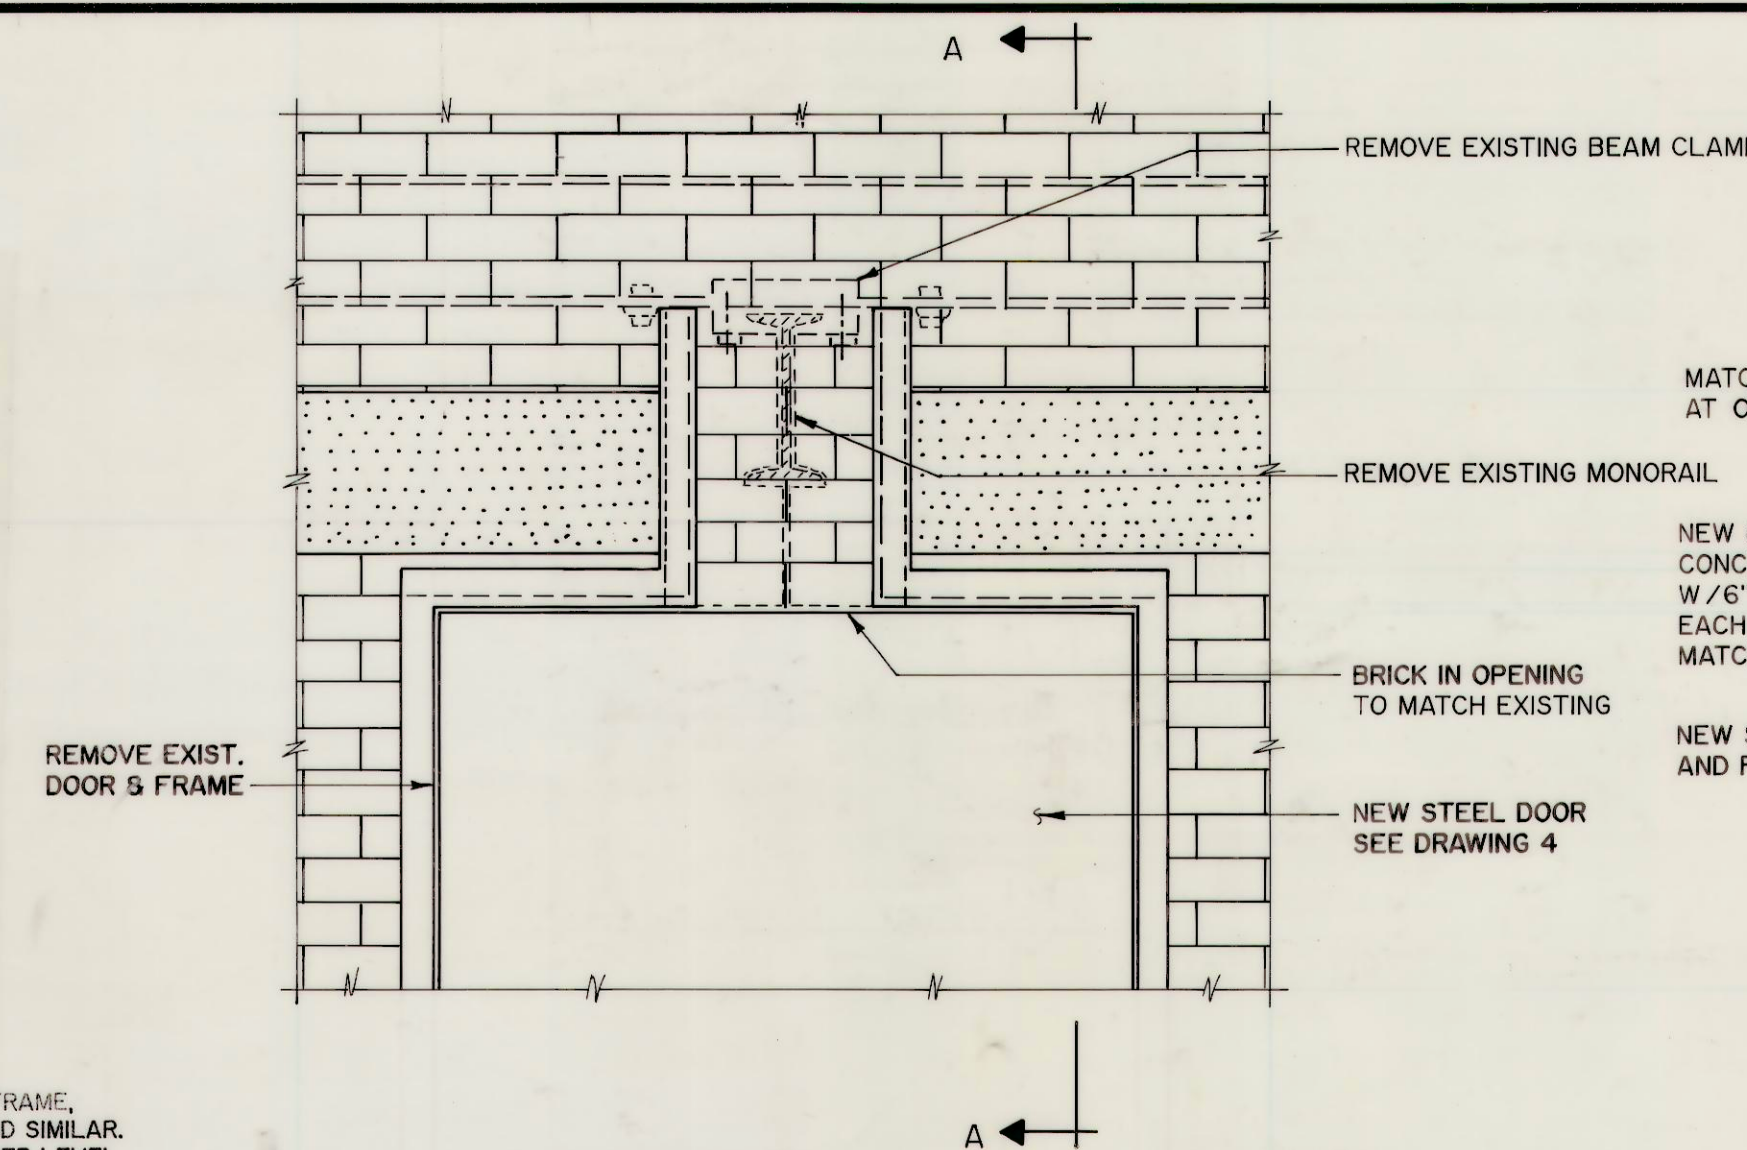



DETAIL 1
SCALE: NONE

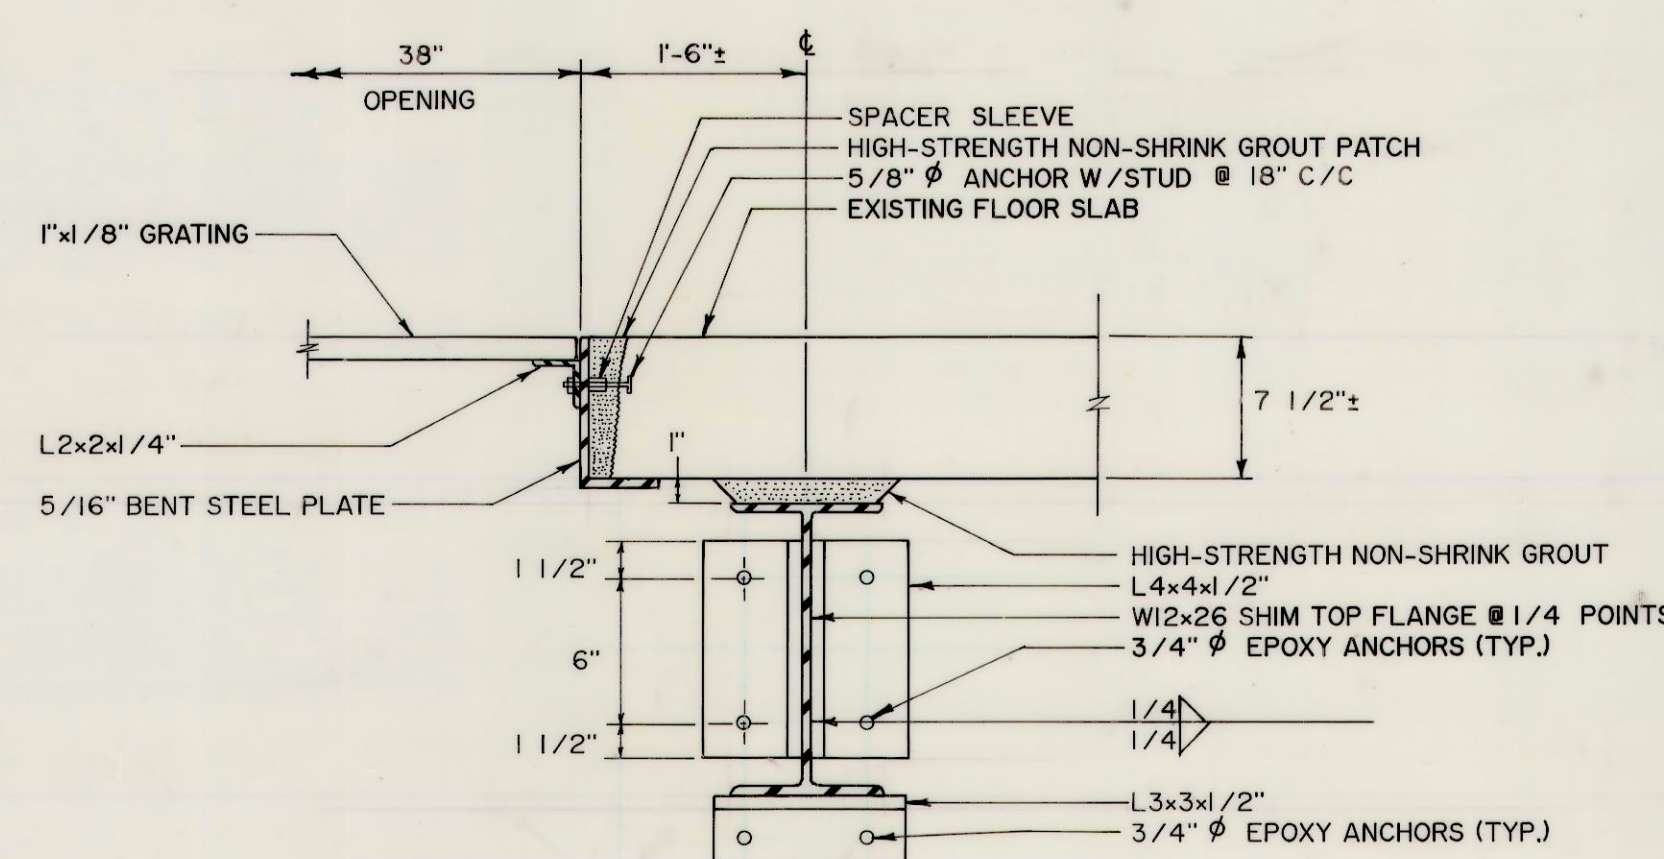


DETAIL 2
SCALE: 1 1/2\"/>

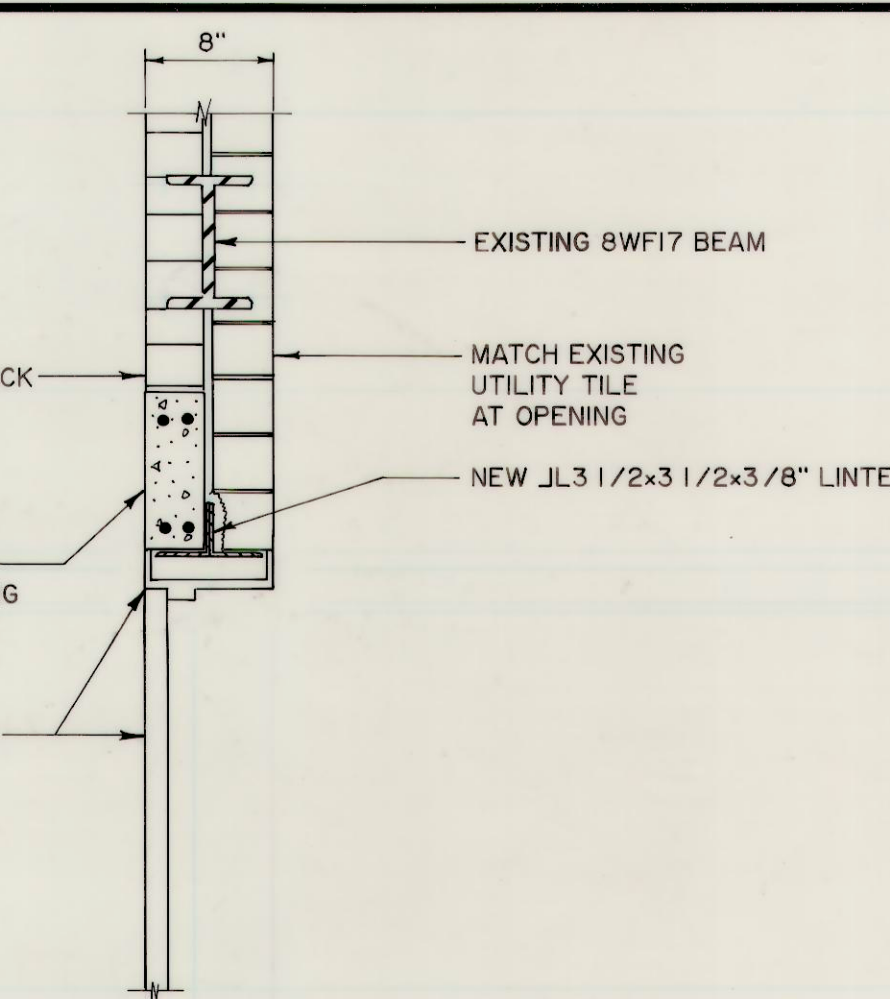

SECTION 'A-A'
SCALE: NONE

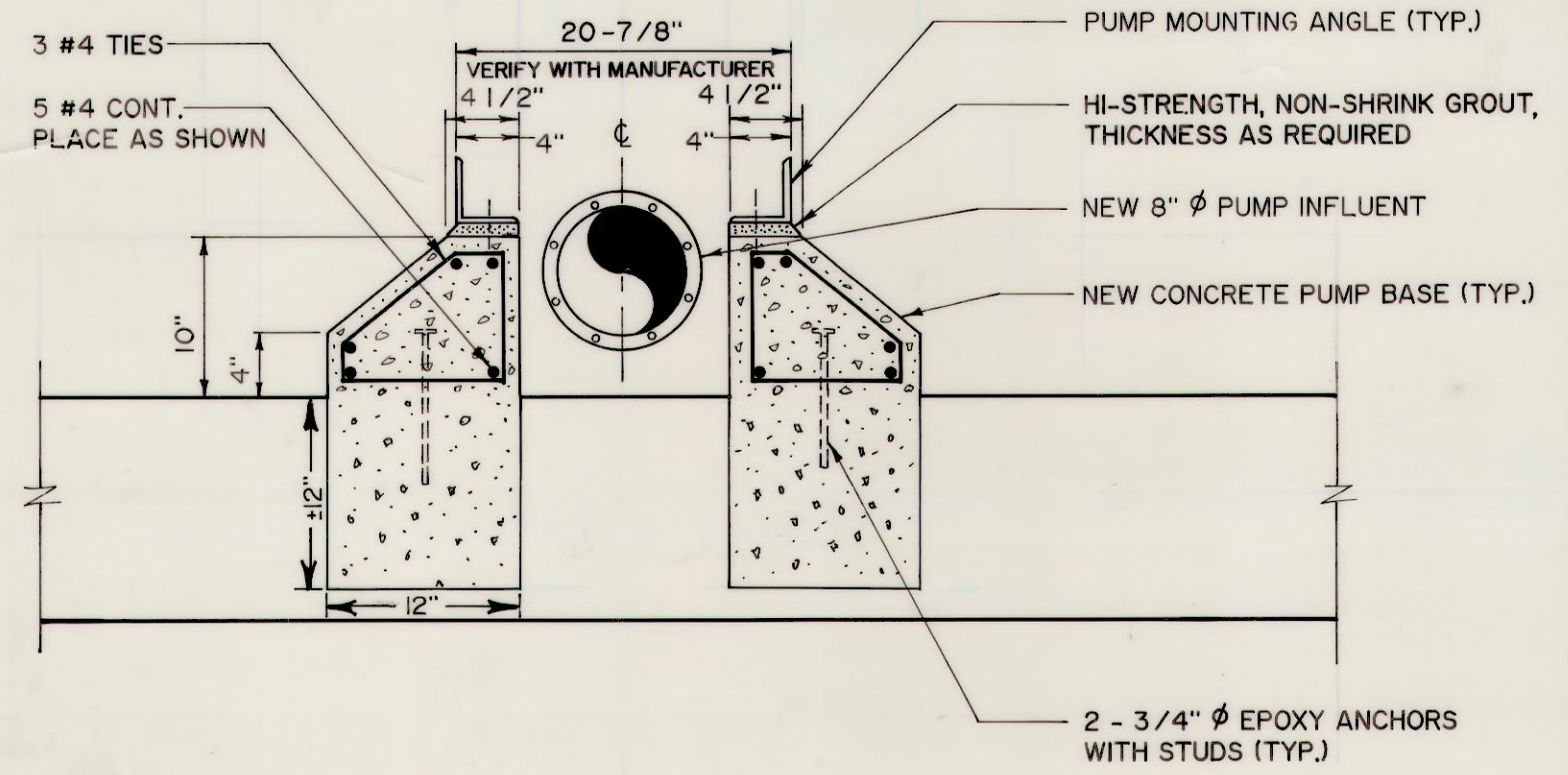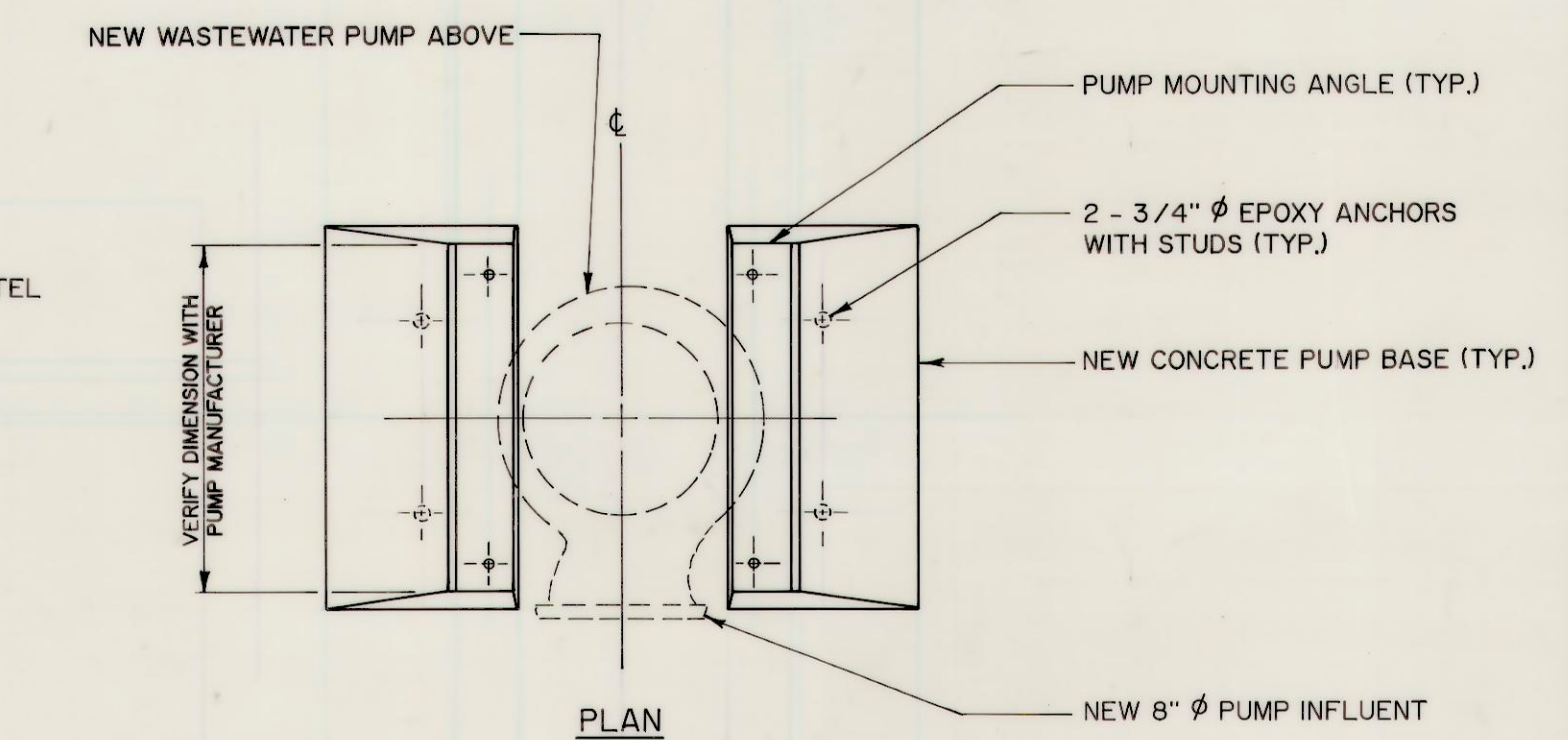

SECTION WASTEWATER PUMP BASE DETAIL
SCALE: 1\"/>

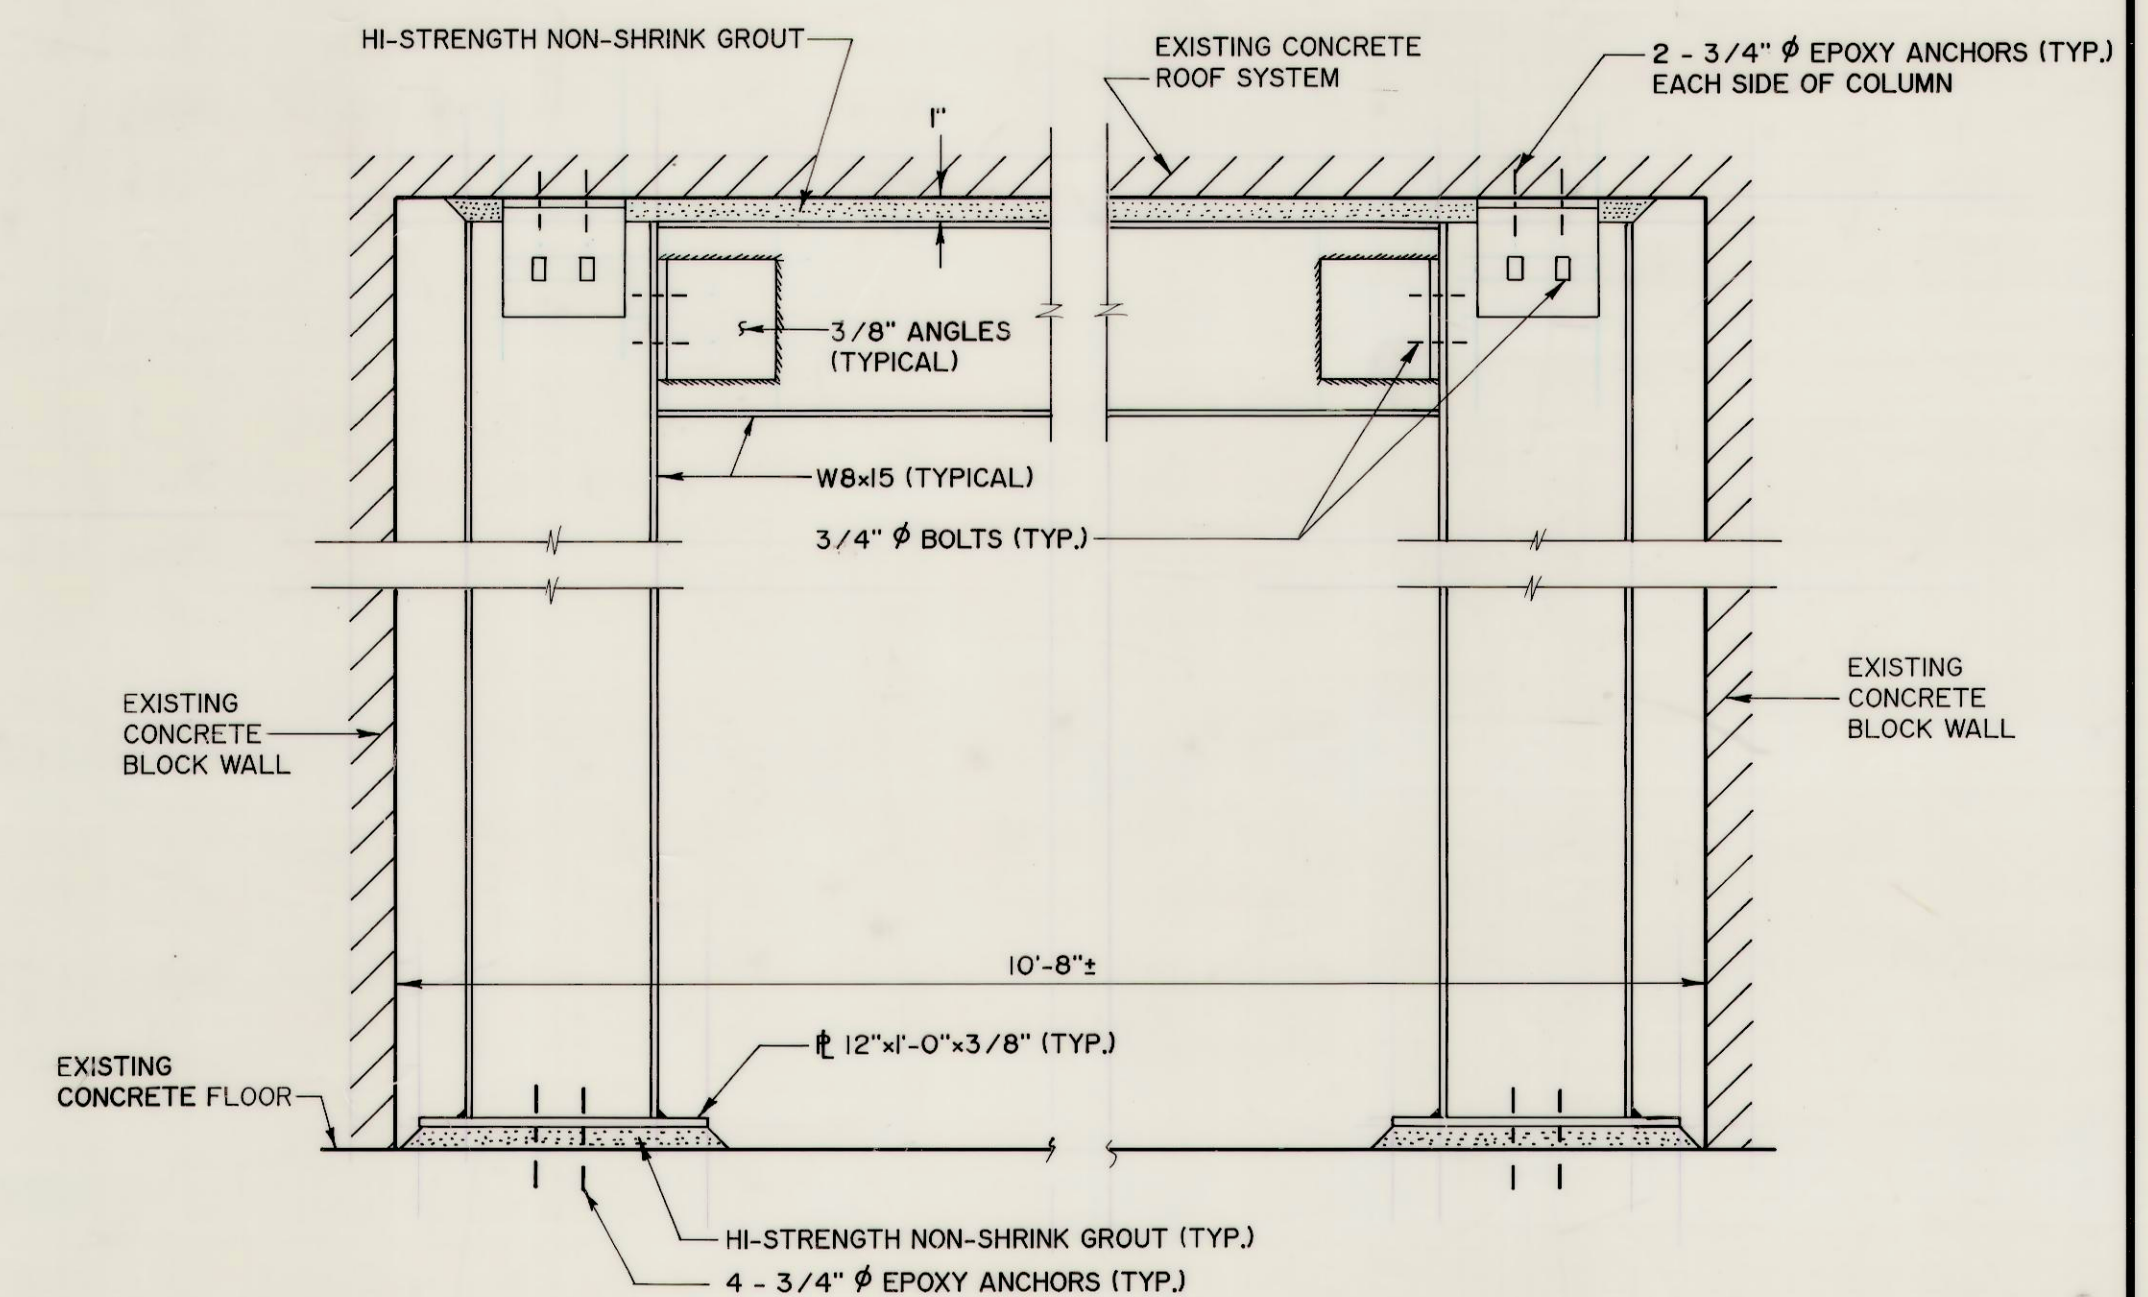

DETAIL 3
SCALE: 1 1/2\"/>

NOTE:
COORDINATE LOCATION OF FRAME
WITH LOCATION OF ROOF MOUNTED
HEATER MU/L



PROJECT INFORMATION
CITY of ST. ALBANS
MUNICIPAL UTILITY COMMISSION
KANAWHA COUNTY, WEST VIRGINIA
WASTEWATER SYSTEM IMPROVEMENTS
EPA PROJECT No. C-540618-01
CONTRACT No. 1



Chapman Technical Group

DRAWING TITLE
**PLANT LIFT STATION
SECTIONS AND DETAILS**

DRAWN
R. OSBORNE
CHECKED
G. BELCHER
DATE
OCTOBER, 1989
SCALE
AS SHOWN
PROJECT NUMBER
57016
DRAWING NUMBER