


Chapman Technical Group

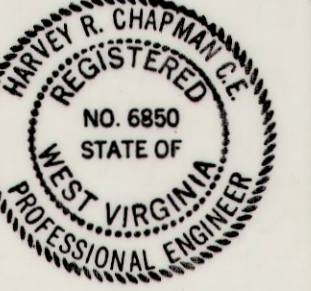

CITY of ST. ALBANS
MUNICIPAL UTILITY COMMISSION
KANAWHA COUNTY, WEST VIRGINIA
WASTEWATER SYSTEM IMPROVEMENTS
EPA PROJECT No. C-540618-01

CONTRACT NO. 2

[illegible]

- | | |
|--------|--|
| 1 - 2 | WASTEWATER COLLECTION SYSTEM PLAN SHEETS |
| 3 | PROFILE LINES A51, A51A, A51B, A52, A52A
FURLONG & MORRELL AVENUES |
| 4 | PROFILE LINES A49, A49A, A49B, A50, A50A, A50B
FORRESTAL & BARD AVENUES |
| 5 | PROFILE LINES A47, A47A, A48, A48A
ROOSEVELT & KNOX AVENUES |
| 6 | PROFILE LINE A1, PFAFF STREET |
| 7 - 8 | WASTEWATER COLLECTION SYSTEM DETAILS |
| 9 - 14 | HOUSE LATERAL LOCATIONS |

CITY of ST. ALBANS, MUNICIPAL UTILITY COMMISSION

APPROVED: A. Eddie Bassitt 3/30/90
A. EDDIE BASSITT, MAYOR & CHAIRMAN / DATE

CHAPMAN TECHNICAL GROUP, CONSULTING ENGINEERS

APPROVED: Harvey R. Chapman 3/30/90
HARVEY R. CHAPMAN, P.E., OWNER DATE

DRAWING TITLE

MILE SHEET

DRAWN
R. OSBORNE
CHECKED
G. BELCHER
DATE
SEPTEMBER, 1989
SCALE
NONE
PROJECT NUMBER
87016
DRAWING NUMBER

RECORD DRAWING