
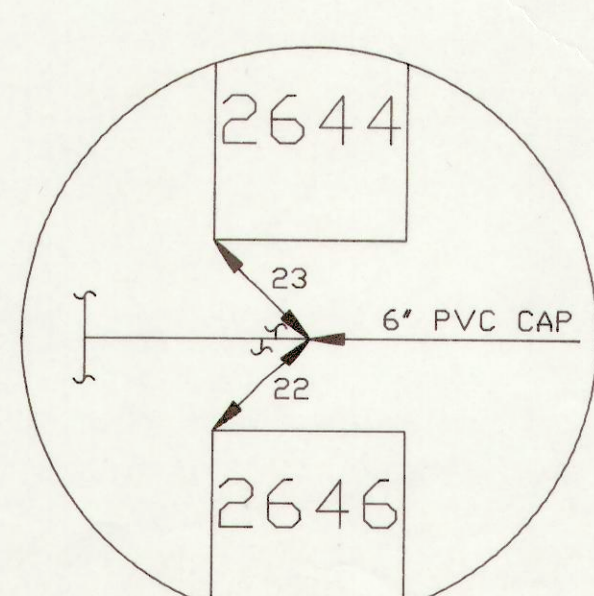
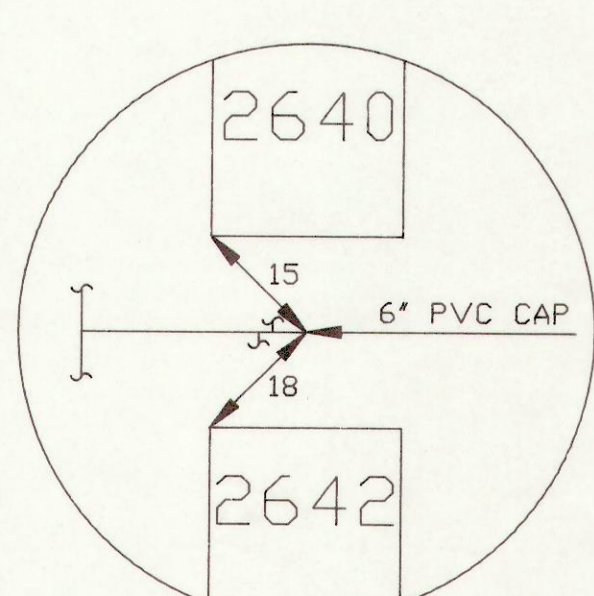
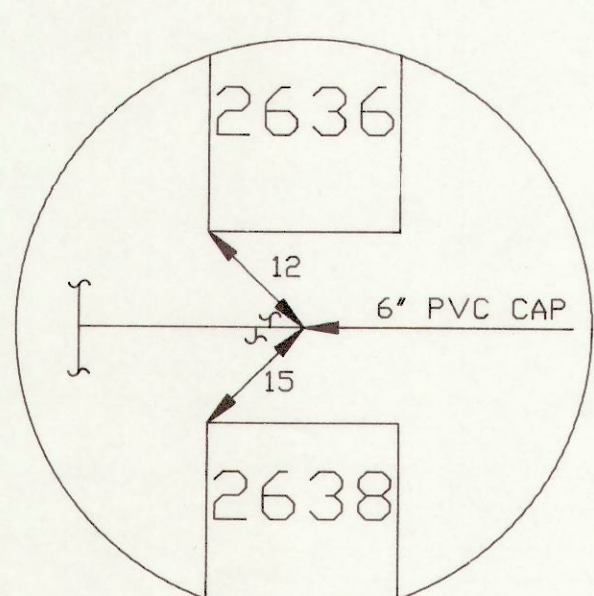
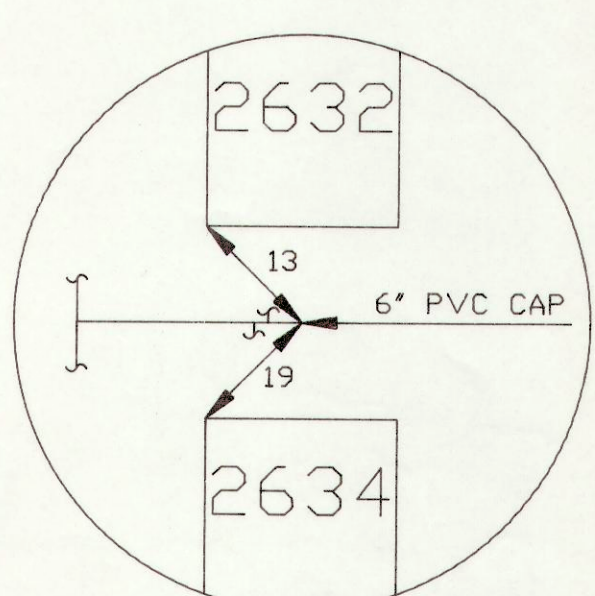
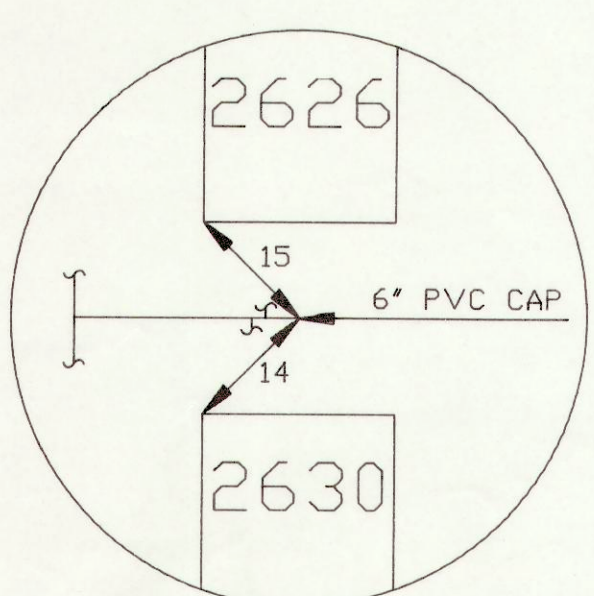
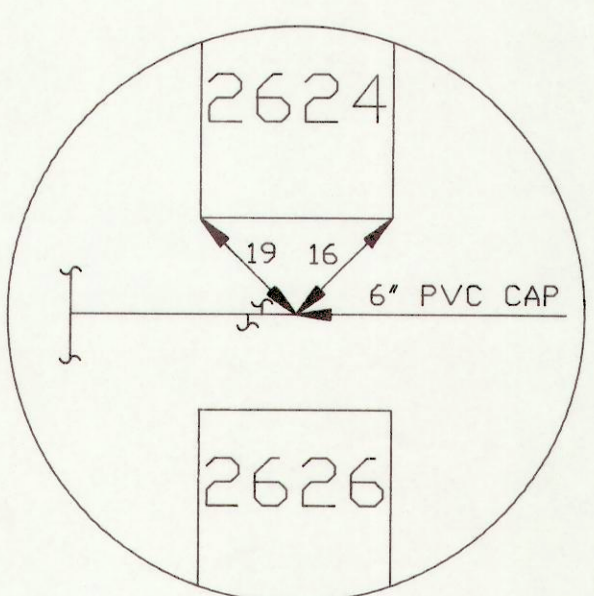
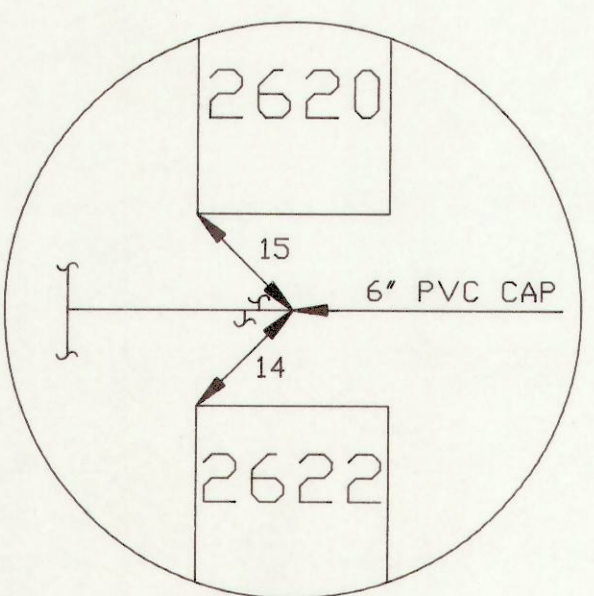
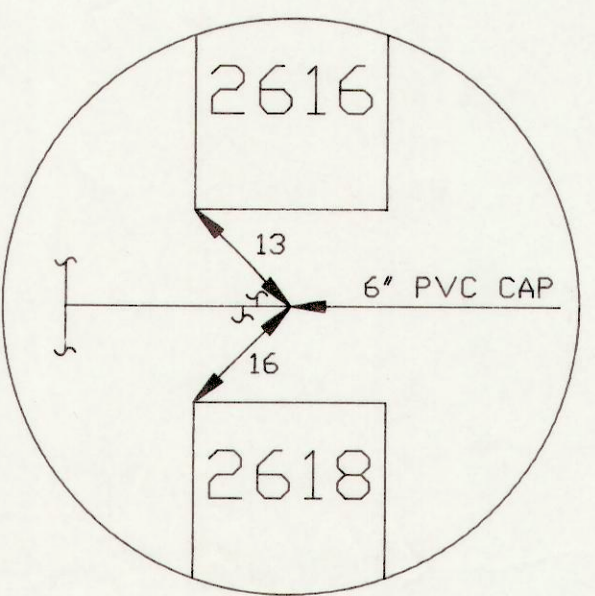
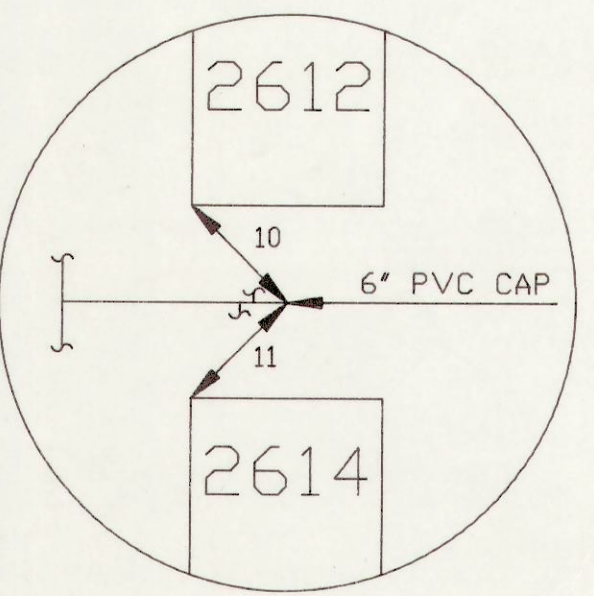
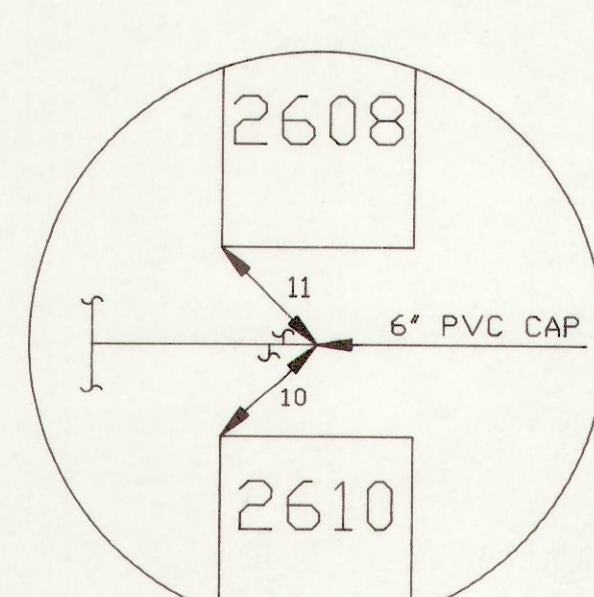
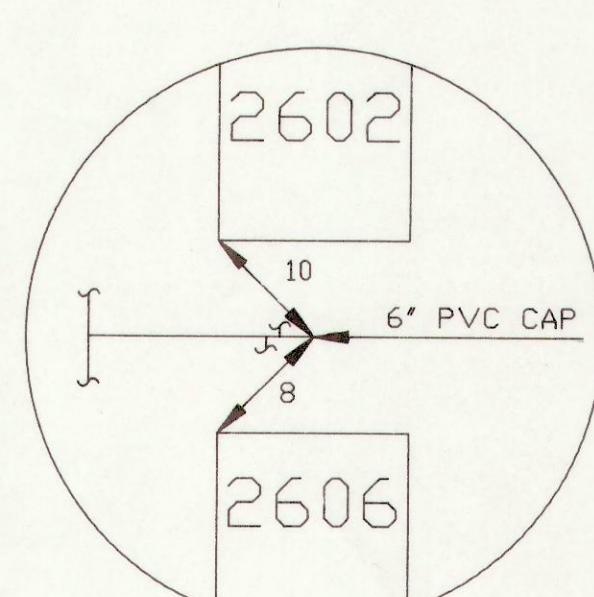
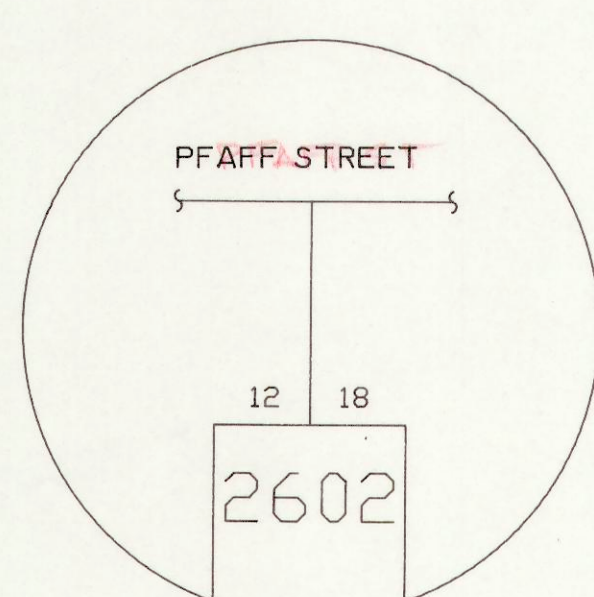
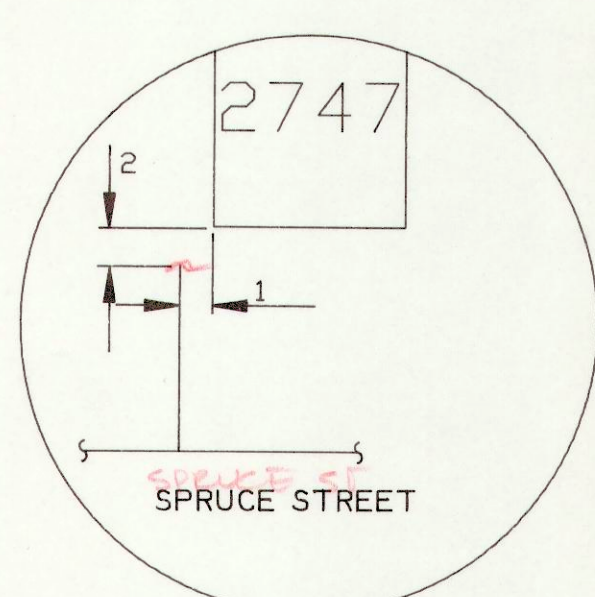
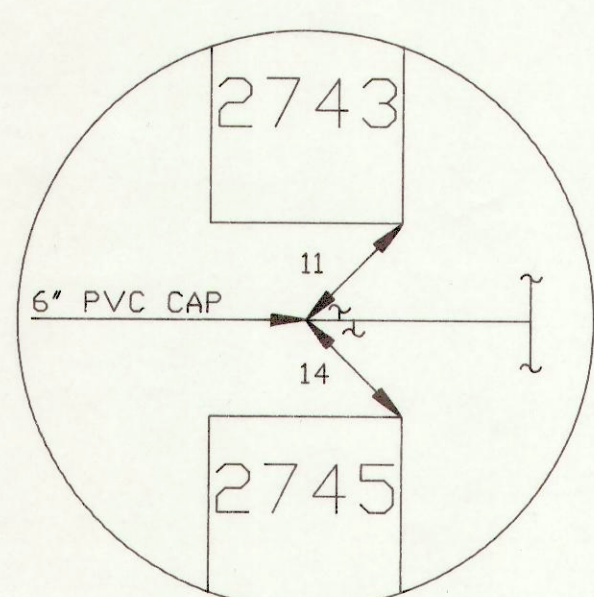
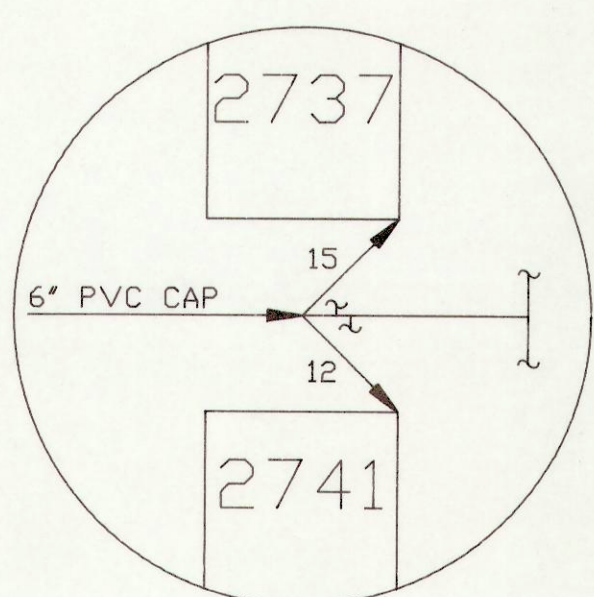
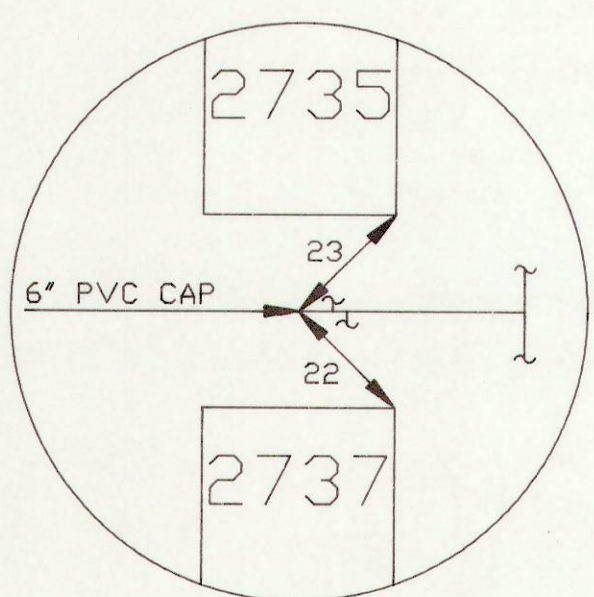
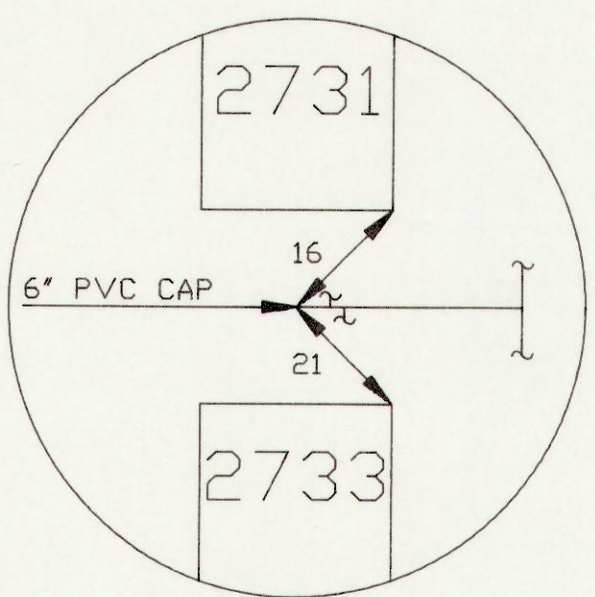
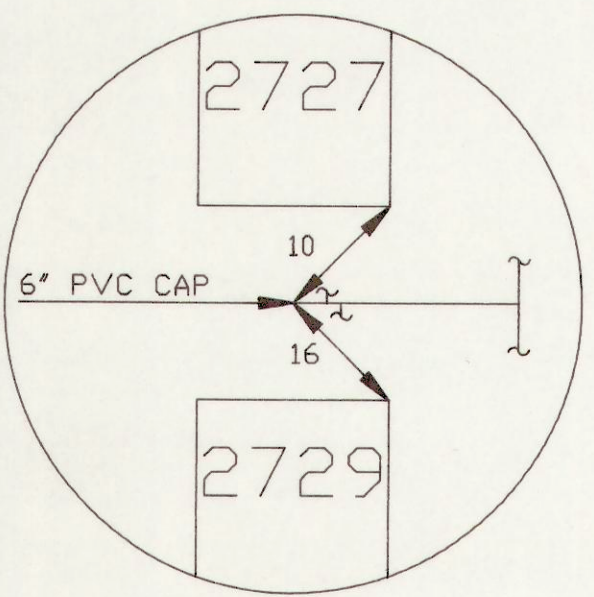
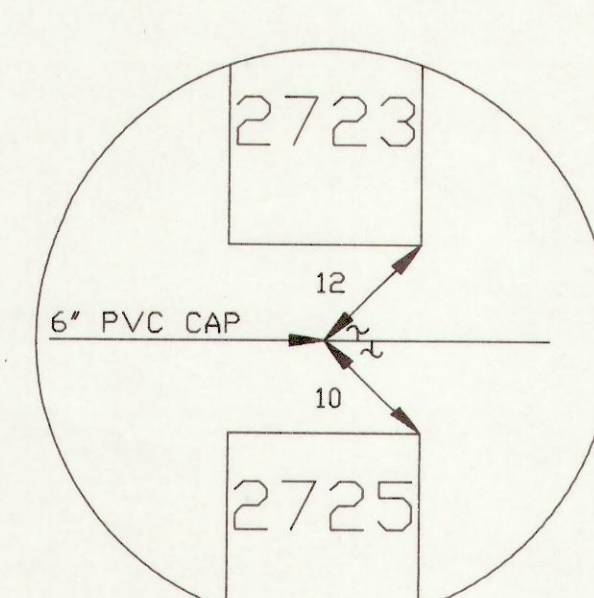
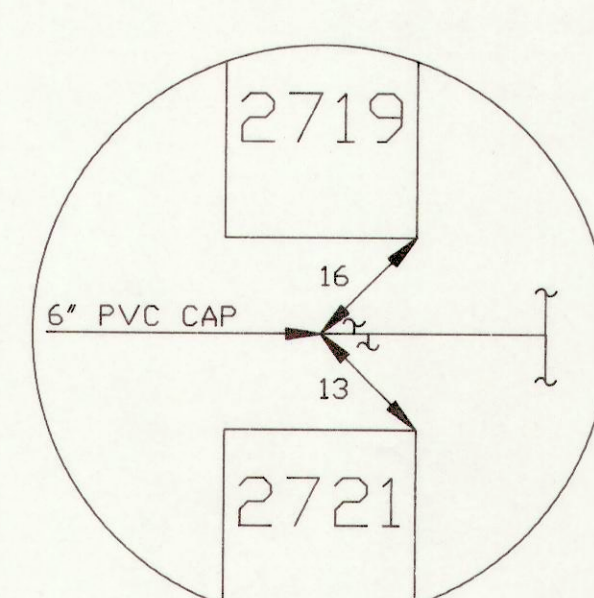
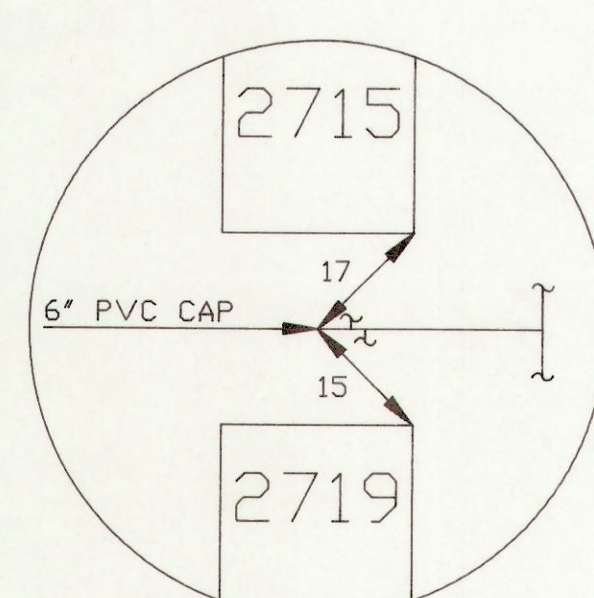
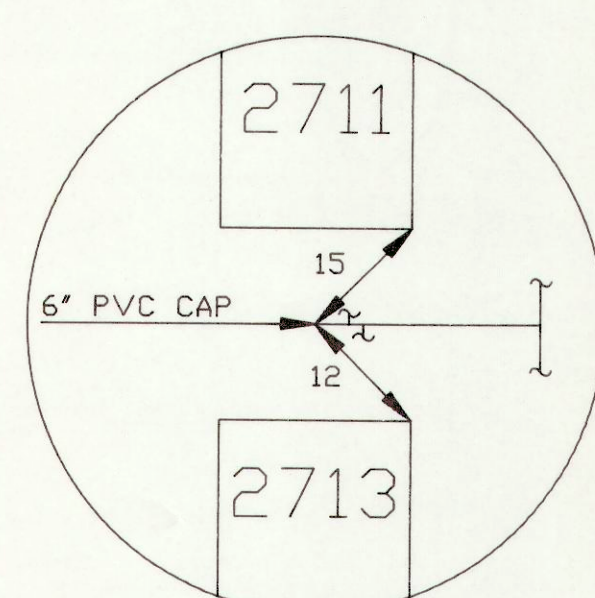
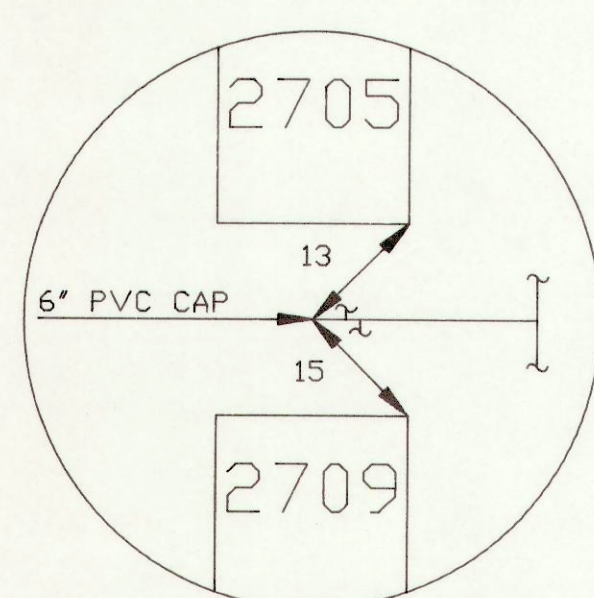
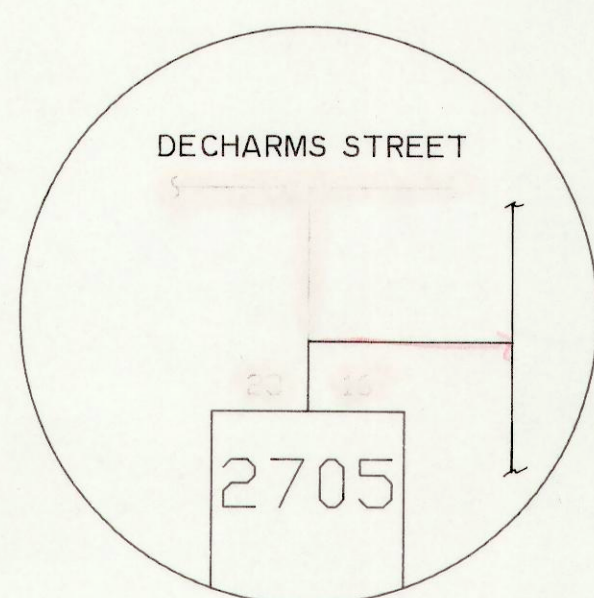
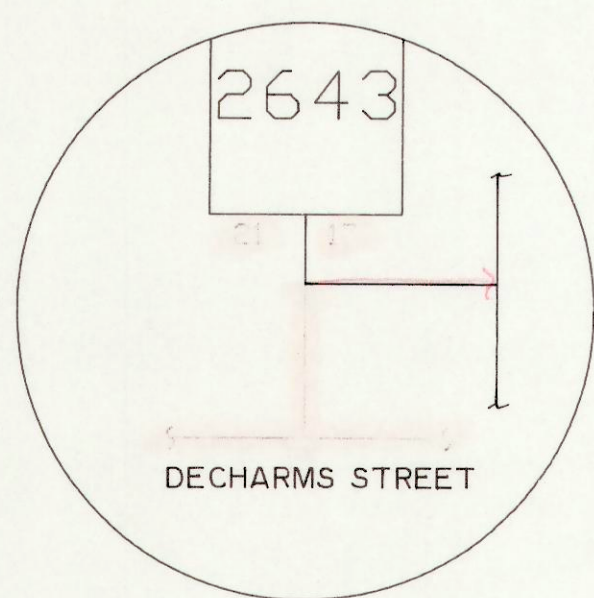
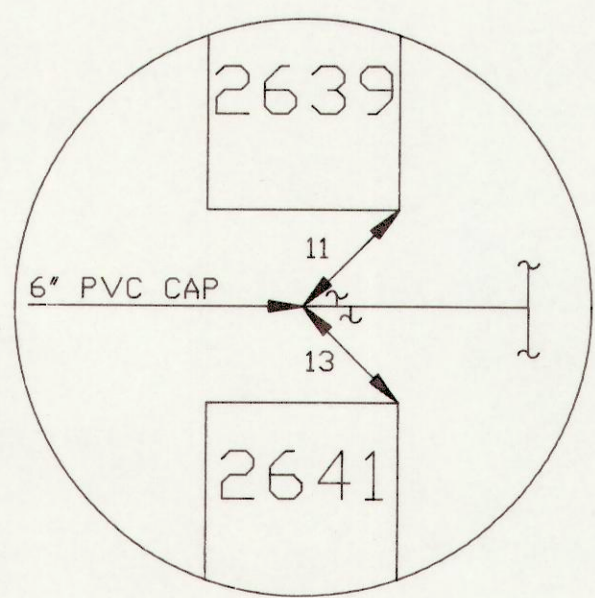
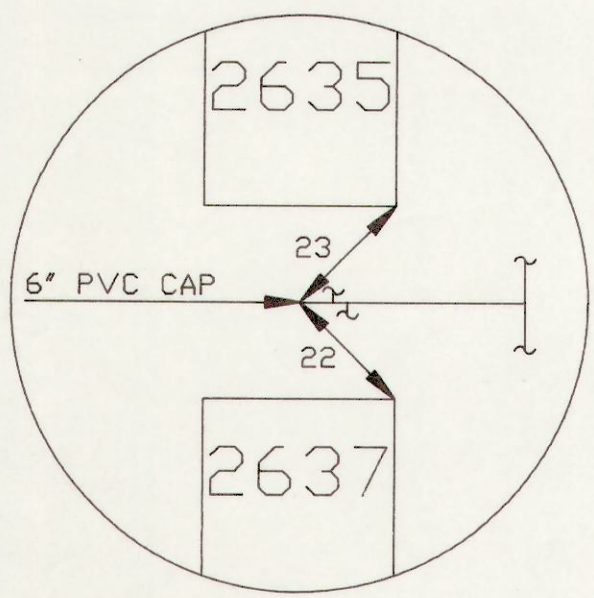
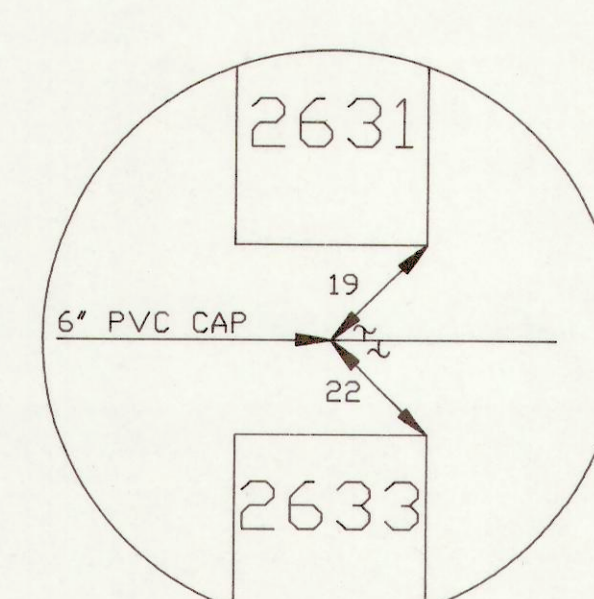
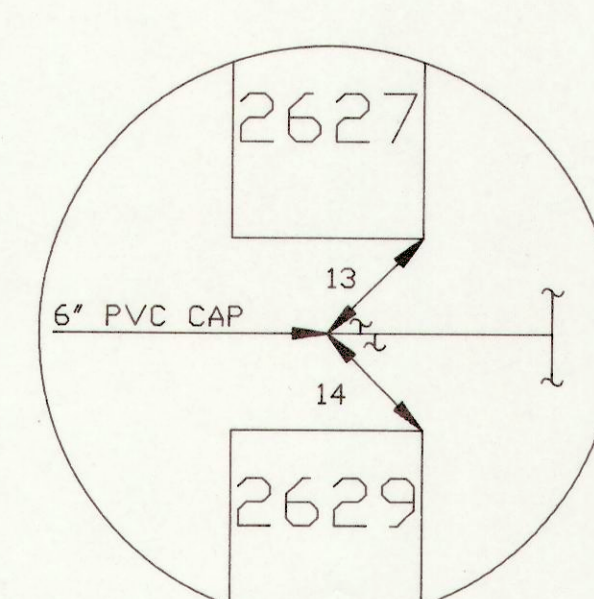
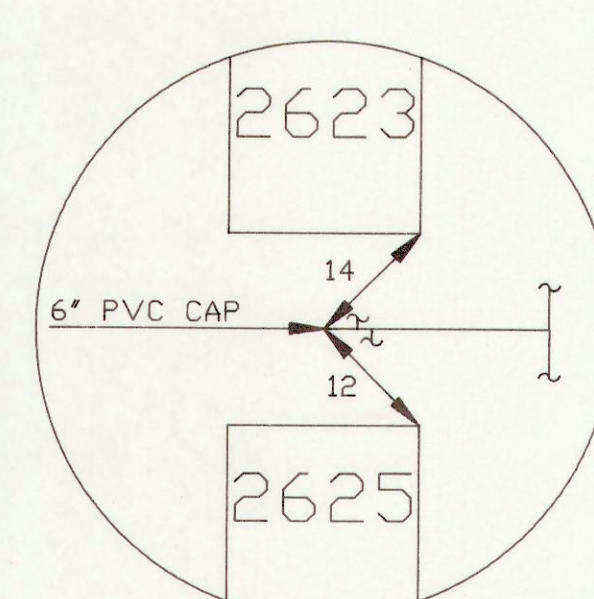
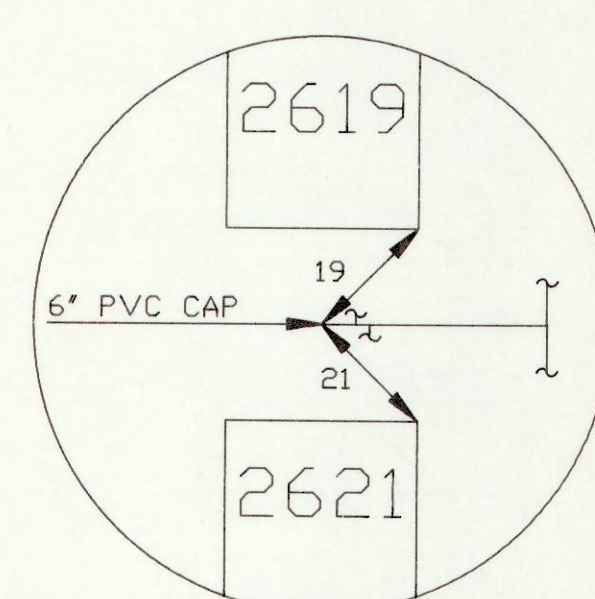
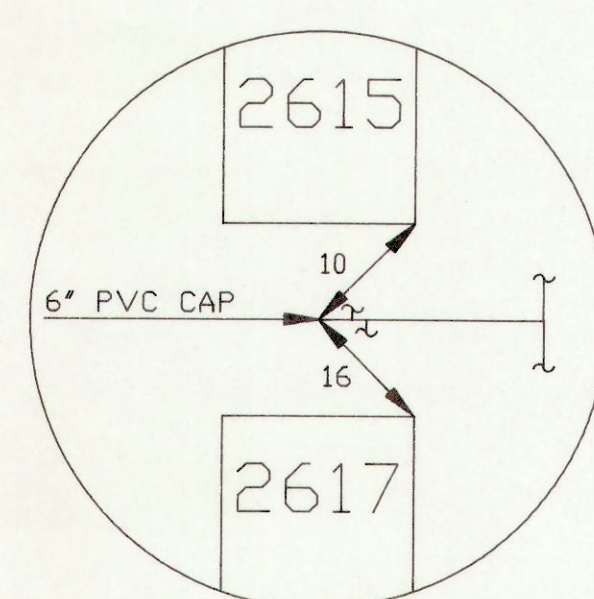
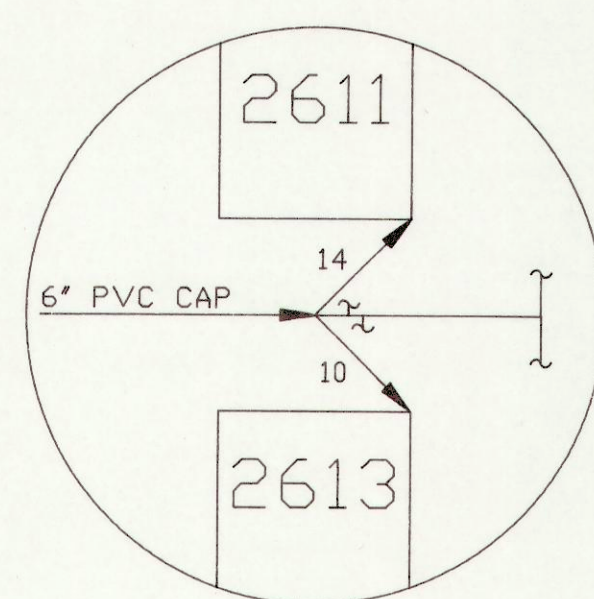
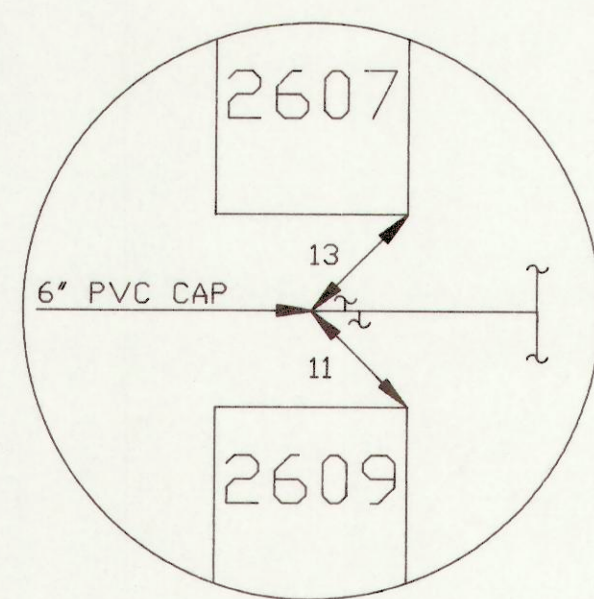
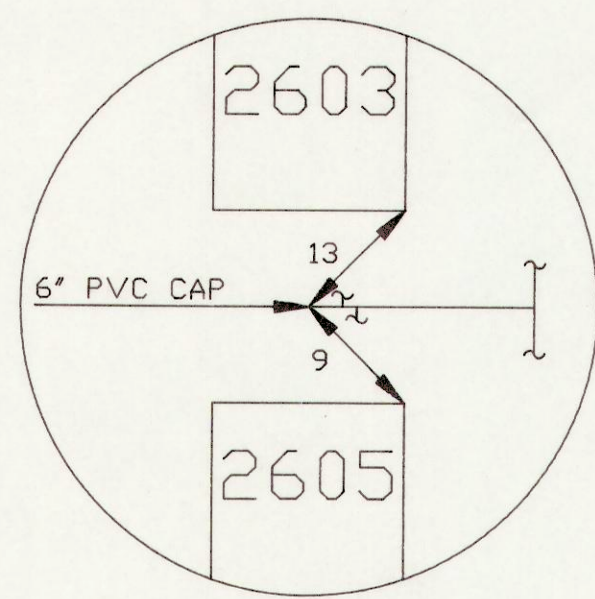
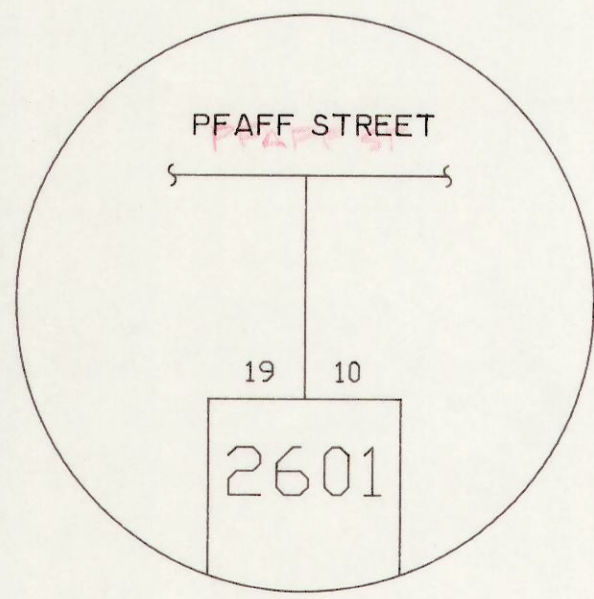


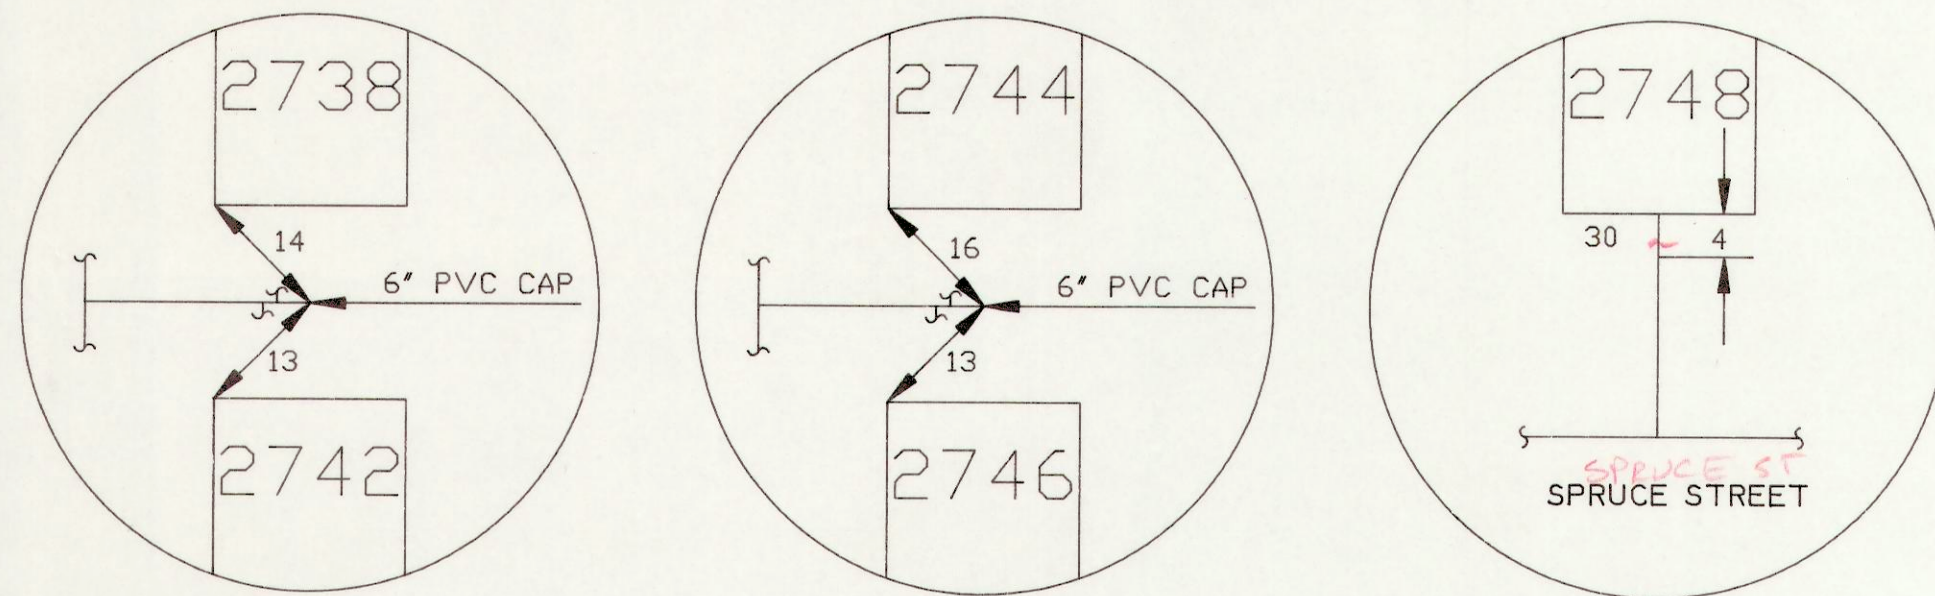


FORRESTAL AVENUE

KNOX AVENUE


KNOX AVENUE

KNOX AVENUE

KNOX AVENUE

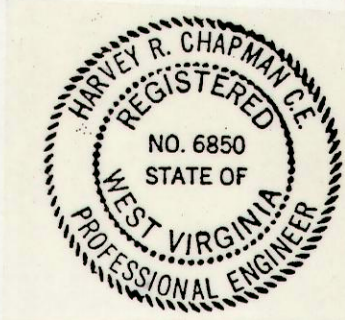

PROJECT INFORMATION
CITY OF ST. ALBANS
MUNICIPAL UTILITY COMMISSION
KANAWHA COUNTY, WEST VIRGINIA
WASTEWATER SYSTEM IMPROVEMENTS
EPA PROJECT NO. C-540618-01
CONTRACT NO. 2

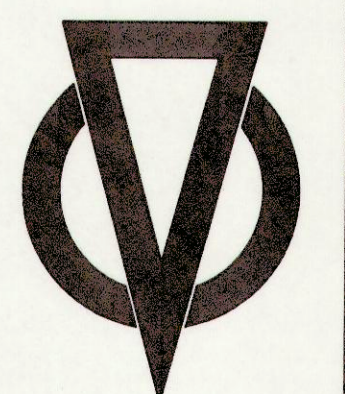

Chapman Technical Group

DRAWING TITLE	HOUSE LATERAL LOCATIONS
DRAWN	R. OSBORN
CHECKED	G. BELCHER
DATE	DECEMBER, 1991
SCALE	NONE
PROJECT NUMBER	87016
DRAWING NUMBER	13