


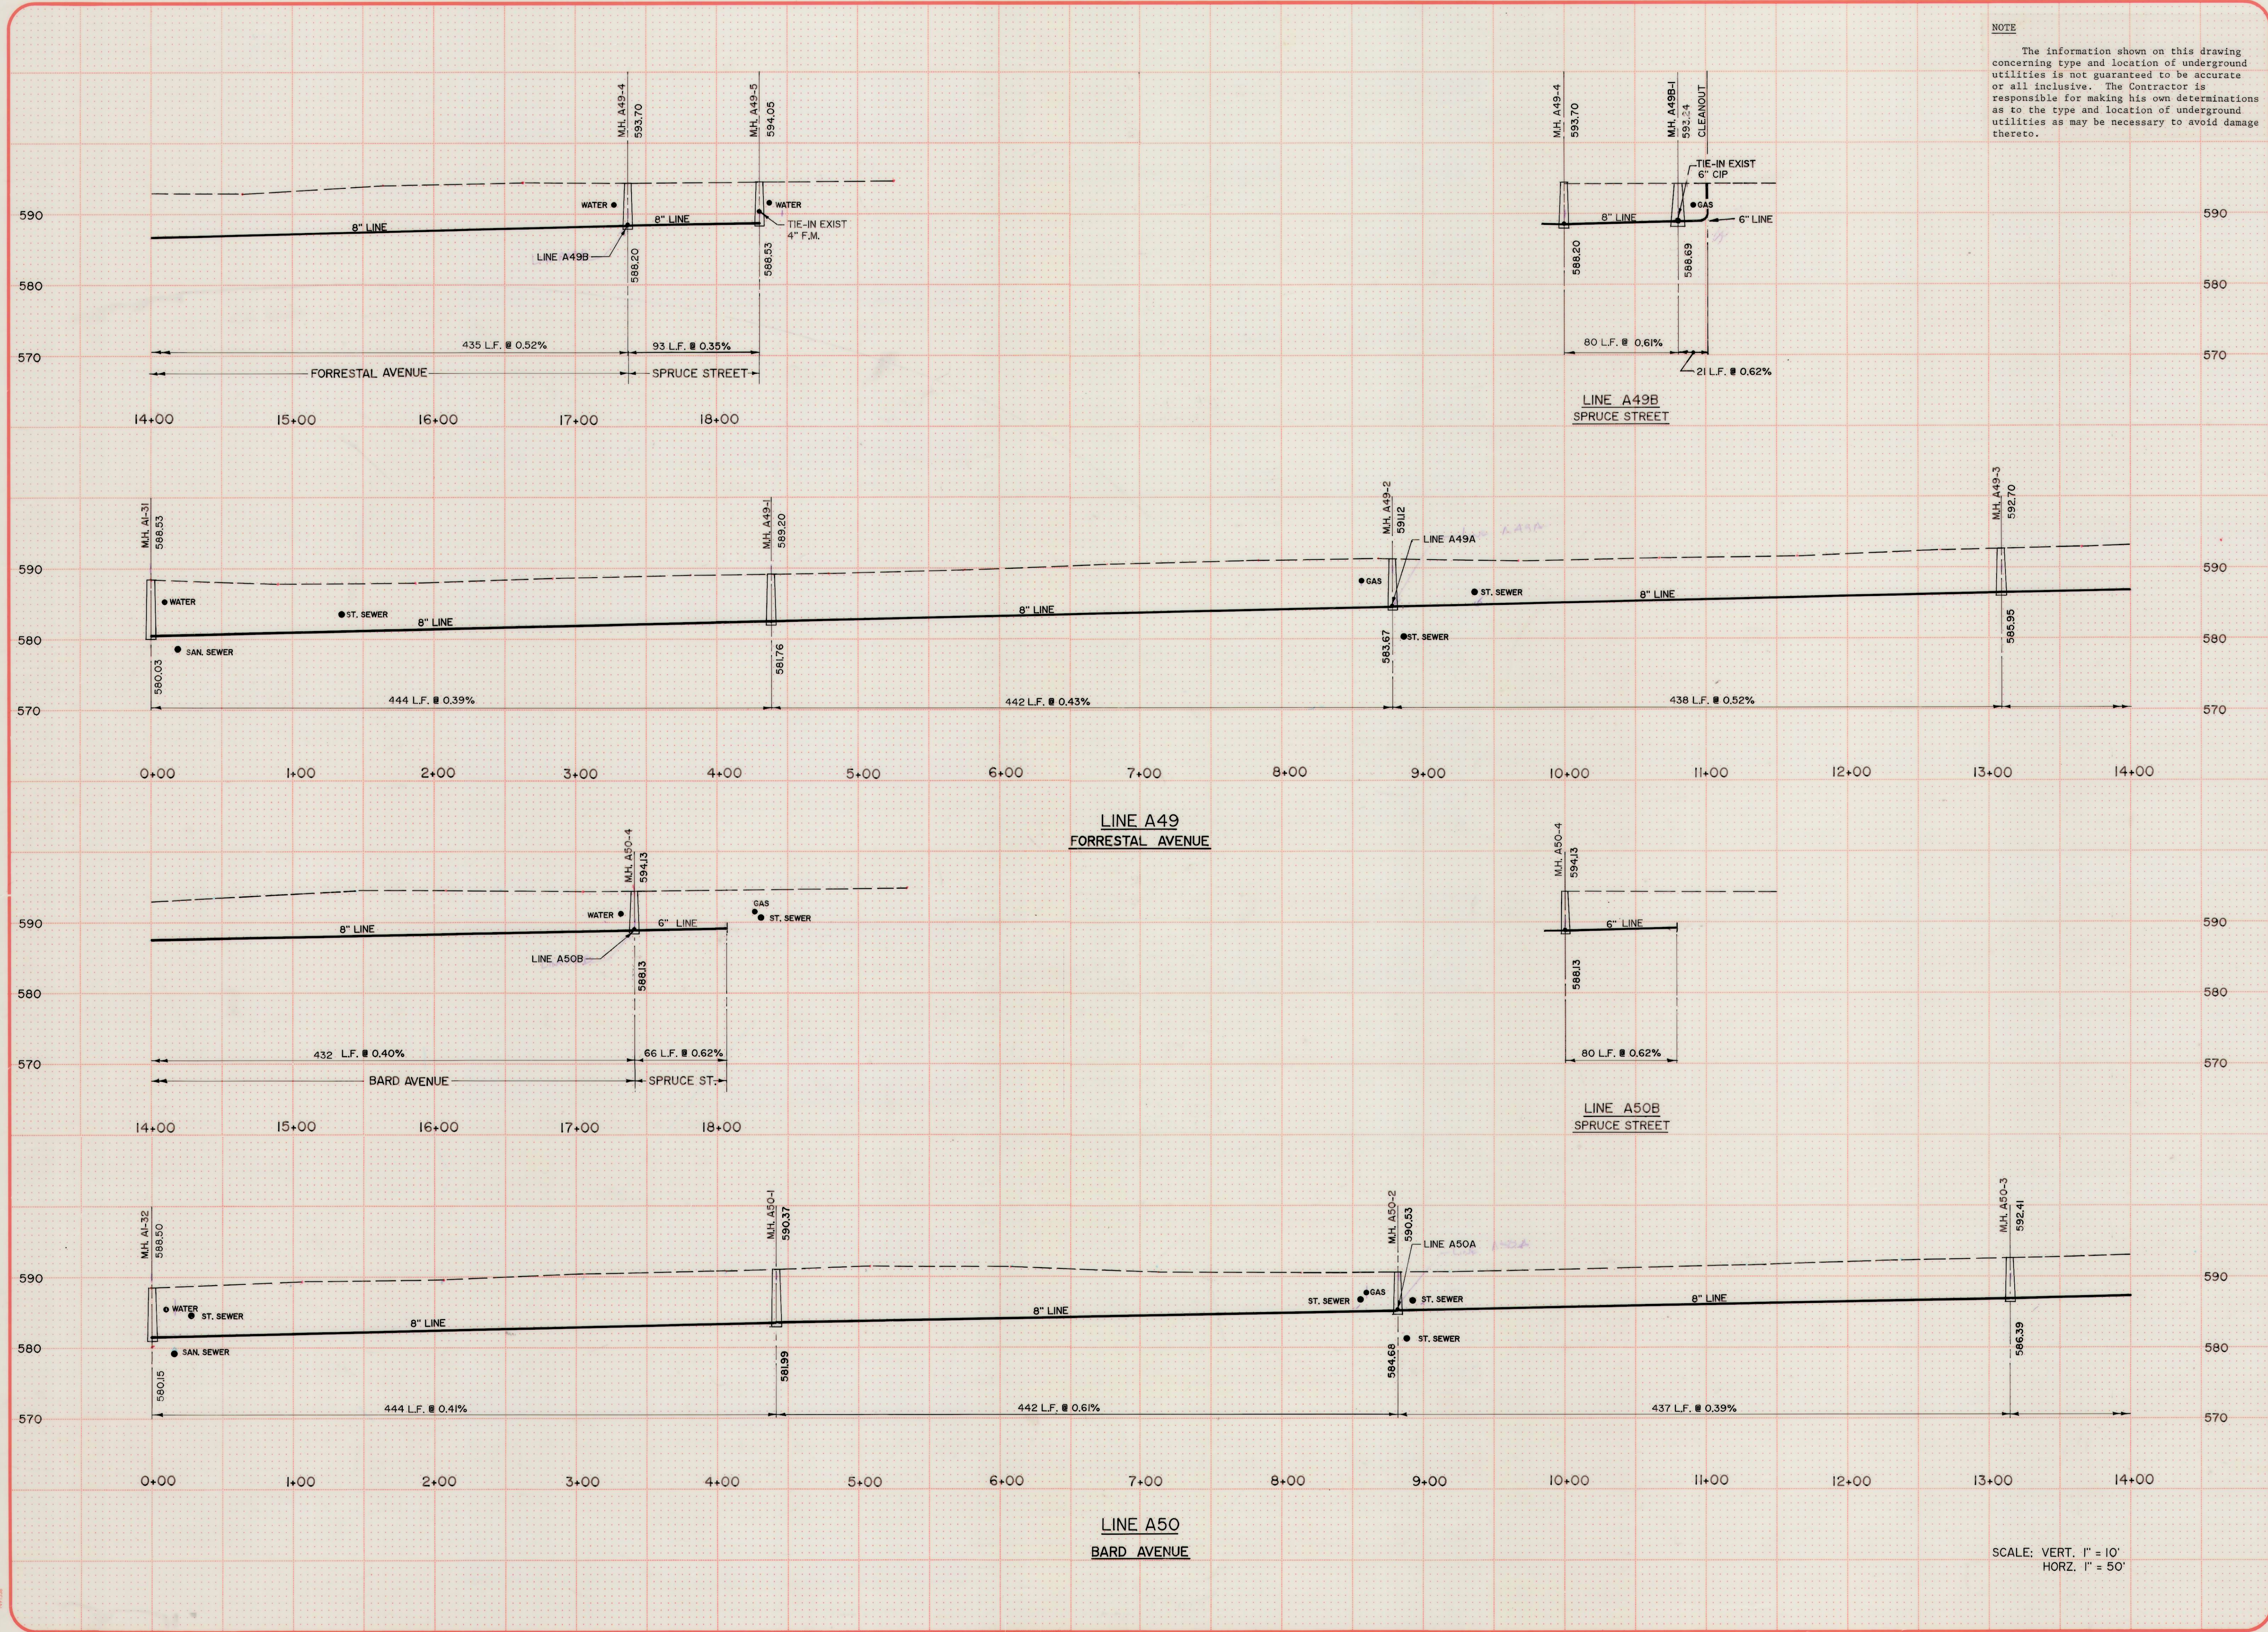

NOTE
The information shown on this drawing concerning type and location of underground utilities is not guaranteed to be accurate or all inclusive. The Contractor is responsible for making his own determinations as to the type and location of underground utilities as may be necessary to avoid damage thereto.

PROJECT INFORMATION
CITY of ST. ALBANS
MUNICIPAL UTILITY COMMISSION
KANAWHA COUNTY, WEST VIRGINIA
WASTEWATER SYSTEM IMPROVEMENTS
EPA PROJECT No. C-540618-01
CONTRACT No. 2


Chapman Technical Group

DRAWING TITLE
PROFILE
LINES A49, A49A @ B, A50, A50A @ B
FORRESTAL AVENUE
BARD AVENUE

DRAWN
R. OSBORNE
G. BELCHER
DATE
AUGUST, 1989
AS SHOWN
PROJECT NUMBER
87016
DRAWING NUMBER
4

SCALE: VERT. 1" = 10'
HORZ. 1" = 50'