


NIEI

1-1

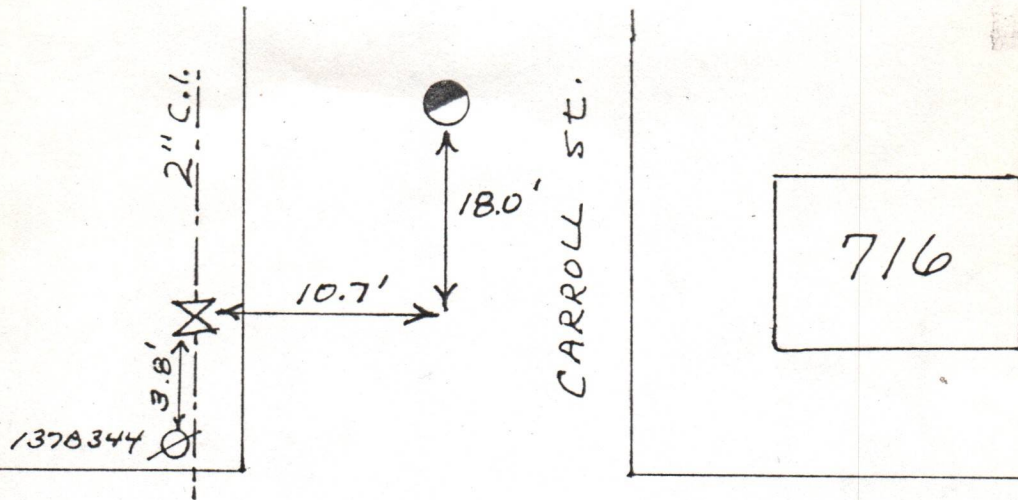

KANAWHA TERRACE