
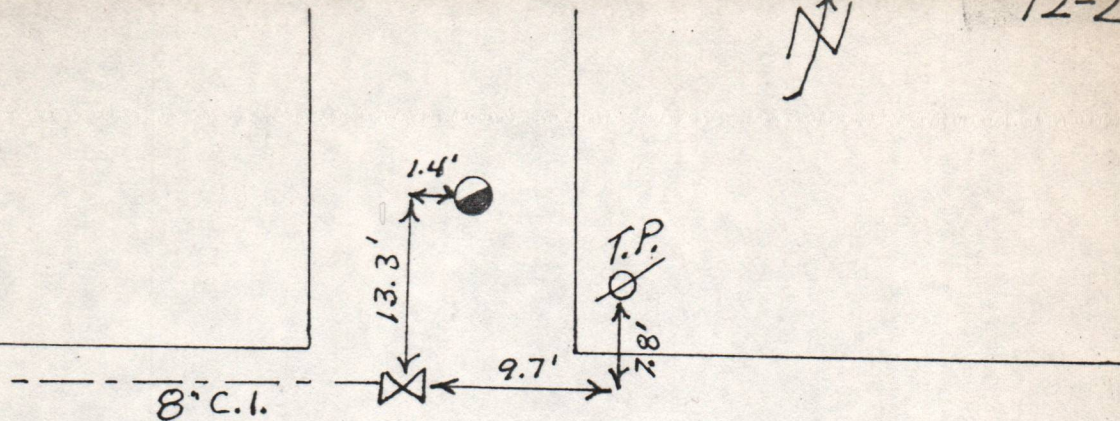


NIEI

12-2

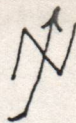

KANAWHA TERRACE

VINE St.