


NIEI

16-1

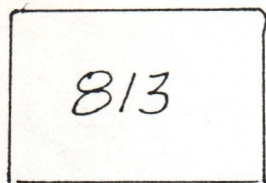


D.W.

A dashed horizontal line labeled "D.W." (Drainage Way) located below the area labeled "813".

WALL

A curved arrow pointing to a series of small circles representing a wall.

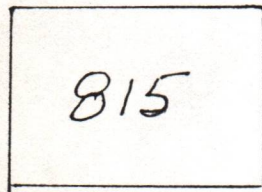


31.0'

A horizontal dimension line with arrows at both ends, labeled "31.0'".


30.0'

A vertical dimension line with arrows at both ends, labeled "30.0'".

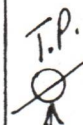

61.0'

A vertical dimension line with arrows at both ends, labeled "61.0'".

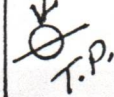

4.6'

A vertical dimension line with arrows at both ends, labeled "4.6'".



2 1/4" C.I.

A horizontal dimension line with arrows at both ends, labeled "2 1/4" C.I." (2 and a quarter inch Cast Iron).