


NIEI

2-1



KANAWHA TERRACE

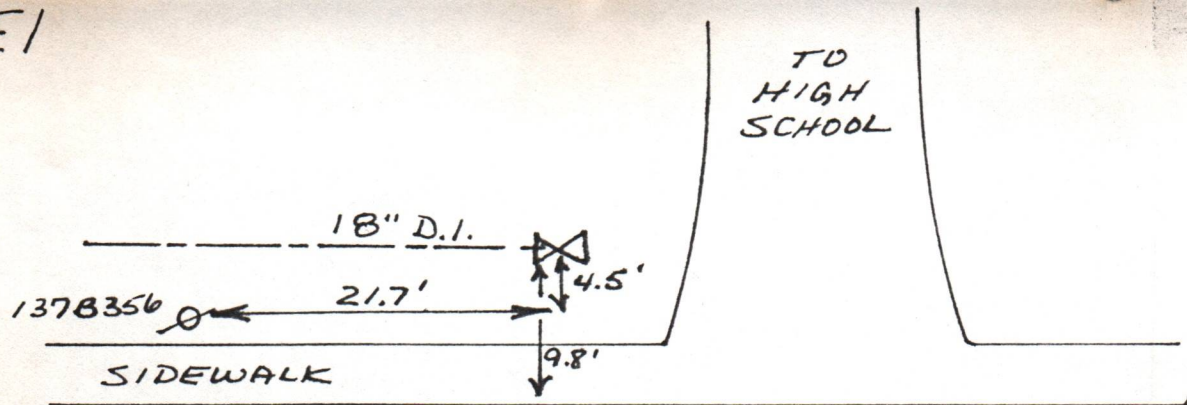