


NIEI



OBSERVATORY DRIVE

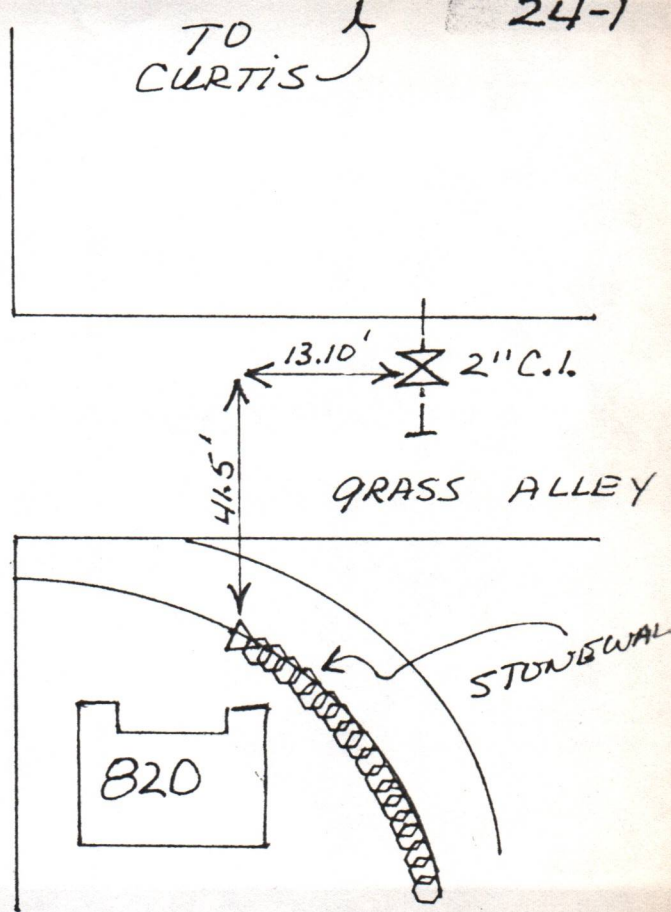

24-1