


NIE1

7-1

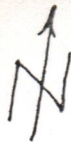

KANAWHA

TERRACE



STONEWALL

32.7'

SO. CARROLL

1" CU. CURB STOP



2.0'

9.0' $\varnothing \frac{21}{60}$