

NIEI



9-1


High School

KANAWHA

TERRACE

GREEN BRIER

SIDEWALK

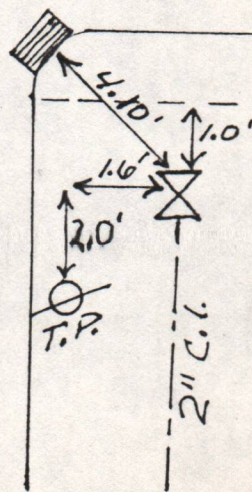

CHURCH