


15-4

NIE2

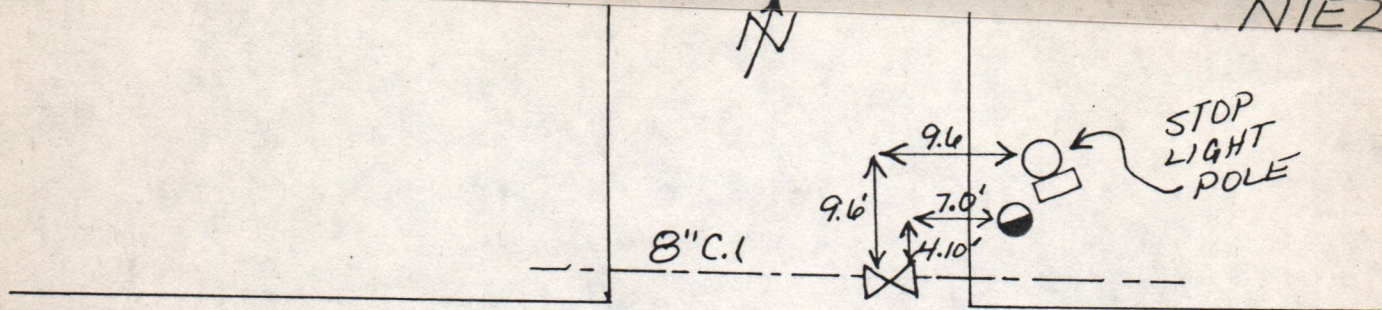

KANAWHA

ST.

TERRACE

WALNUT