


17-1

PARKING

6"0"

137D99

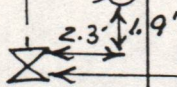

24.4'



Chestnut

NIEZ

IGA

KANAWHA

TERRACE

POPLAR
STREET

FIELD