


17-3

N1E2

PARKING

Chestnut

IGA

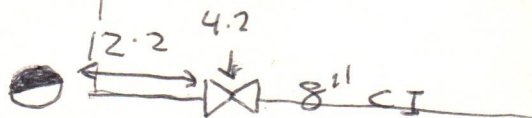

K - T

Poplar

FIELD