

3-1


FIRST
CHURCH
OF GOD
HIGHLAWN

T.P.



SZ.

37.7'

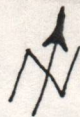

N1E2

ALLEY

2" C.I.



2.10'

10.4'

14.5'

GAS
COMPANY

WALNUT