

3-2

FIRST
CHURCH
OF GOD
HIGHLAWN

T.P.
O

38.5'

ALLEY

Walnut St.

11'


2"

2" C.I.

11.5'

13.8'

GAS
CO.

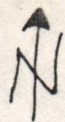

N1E2