


ALLEY



2" C.I.

CHESTNUT

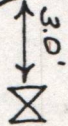

21.8'



T.P.