
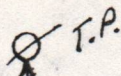
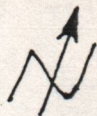


NIE3

21-1

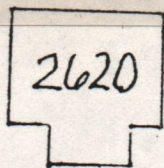

7.8'

6.7'

KANAWHA

TERRACE

27.0'

SWEET ACRES

4" C.I.

