



NIE3

137D196

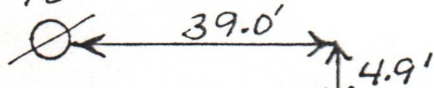

23-1

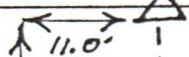

29.3'



6" C.I.

HUGHES DRIVE

KANAWHA TERRACE