


NIE3

4-1

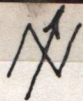


WILLOW STREET


WASHINGTON

AVE.

8" C.L. 2" GAL. 8" C.L.

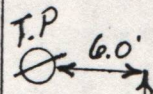

45.0'

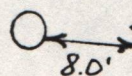

10.5'

8" C.L.