


14-1

NIE4

SPRUCE STREET

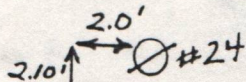

2" GAL.

MADISON AVE.

