


8-1



NIE4

SPRUCE

ALLEY

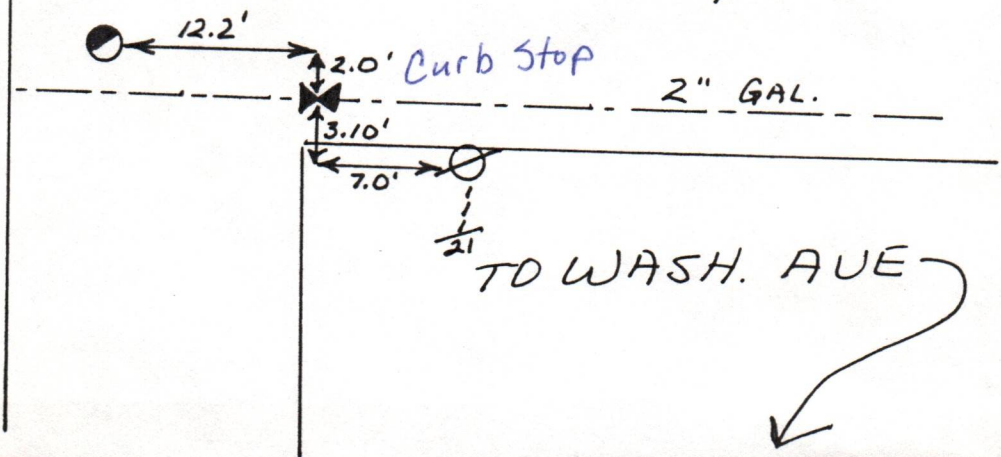

Curb Stop

2" GAL.

TO WASH. AVE