

8-3

N1E4



SPRUCE

WASHINGTON

AVENUE



49.7'


8" C.I.

8" C.I.



7.8'

36.4'

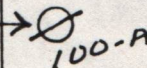

100-A