


NIWI

4-1

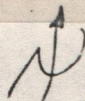

KANAWHA

Terrace

Cunningham Ln.

