


AD102

10-1

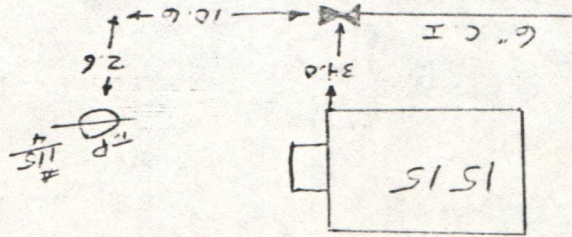

OAKLAND

Ave.

Stover

