


10 10-2

N1W2

STOVER

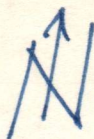

8" C.I.

OAKLAND

AVE

6" C.I.

6" C.I.

FEEDS
FIRE
HYDRANT

8" C.I.

1515