
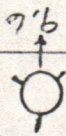
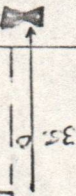



20102

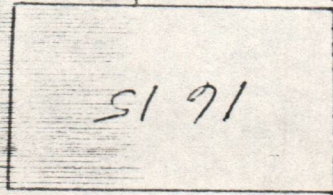

Ø

6" C.I.

OAKLAND AL

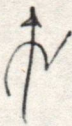

Baier st.

17-1